


69677

CERTIFICATE

Application No. 12-75636
Permit No.

T. 26S
R. 4W.
Sec 13
Lot 200
Glide 75'
Quad
(1987)

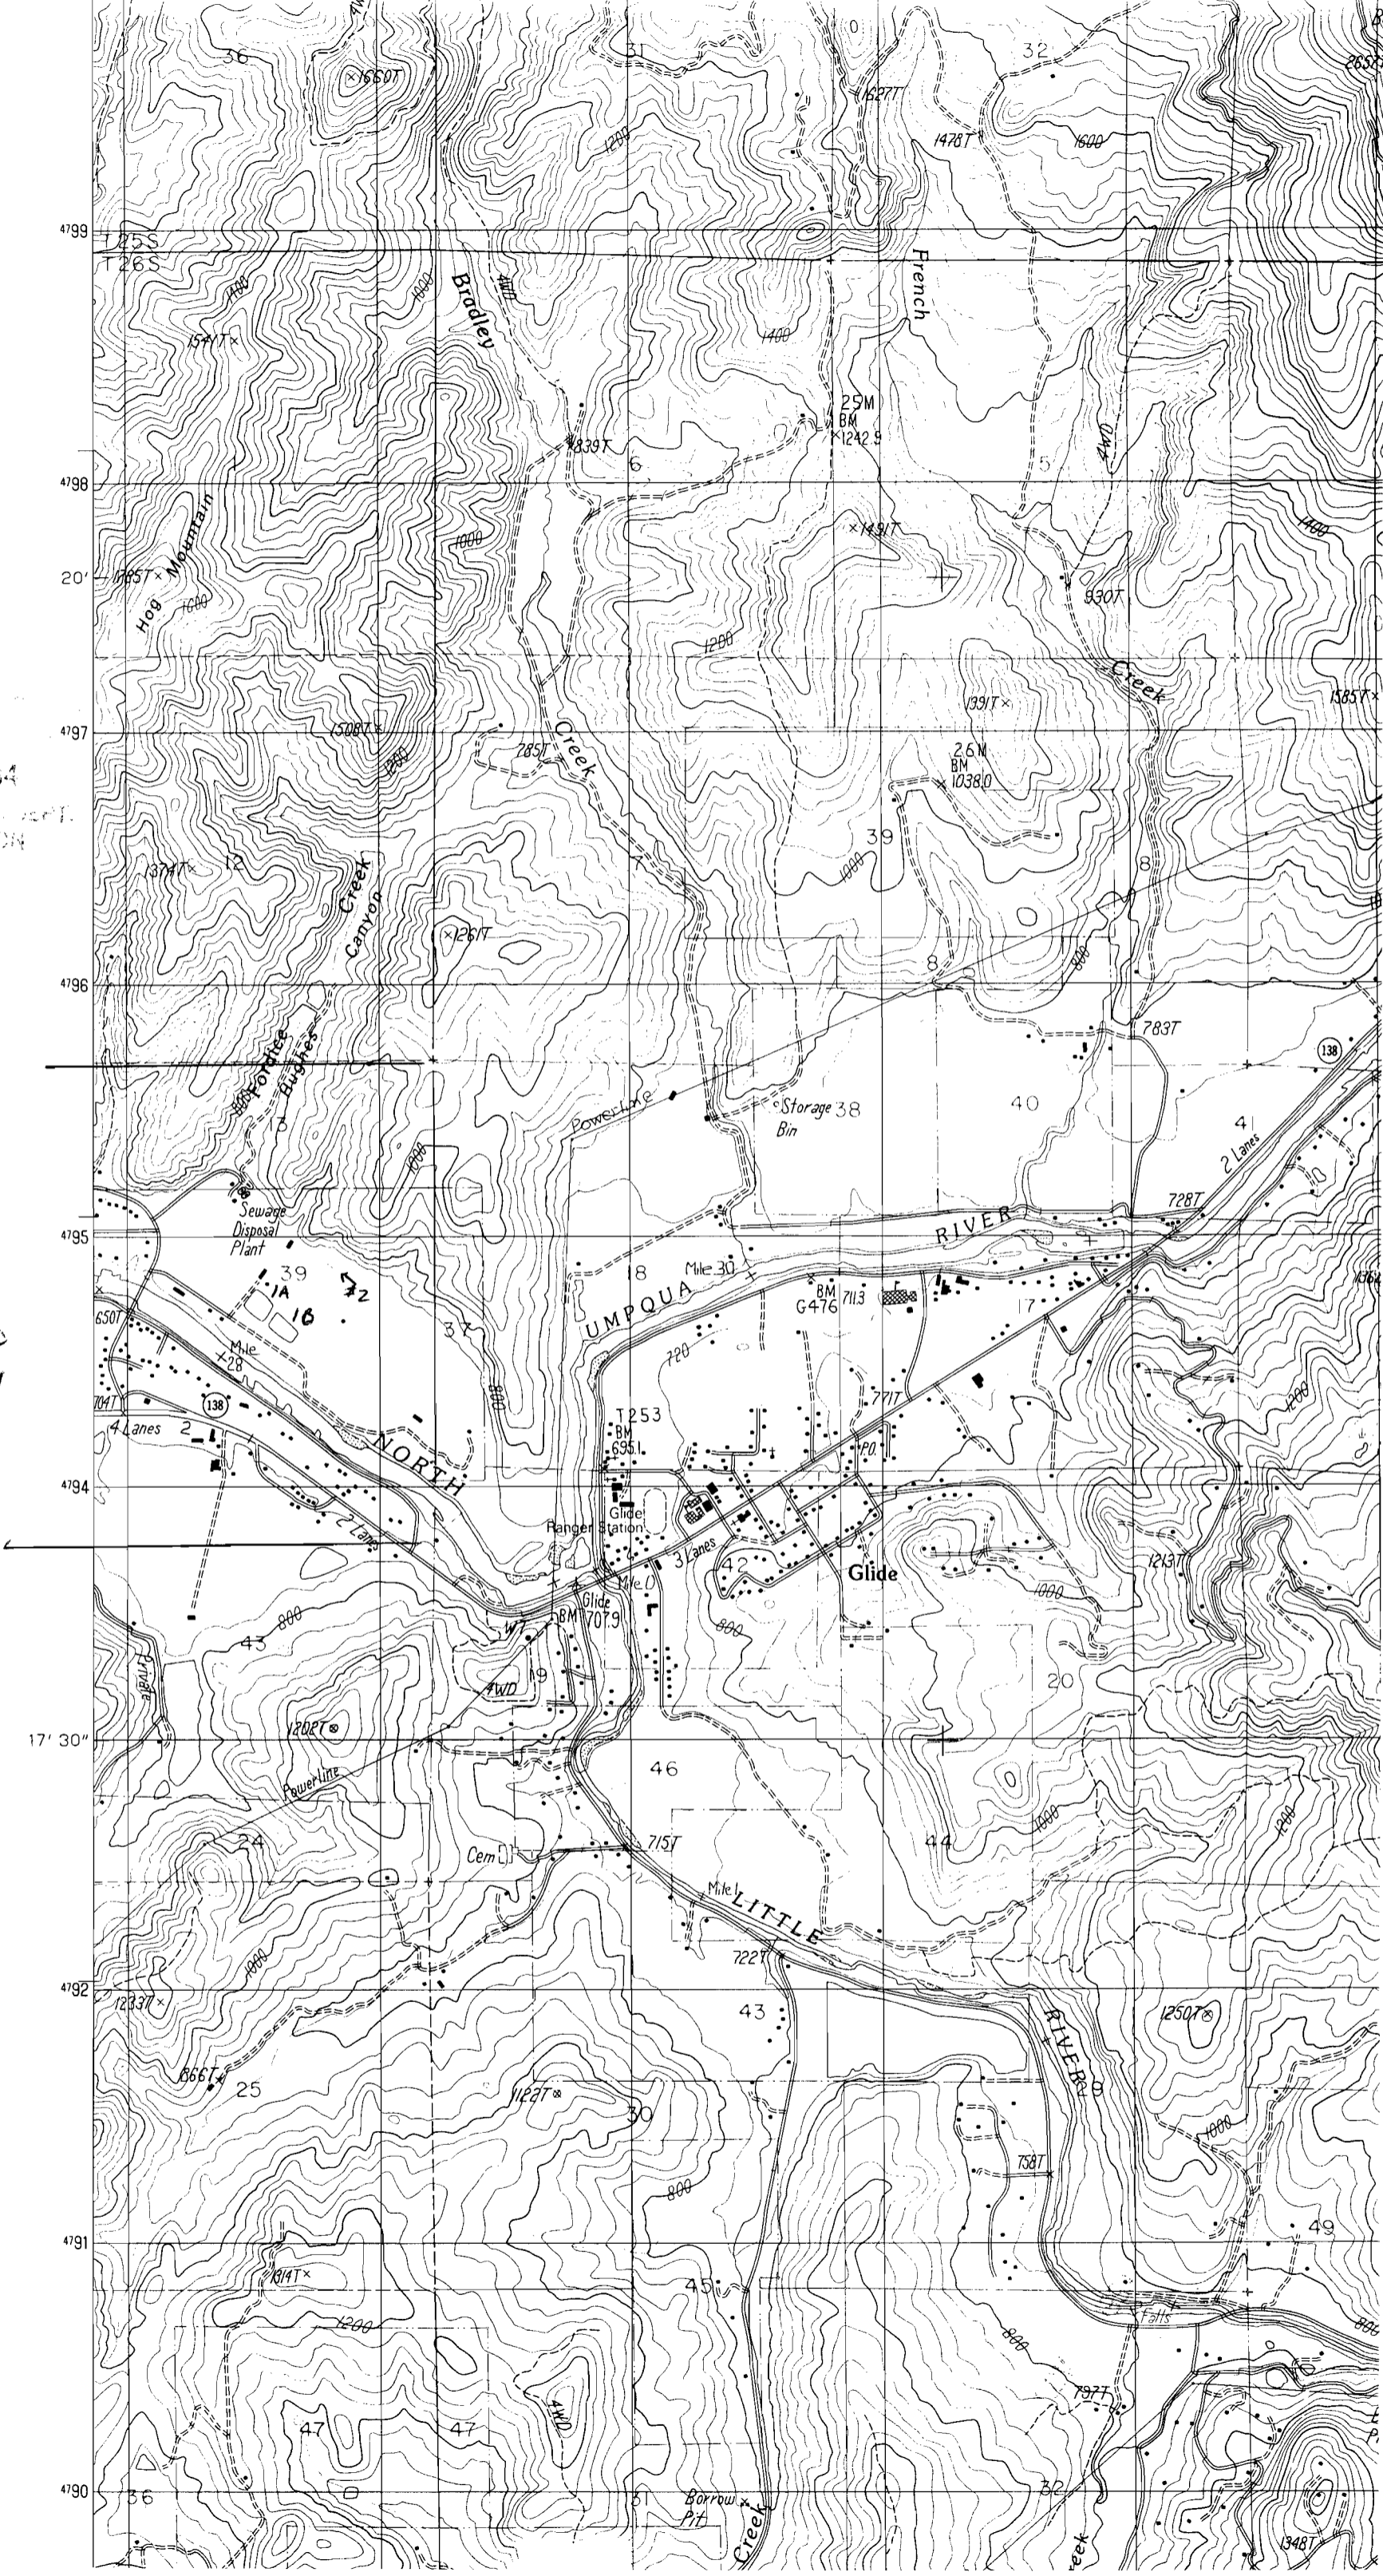

1984
1987