


Application No. R-75643

OTT's Mountains Quad

Permit No.

"CERTIFICATE NO.

C0684 6990 Edition

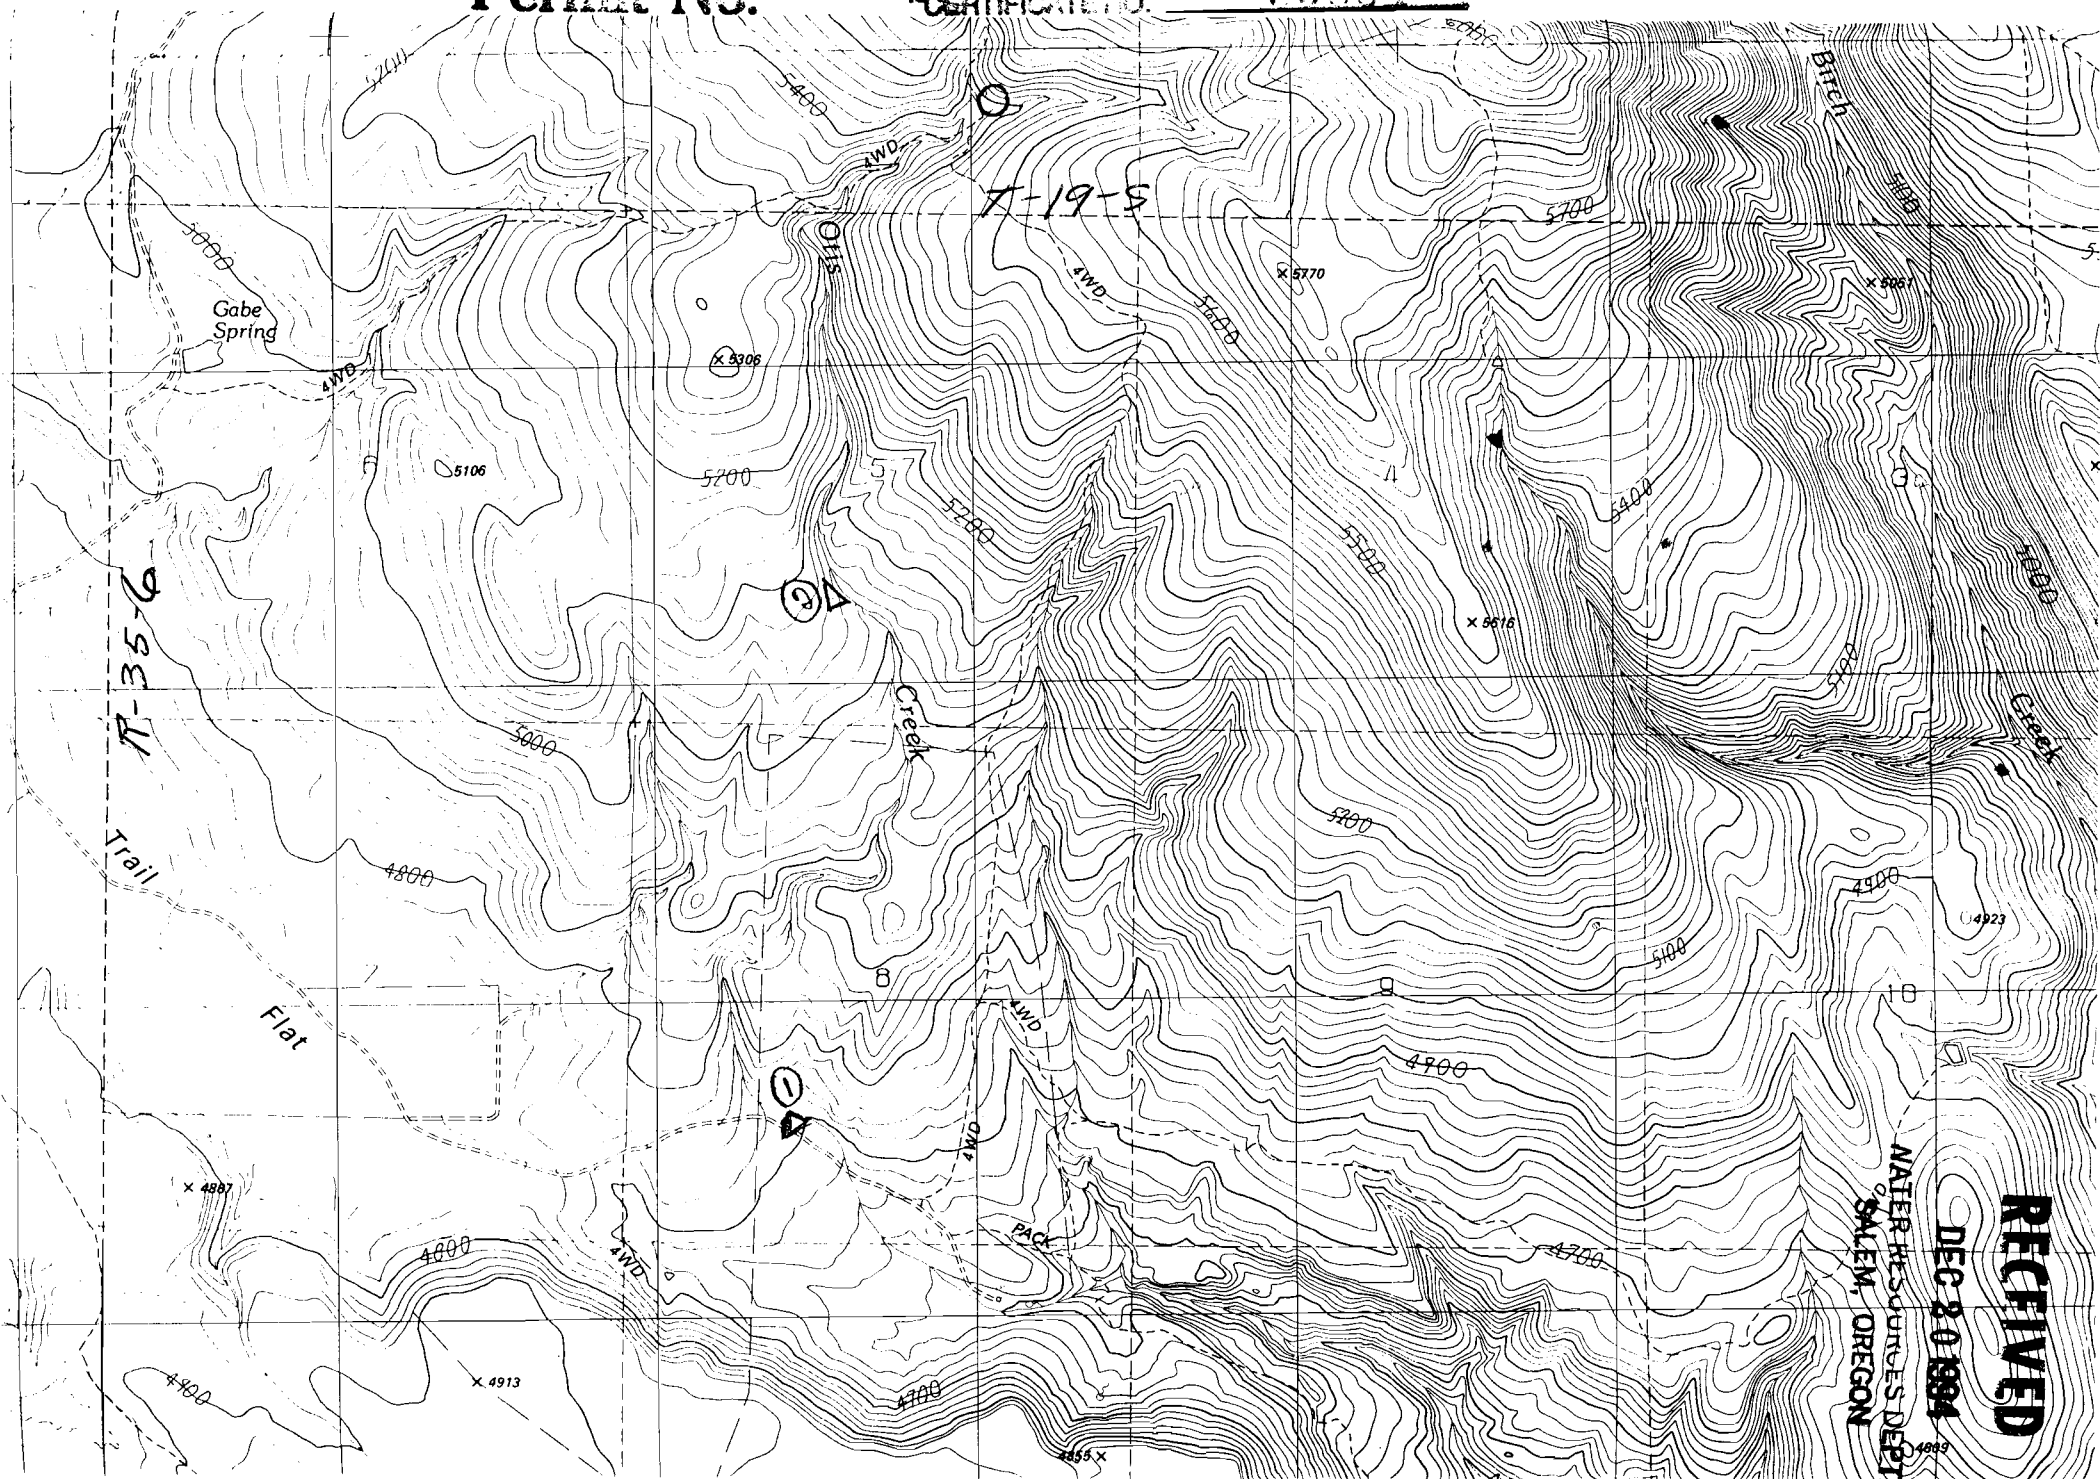

RECEIVED

DEC 20 1994

SALEM, OREGON