

RECEIVED


DEC 20 1994

WATER RESOURCES DEPT.
SALEM, OREGON

APPLICANT: DANIEL R. LANG

PAGE 4 of 10

60887

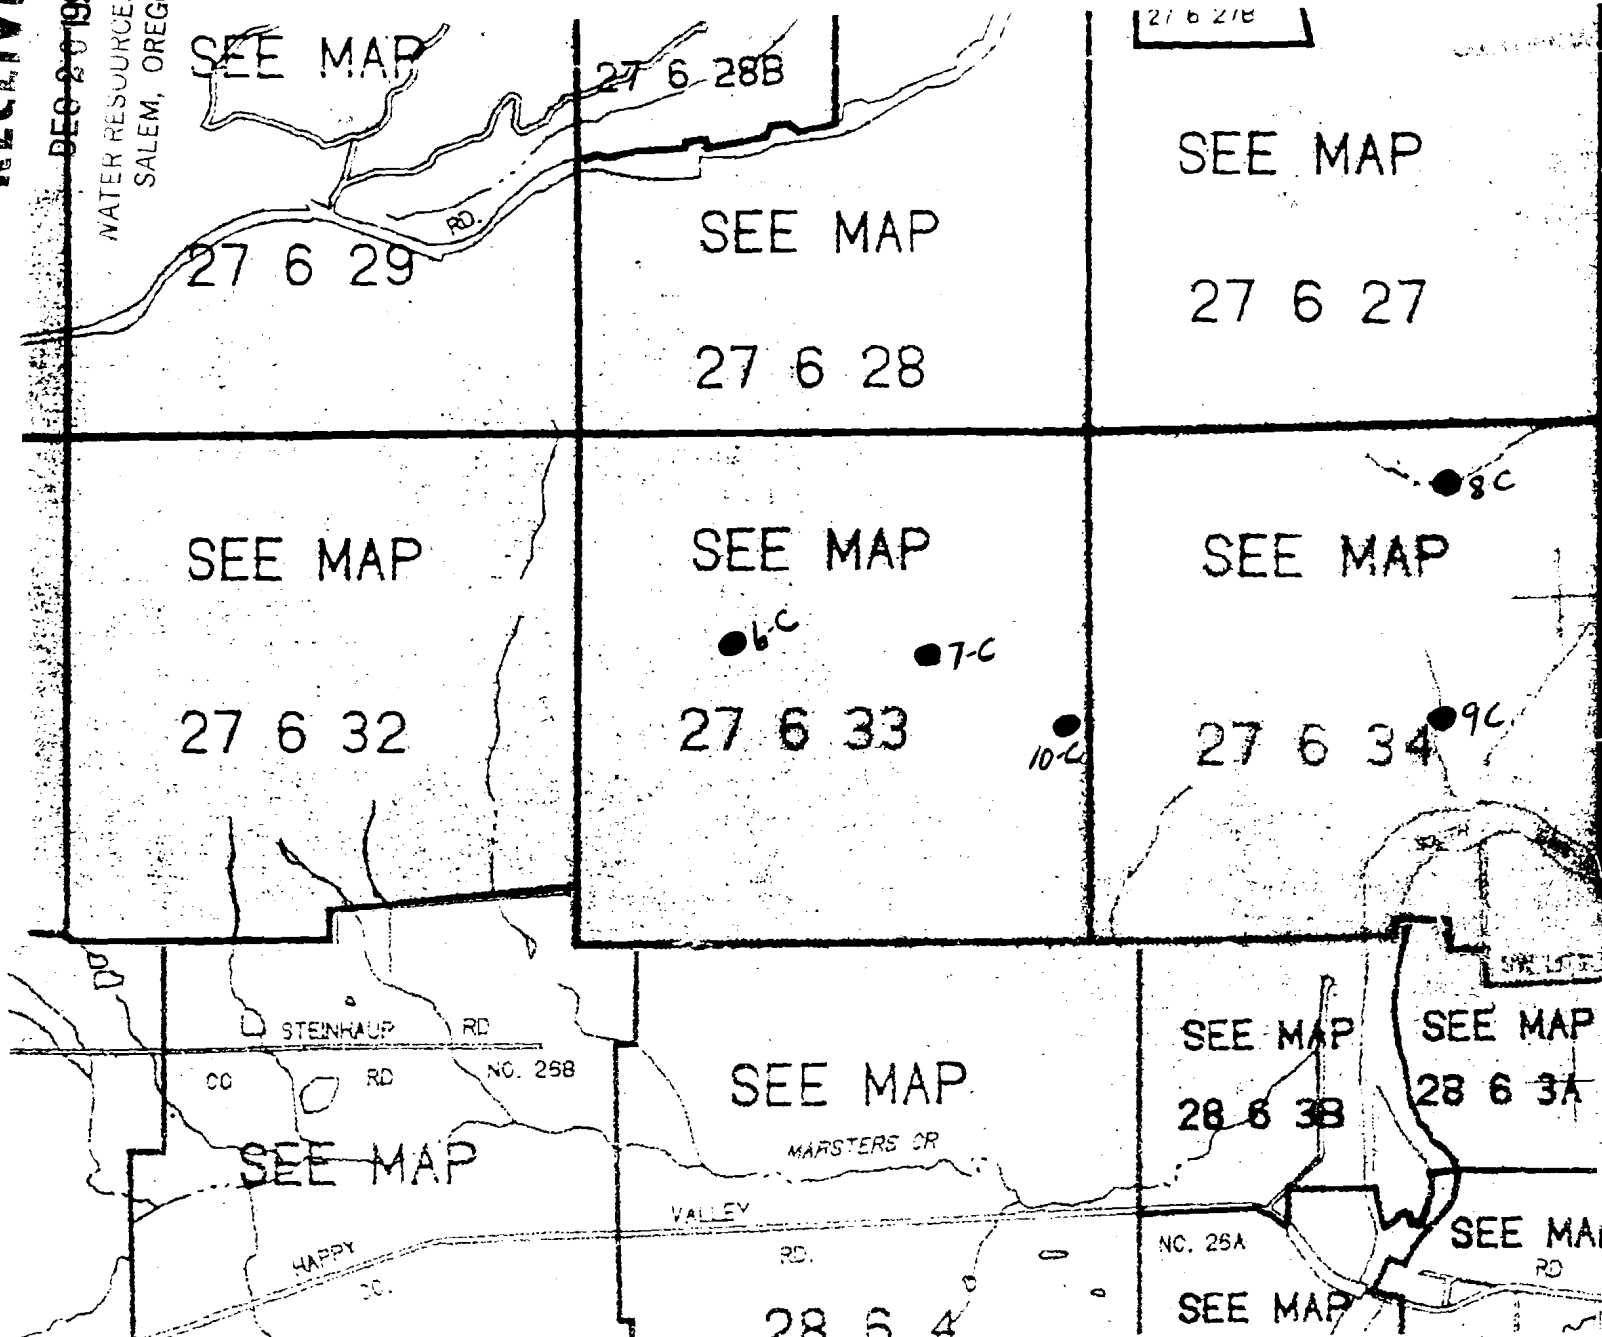

T.27S. R.6W. W.1
DOUGLAS COUNTY
1"=2000'

THIS MAP WAS PREPARED FOR
ASSESSMENT PURPOSE ONLY.

T.28S. R.6W.W.1
DOUGLAS COUNTY