


Application No. R-75648  
Permit No.

CASS99

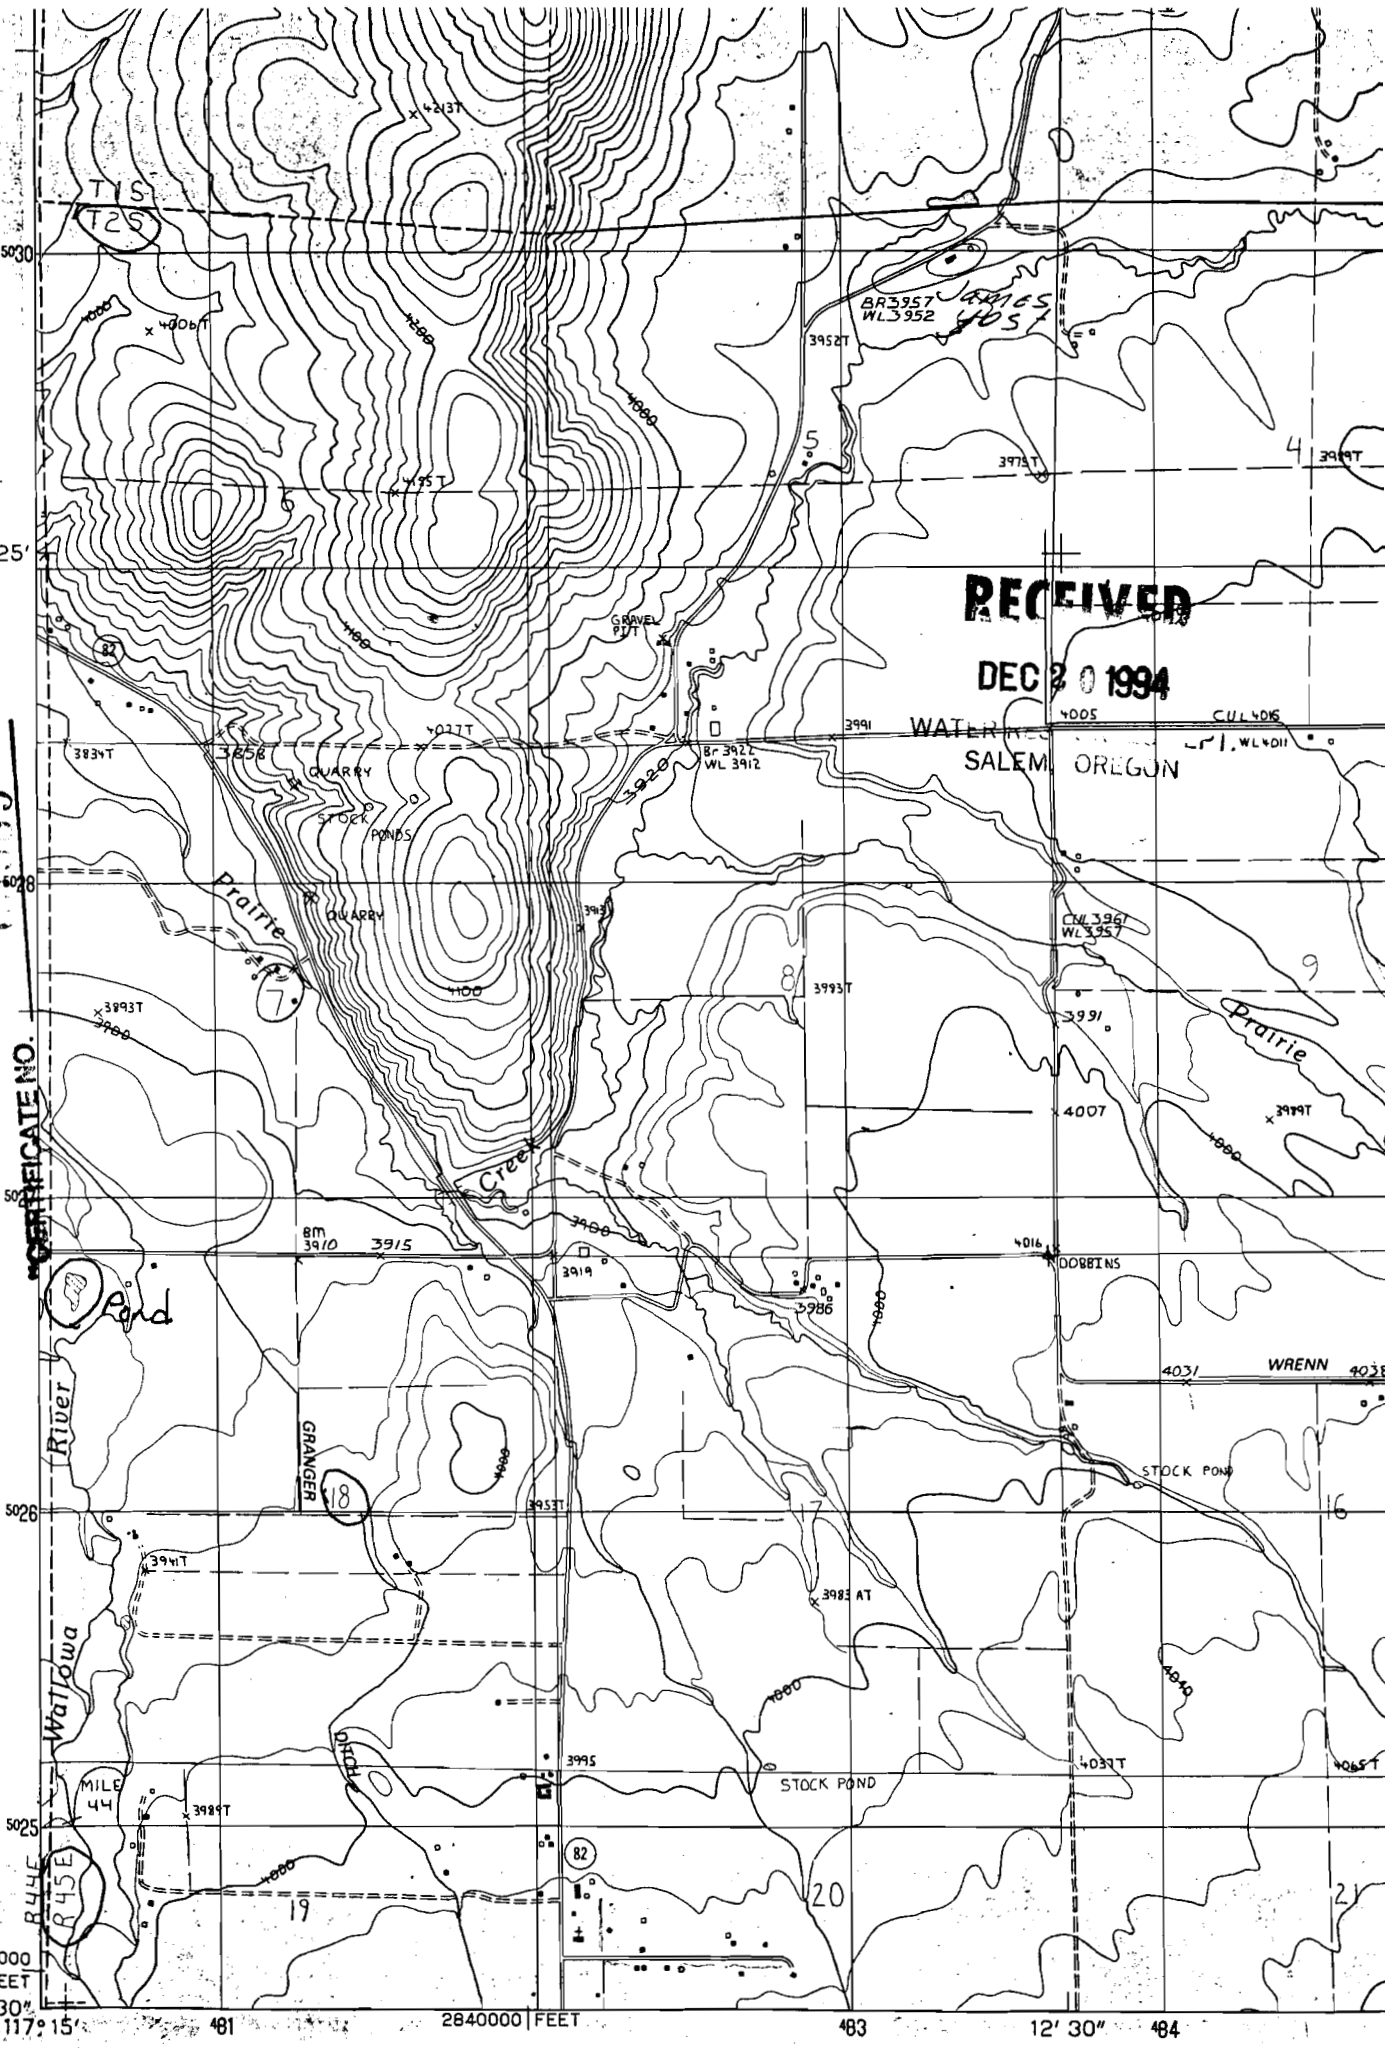

RECEIVED  
DEC 20 1994

WATER RESOURCES DIVISION  
SALEM, OREGON