


Application No. 275449
Permit No. 2030

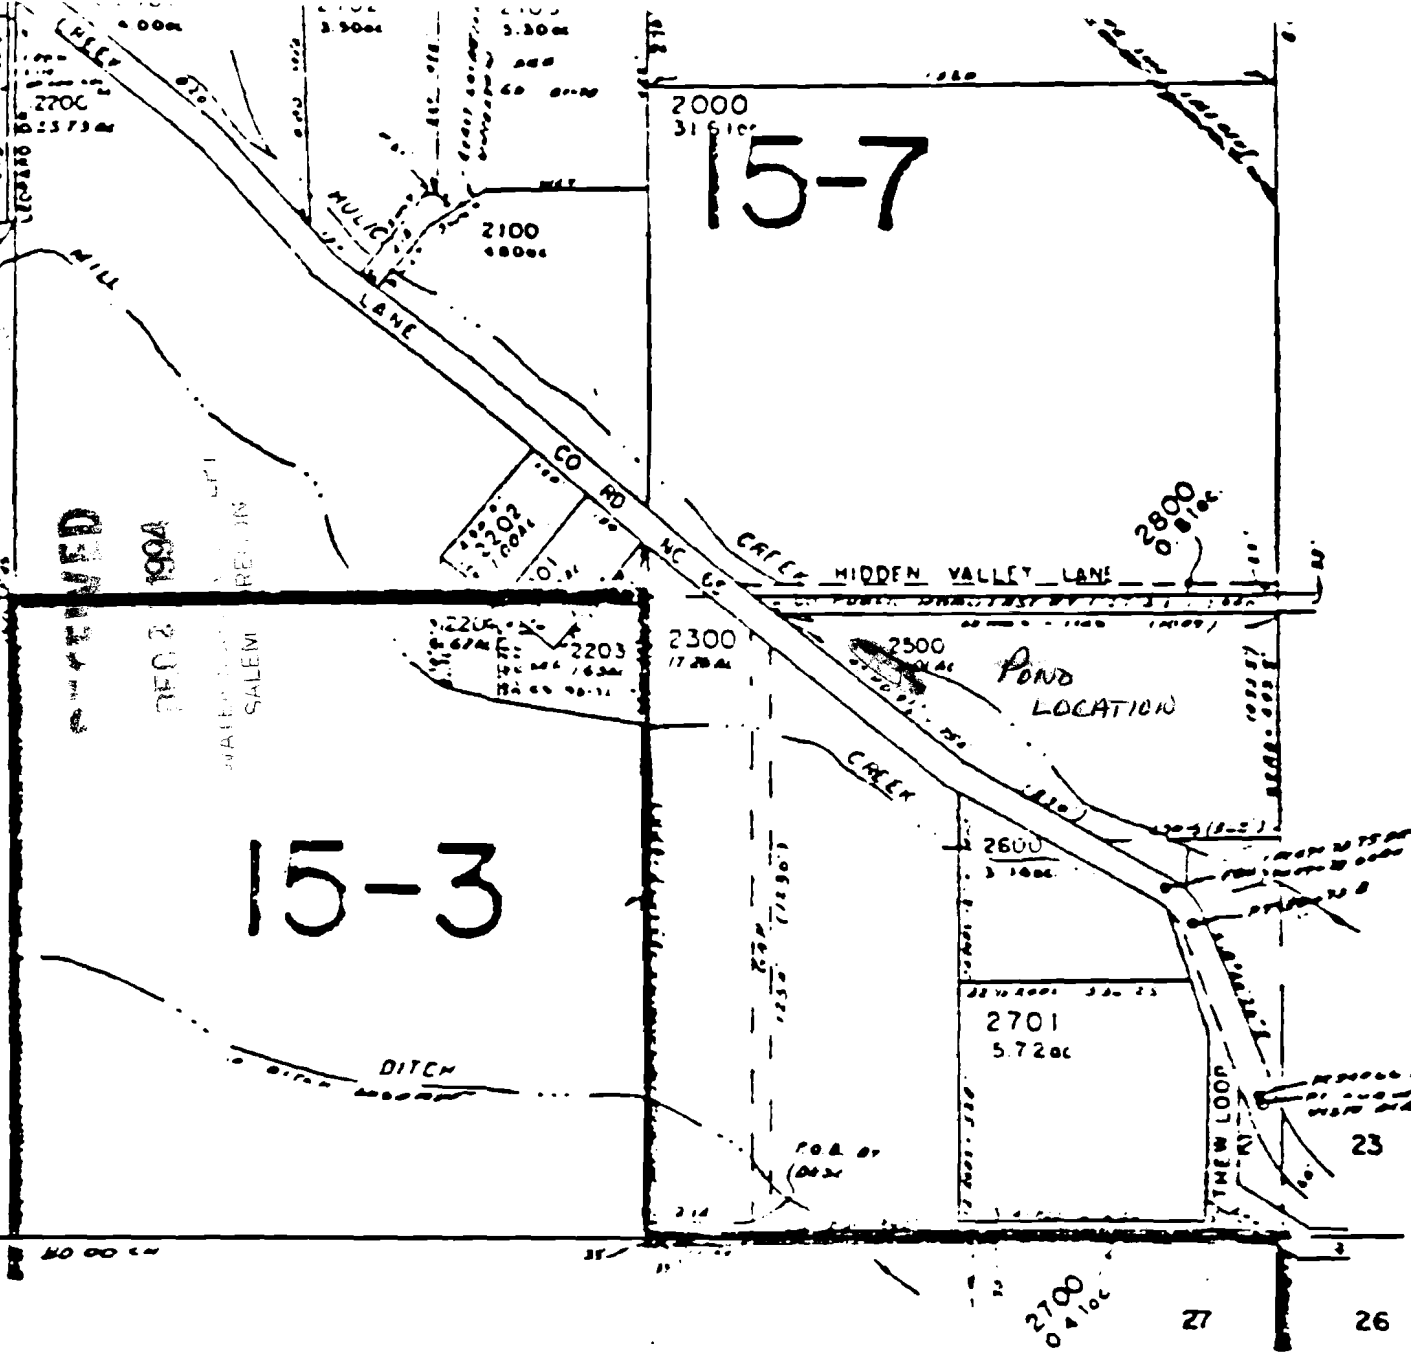

SEE MAP 3 40