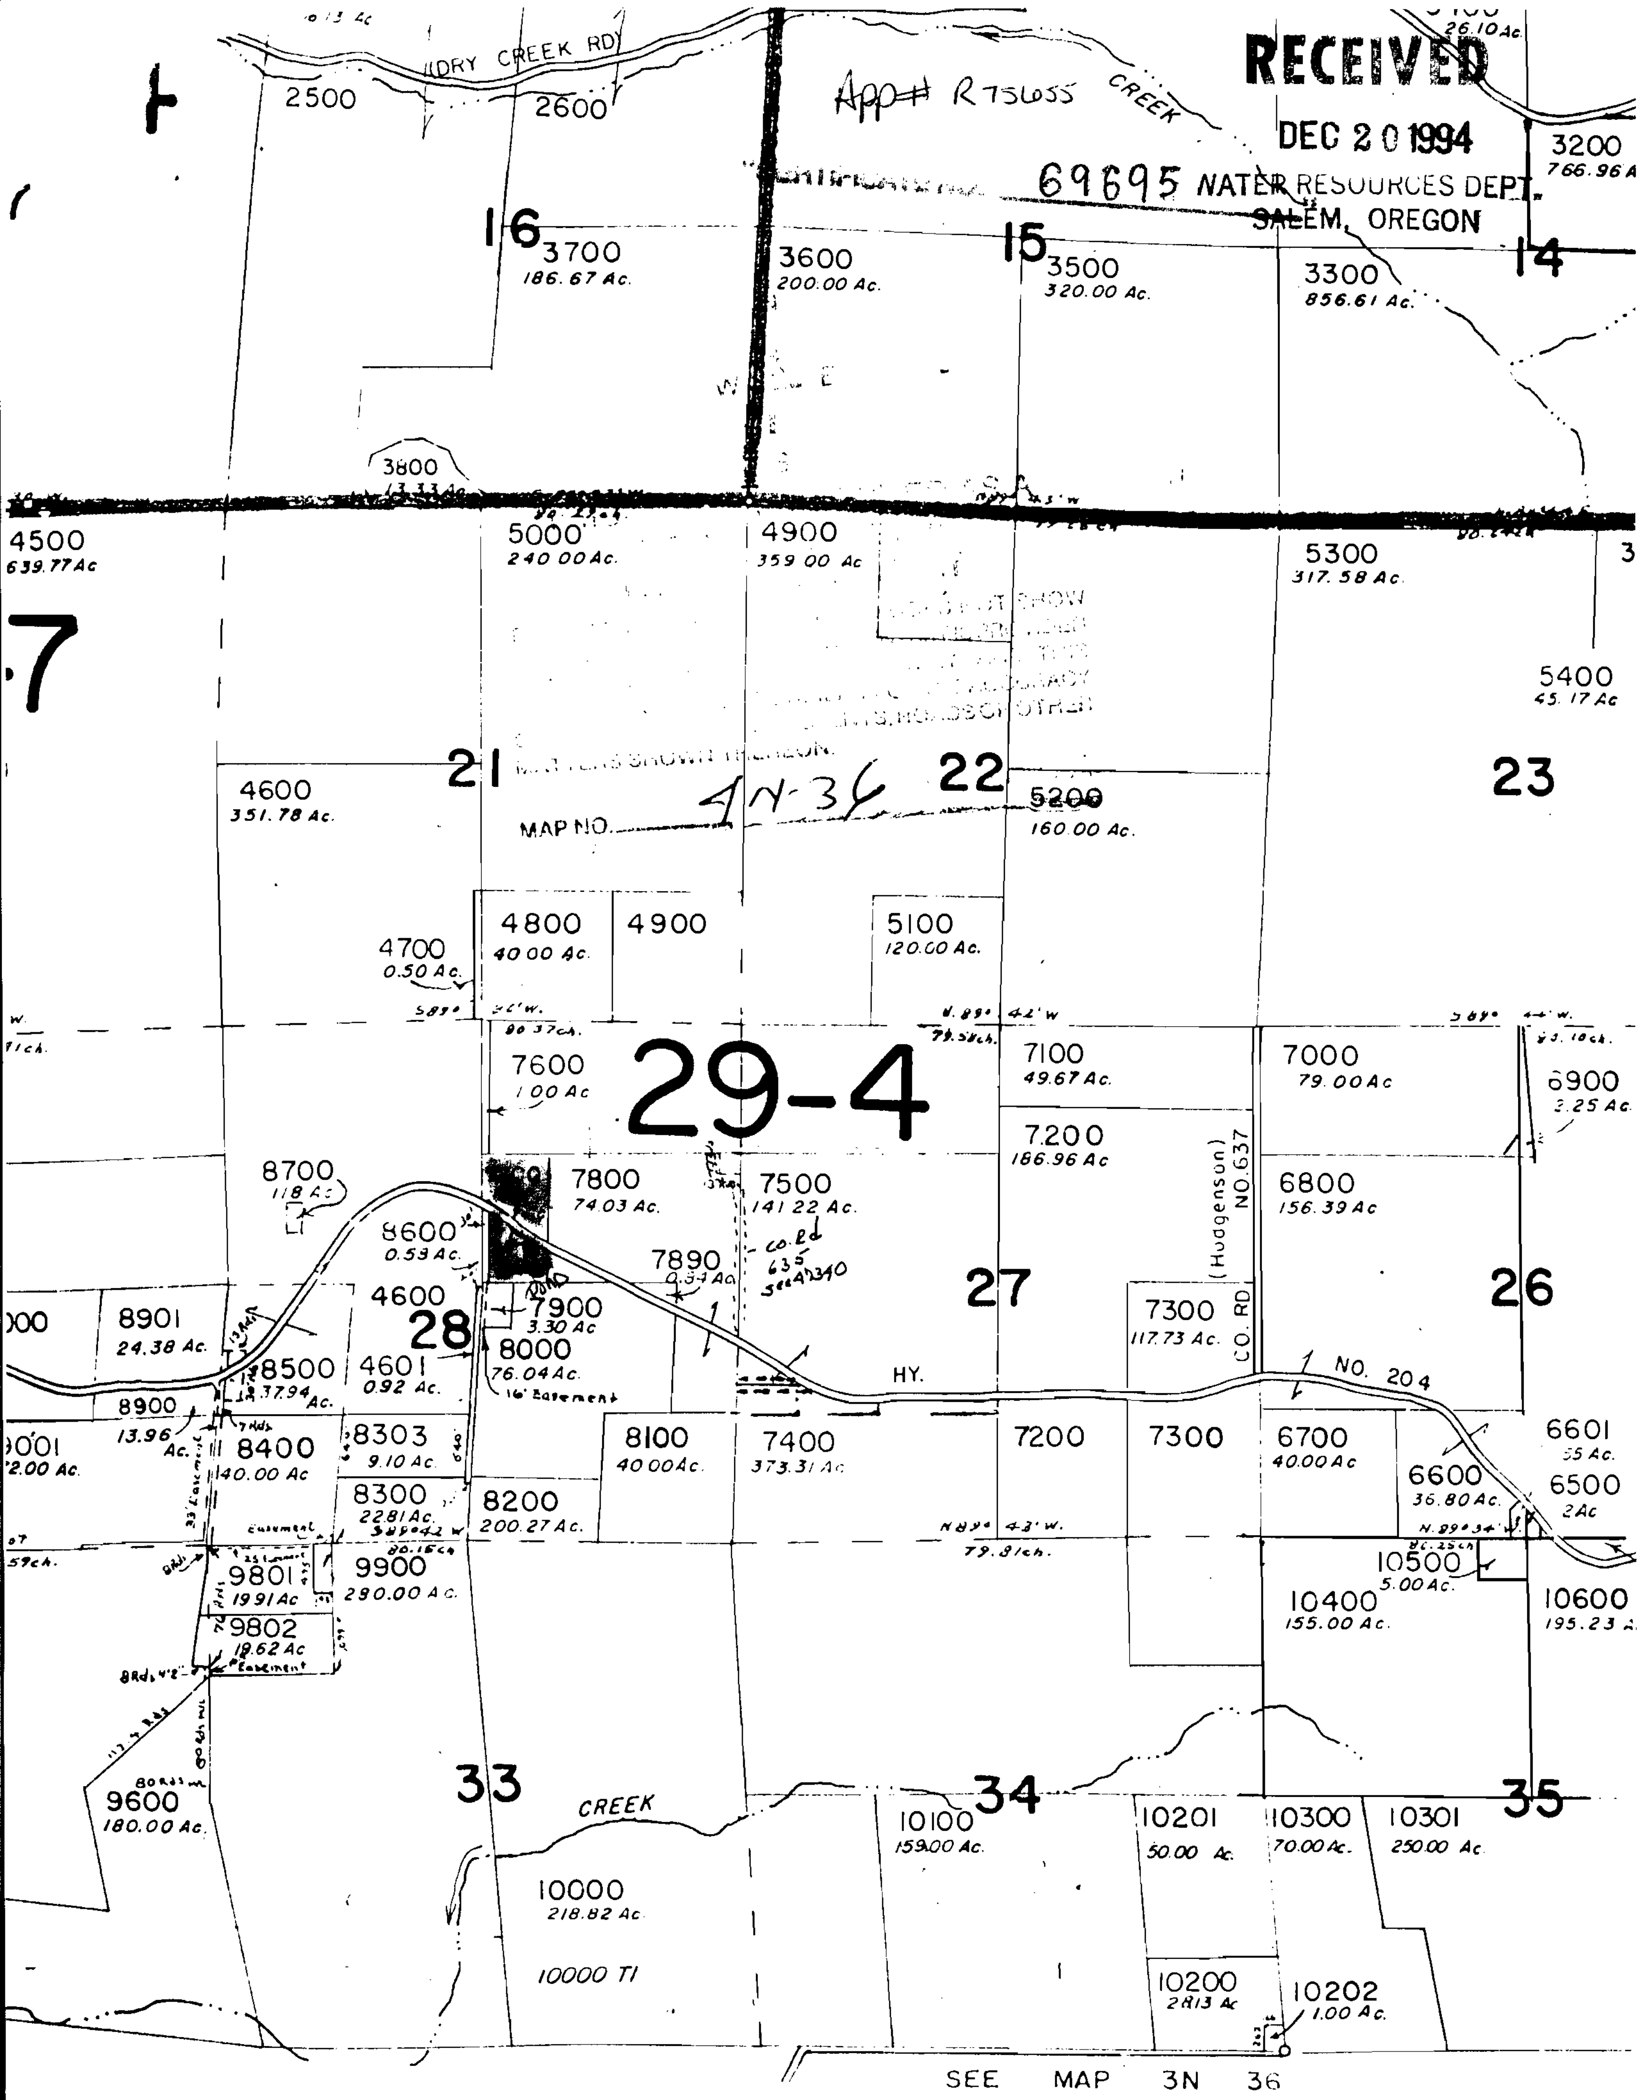

RECEIVED
DEC 20 1994
WATER RESOURCES DEPT.
SALEM, OREGON
App# R75655
69695
DRY CREEK RD
CREEK
2500
2600
3200
766.96 Ac
16
3700
186.67 Ac.
3600
200.00 Ac.
15
3500
320.00 Ac.
3300
856.61 Ac.
14
3800
13.33 Ac
4500
639.77 Ac
5000
240.00 Ac.
4900
359.00 Ac
5300
317.58 Ac.
5400
45.17 Ac
7
4600
351.78 Ac.
21
22
5200
160.00 Ac.
23
MAP NO. 4N-36
4700
0.50 Ac.
4800
40.00 Ac.
4900
5100
120.00 Ac.
7600
1.00 Ac
29-4
7100
49.67 Ac.
7000
79.00 Ac
6900
3.25 Ac.
7200
186.96 Ac
8700
1.18 Ac
7800
74.03 Ac.
7500
141.22 Ac.
(Hudgenson) NO. 637 CO. RD
6800
156.39 Ac
8600
0.53 Ac.
7890
0.34 Ac
4600
27
26
8901
24.38 Ac.
28
7900
3.30 Ac
8000
76.04 Ac.
7300
117.73 Ac.
8500
37.94 Ac.
4601
0.92 Ac.
HY.
NO. 204
16' Easement
8900
13.96 Ac.
8400
140.00 Ac
8303
9.10 Ac.
8100
40.00 Ac.
7400
373.31 Ac
7200
7300
6700
40.00 Ac
6601
.55 Ac.
6600
36.80 Ac.
6500
2 Ac
8300
22.81 Ac.
8200
200.27 Ac.
Easement
9801
19.91 Ac
9900
280.00 Ac.
10500
5.00 Ac.
10400
155.00 Ac.
10600
195.23 Ac
9802
19.62 Ac
Easement
33
9600
180.00 Ac.
CREEK
34
35
10100
159.00 Ac.
10201
50.00 Ac.
10300
70.00 Ac.
10301
250.00 Ac.
10000
218.82 Ac.
10000 T1
10200
28.13 Ac
10202
1.00 Ac.
SEE MAP 3N 36