


CERTIFICATE NO. 03007

Application No. 75459
Permit No.


N ↑

T15S R6W W.M.

SW $\frac{1}{4}$ SE $\frac{1}{4}$ Sec. 2

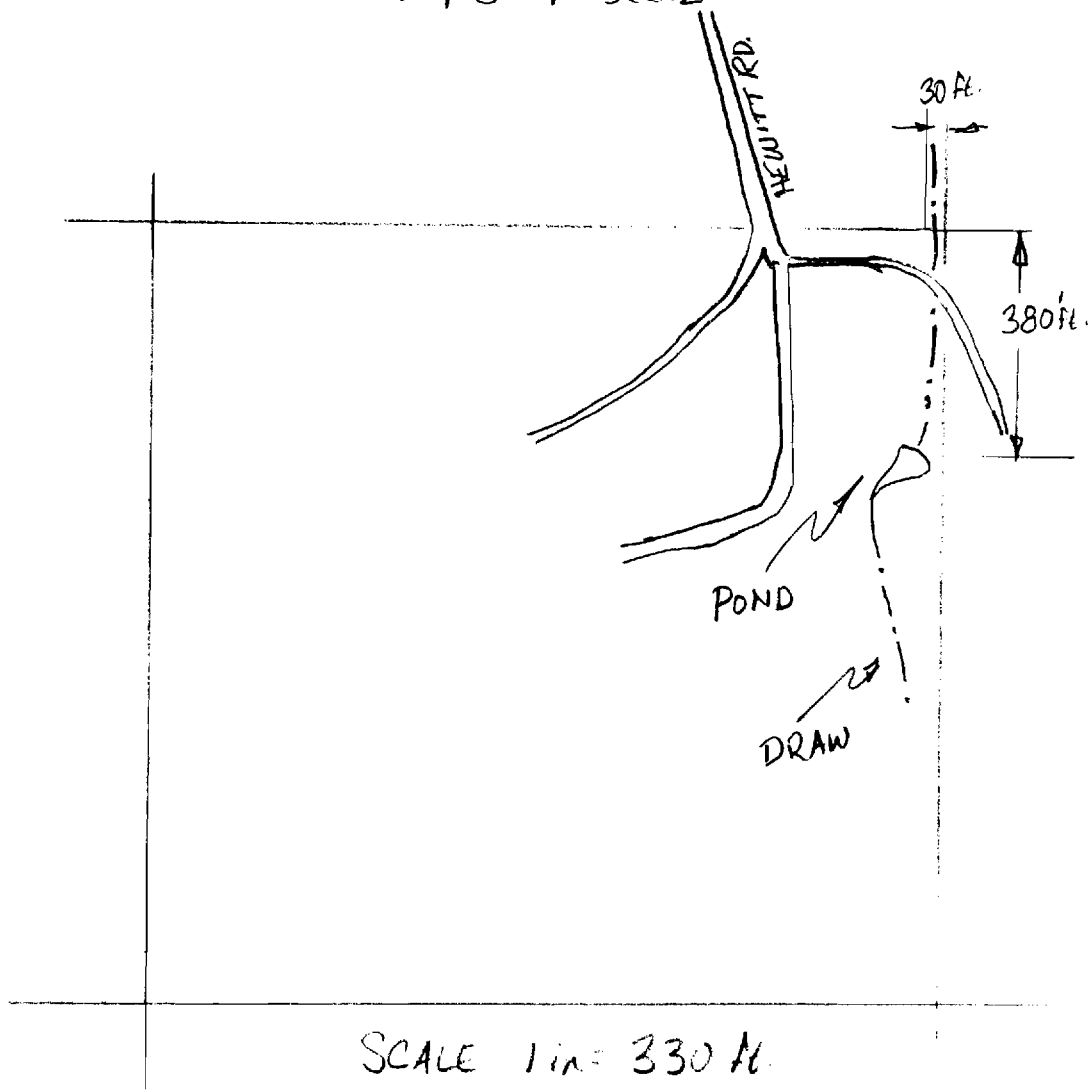

IN THE NAME OF
JAMES CRAWFORD

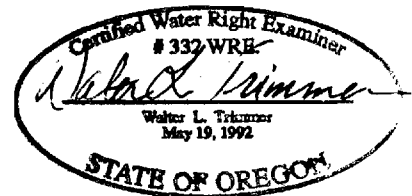

TRACES FROM ASCS
AERIAL PHOTO
WALT TRIMMER
12/12/94