


T16S, R3W, WM
NW $\frac{1}{4}$ NE $\frac{1}{4}$ Sec.34

RECEIVED

DEC 21 1994

WATER RESOURCES DEPT
SALE OR OREGON

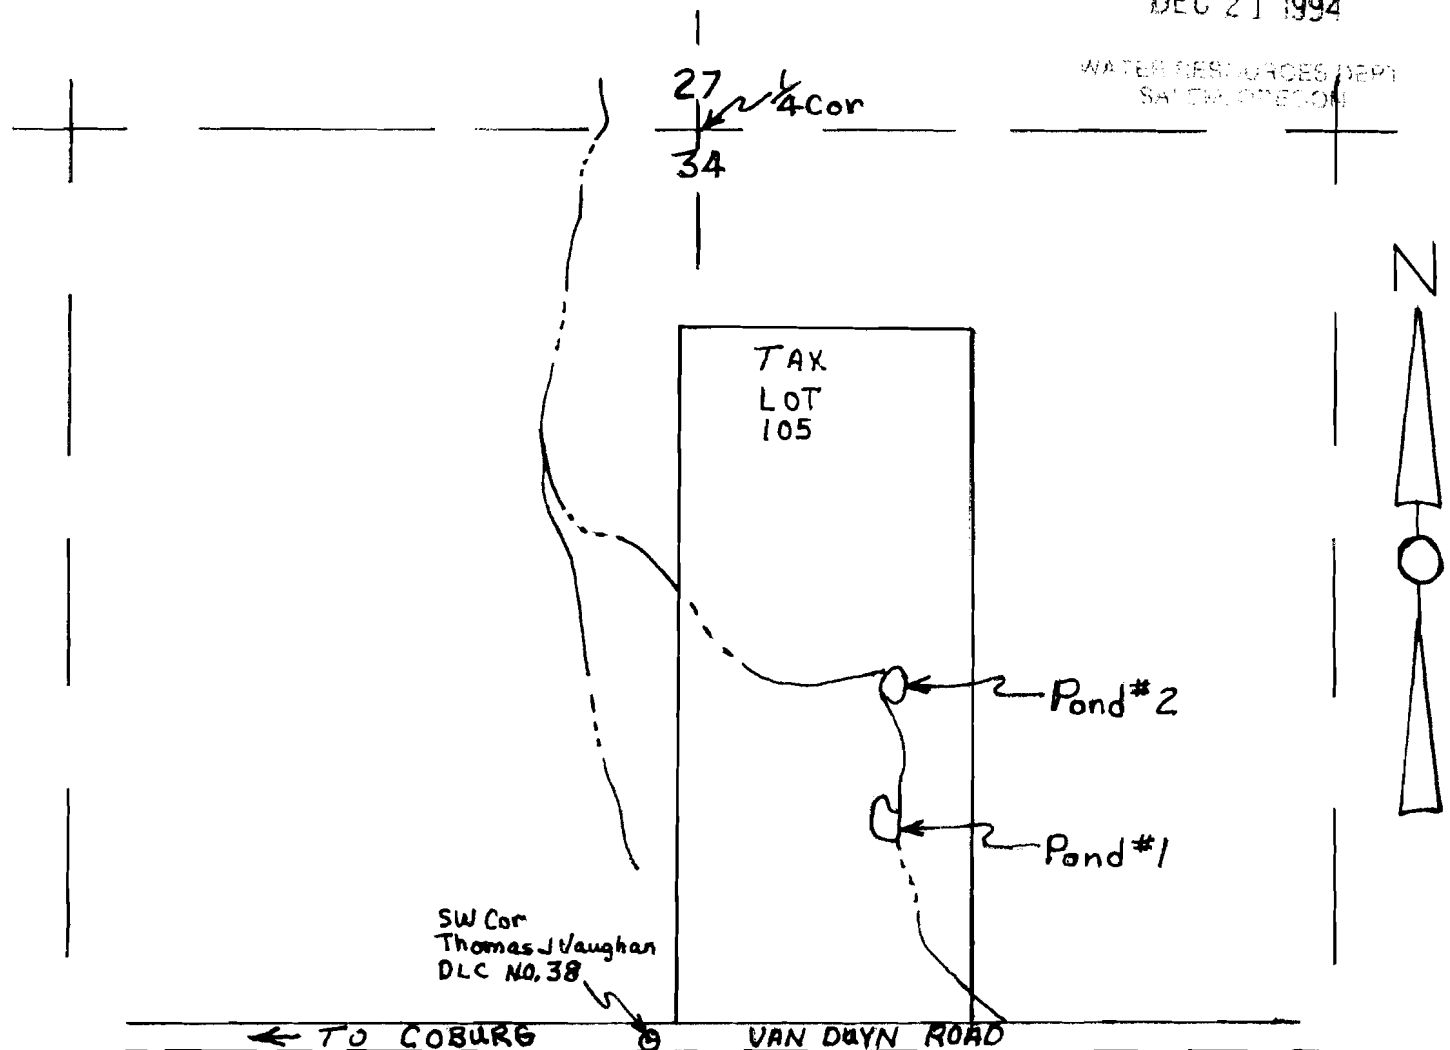

CERTIFICATE NO. 10008


Application No. R-75660
Permit No.

Chuck Bang Ponds

Scale: 1" = 400'

Pond #1 - 485 Feet East
425 Feet North of SE
Cor DLC No. 38.

Pond #2 - 505 Feet East
755 Feet North of SE
Cor DLC No 38.

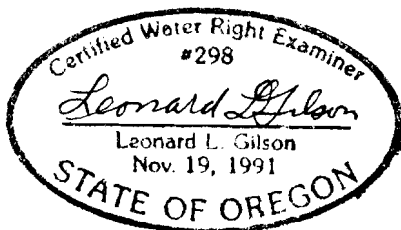

Note: Map is for purpose of identifying
location of water right and pond site
and has no intent to dimension or locate
property ownership lines.

Distances were scaled from WAC Photo. 1" = 100 feet.

RECEIVED

DEC 21 1994


WATER RESOURCES DEPT
SALEM, OREGON



Pond #2
Surface Area - 0.37 AC.
Storage - 1.50 AC. FT.



Pond #1
Surface Area - 0.20 AC.
Storage - 0.90 AC. FT.

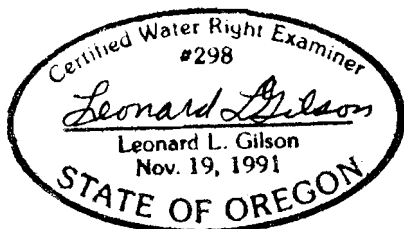

Application No. 12-75662
Permit No.

CERTIFICATE NO. 00008

SCALE: 1" = 100'

PROPERTY LINE →

VAN DUYN RD. (Co. Rd. 254)

SW Cor
Thomas J. Vaughan
DLC No 38