00700
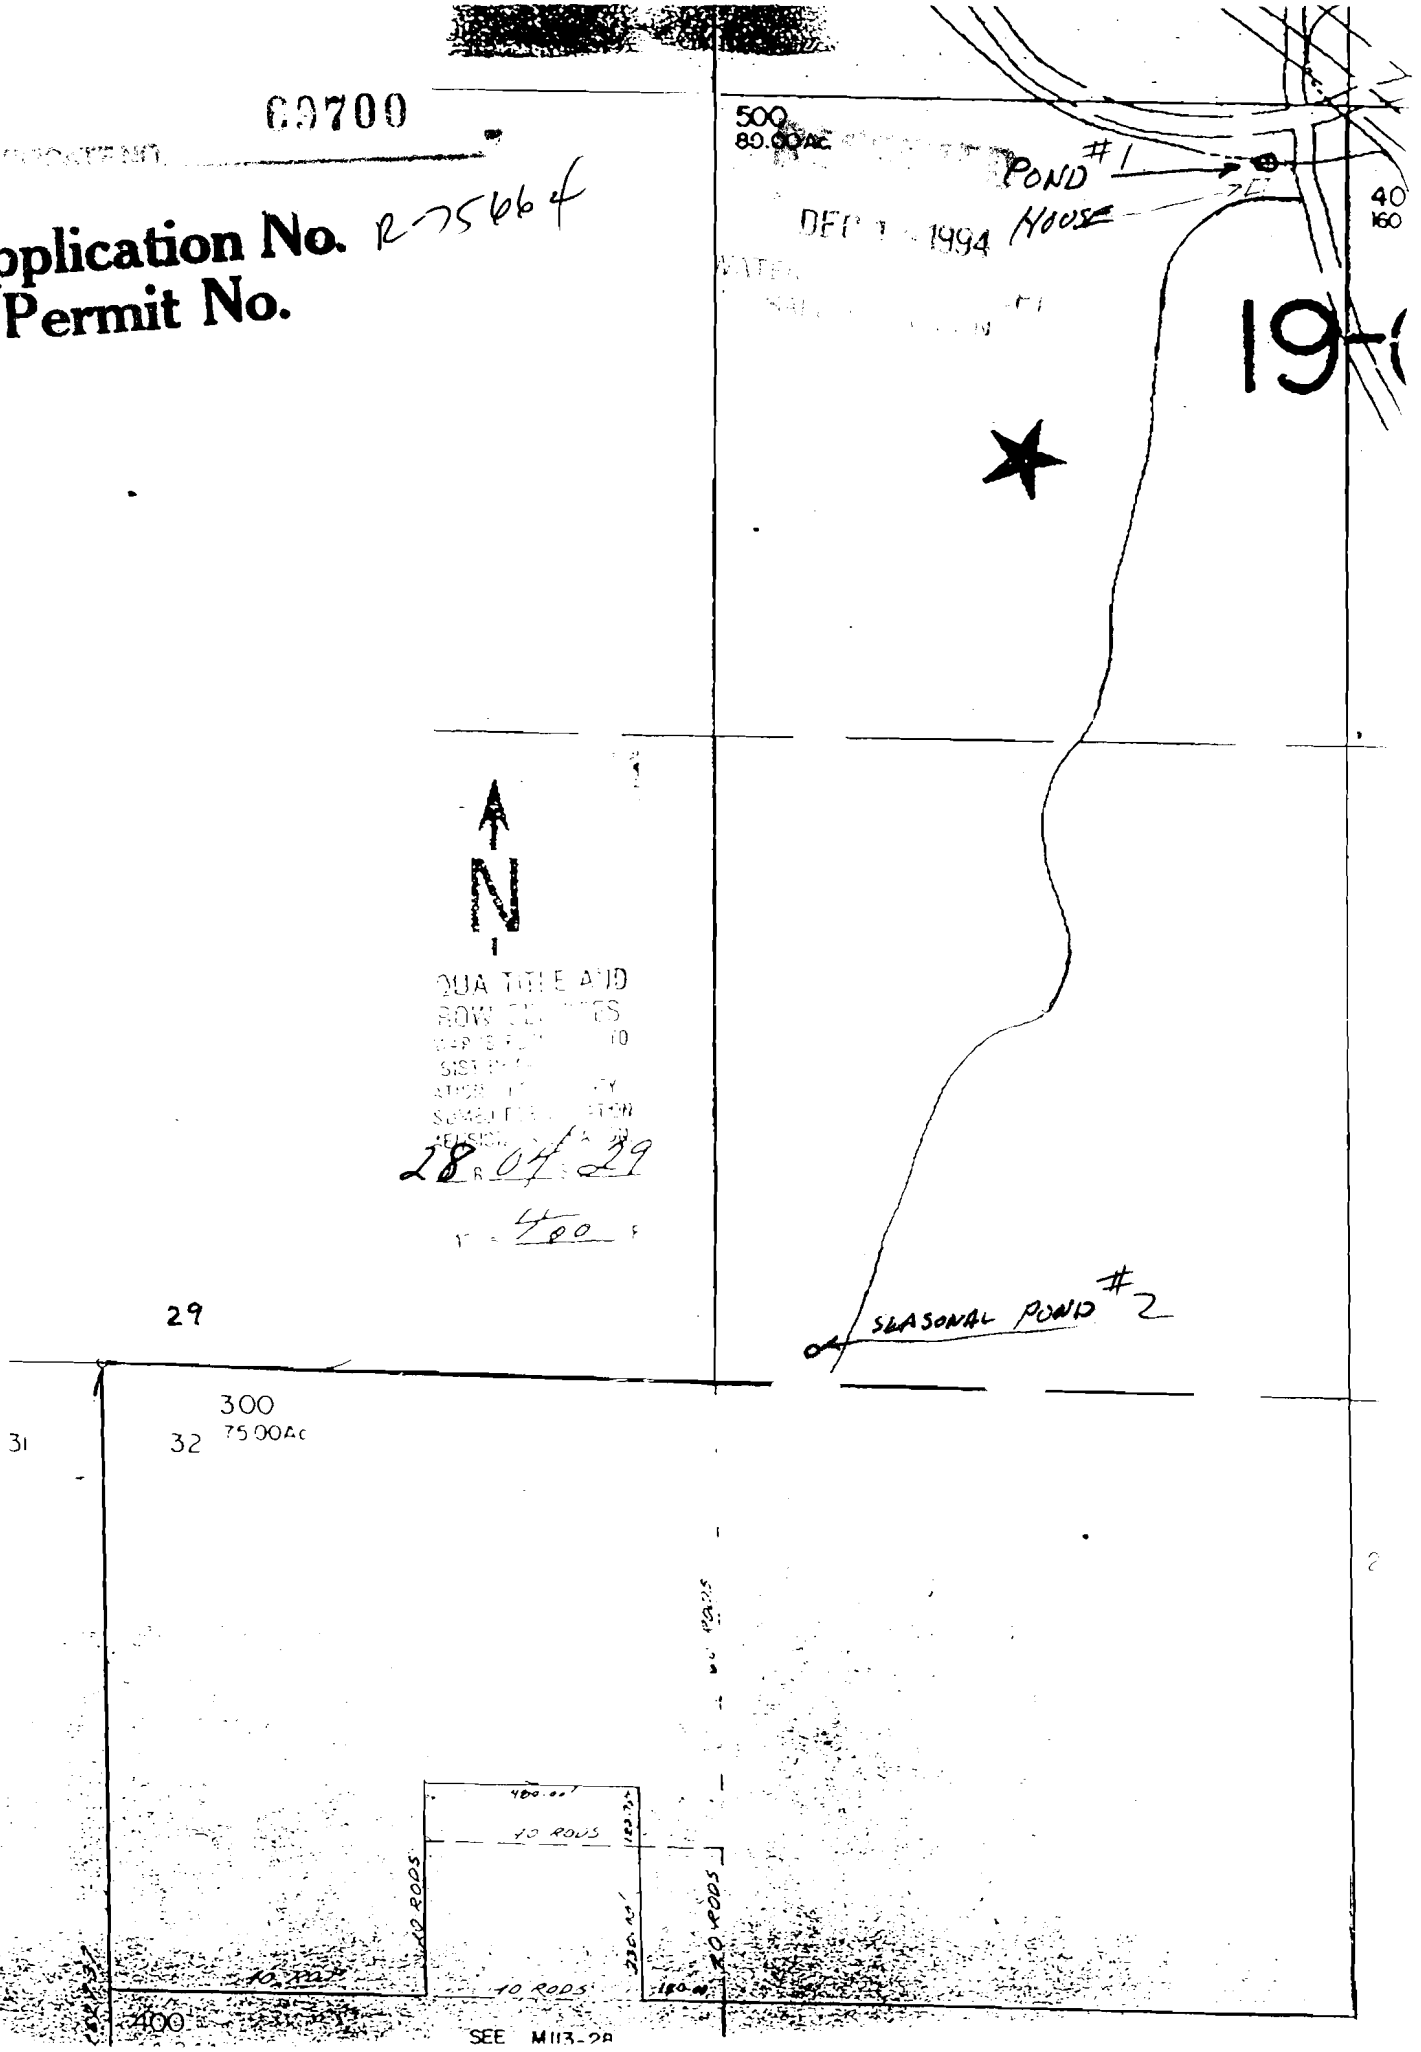
Application No. R-75664
Permit No.