


Township 30 S Range 5 W W M

Douglas County Ore.

Traced from metes and bounds map.
1409-1967

DEC 21 1994
NATURAL RESOURCES DEPT.
SALEM, OREGON

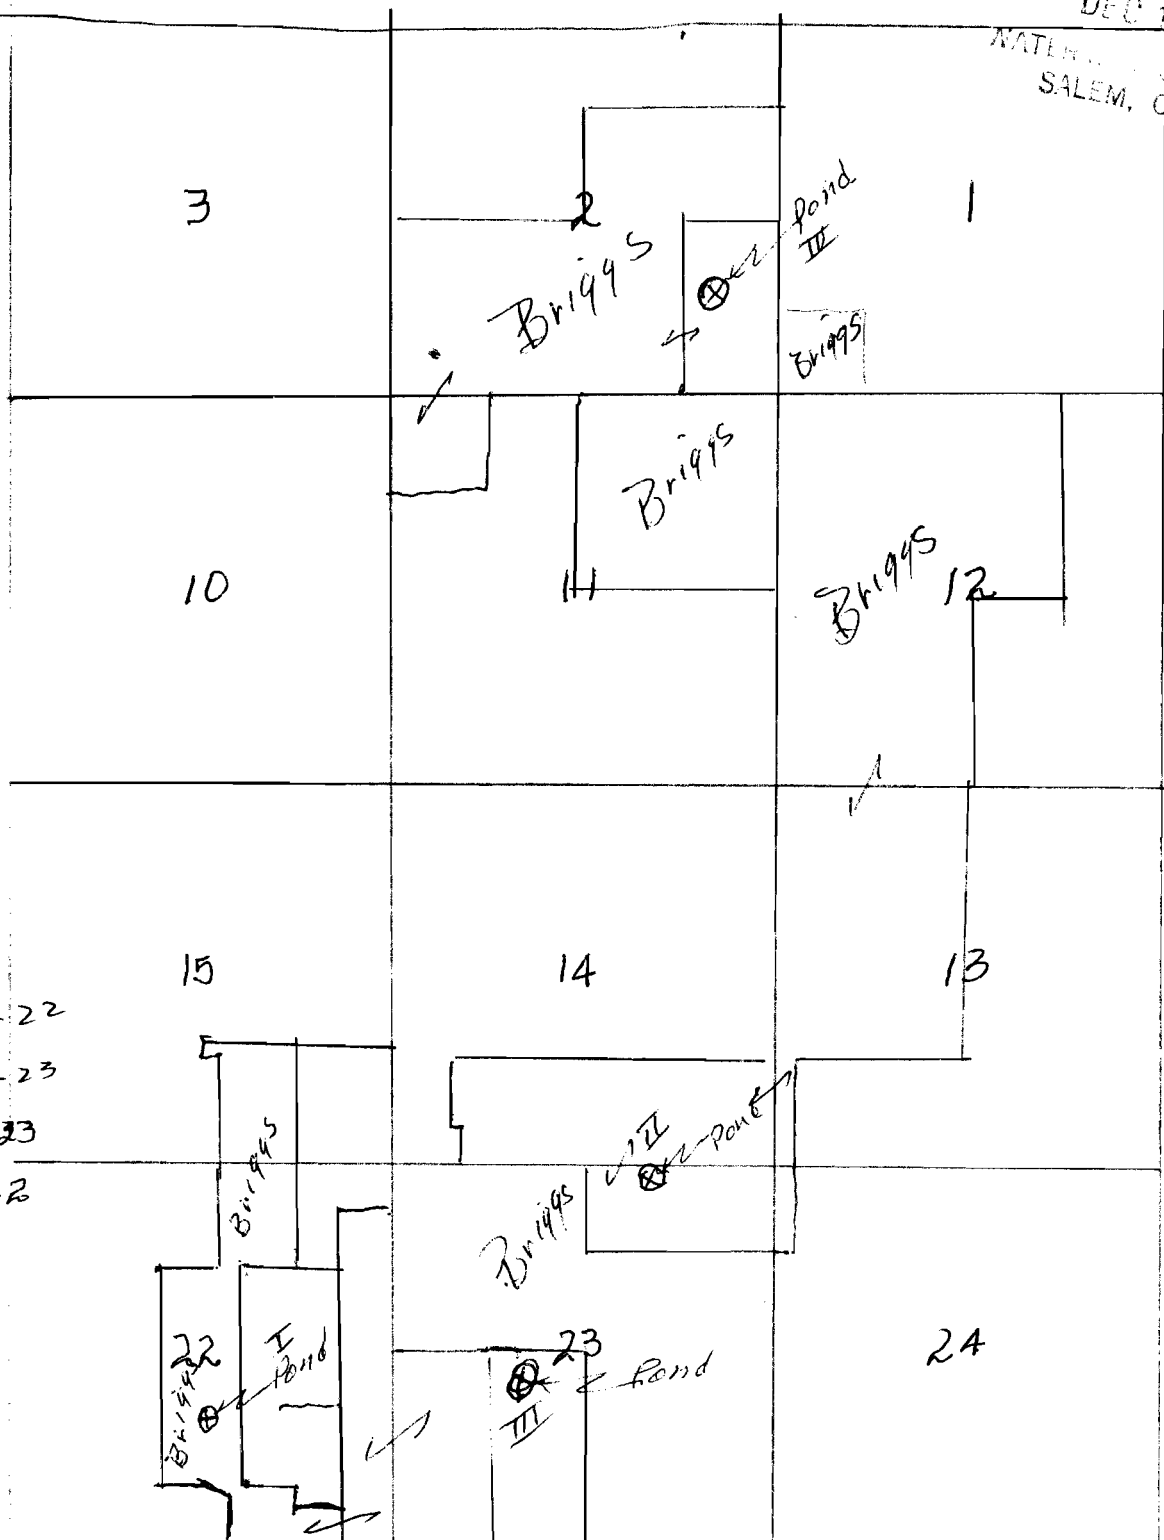

- Ponds
- I - S $\frac{1}{2}$ - SE $\frac{1}{4}$ - 22
 - II - N $\frac{1}{2}$ - NE $\frac{1}{4}$ - 23
 - III - E $\frac{1}{2}$ - SW $\frac{1}{4}$ - 23
 - IV - E $\frac{1}{2}$ - SE $\frac{1}{4}$ - 2

Briggs Farms

Application No. 12-75670.
Permit No.

"CERTIFICATE NO. 69706"