


Pond Existing Built 1968 or 1969

RECEIVED

DEC - 6 1994

WATER RESOURCES DEPT.
SALEM, OREGON

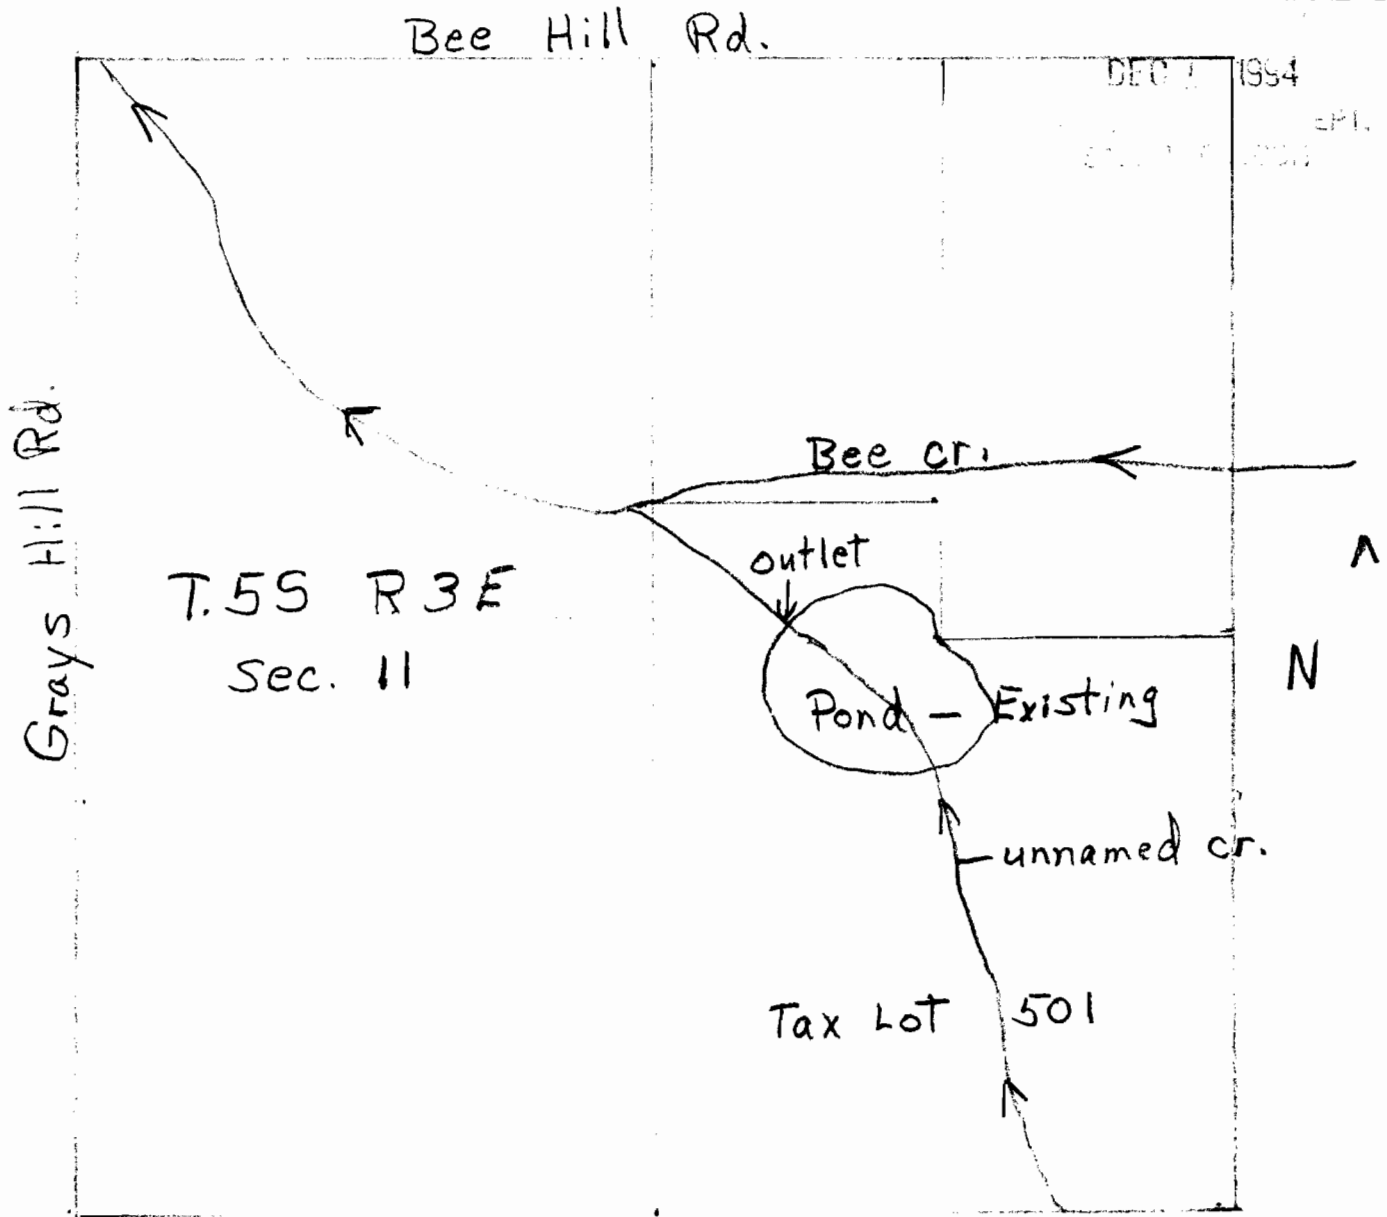

"CERTIFICATE NO. 69707"

Application No. 75671

Permit No.

James E. - Barbara J. Hill
31256 S. Grays Hill Rd.
Colton, Ore, 97017
503-824-3963