


1" = 400'

LINN

SCALE 1" = 9600'

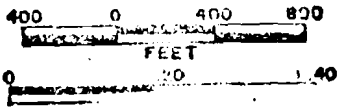


24	19
25	30

19	20
30	29

Tax Listed on 14-1E (19) (8300)

See Map 14 1E

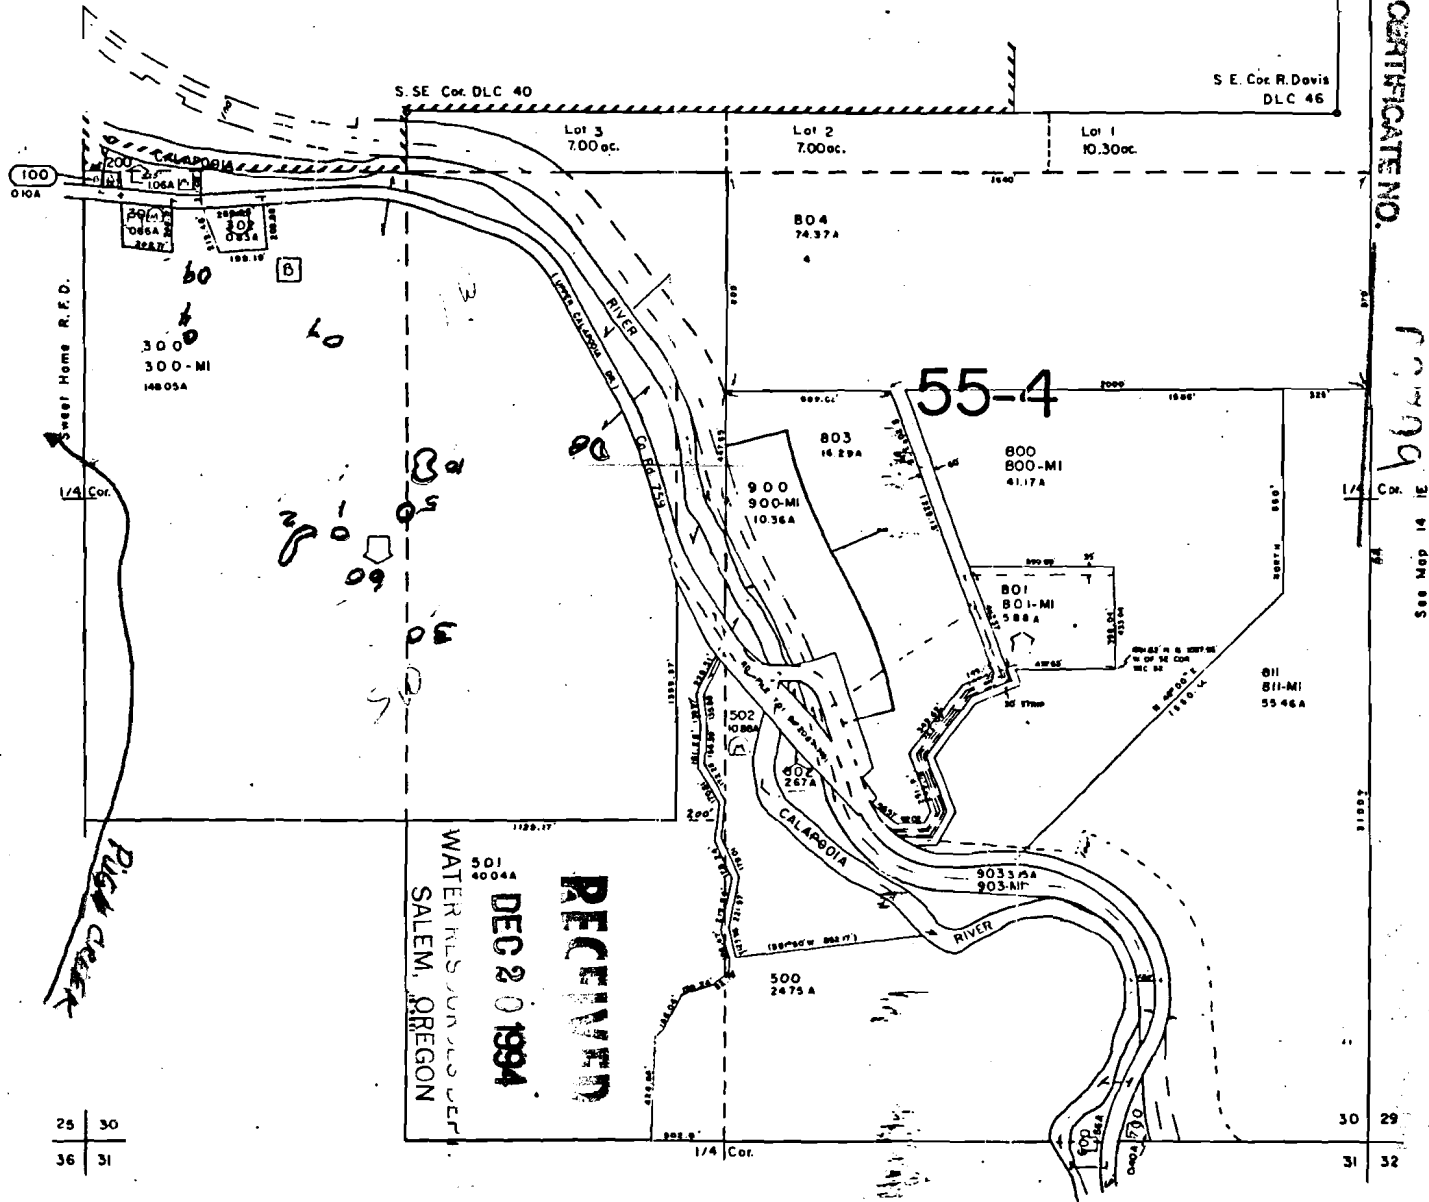

"CERTIFICATE NO. 13799

Attachment No. E-75673
Permit No.

GEORGE & MARY D. DERN
1/2 NW 1/4 & NW 1/4 Sec. 30, T14S, R1E

RECEIVED
DEC 20 1994
WATER RESOURCES DEPT.
SALEM, OREGON

RECEIVED
DEC 17 1990
DEPT. OF REVENUE STATE OF OREGON
ASSESSMENT & APPRAISAL DIV.

NOTE: ROAD AND RIVER LOCATED
FROM AERIAL PHOTO.

See Map 14 1E

25	30
36	31

30	29
31	32