

DEC 20 1994

RECEIVED
WATER RESOURCES DEPT
SALEM, OREGON

DEC 20 1994

WATER RESOURCES DEPT
SALEM, OREGON

Application No. R-7568-1
Permit No.

(X) 103

CLATSOP
STATE
FOREST

1300

1248

23

1200

ST HELENS

CLATSOP
STATE
FOREST

CLATSKANIE RIVER

West Fork
Clatskanie River

SW 1/4 of SE 1/4
Sec. 23, 5N,
R3W WM

446'

1300

176'

HB 2153 Registration of
EXISTING POND on
SW 1/4 of SE 1/4, Sec. 23,
5N, R3W WM.

BAUDER'S EMERALD FOREST
26000 Pittsburg Rd.
St. Helens, OR


SCALE
1/8" = 100'

N


APPLICATION MAP
IN THE NAME OF RUDOLPH BAUDER
SEC. 23 T5N, R.3 W, W.M.
COLUMBIA COUNTY ORE.
SCALE 1" = 1/4 MILE

Approved
Permit

R-75682

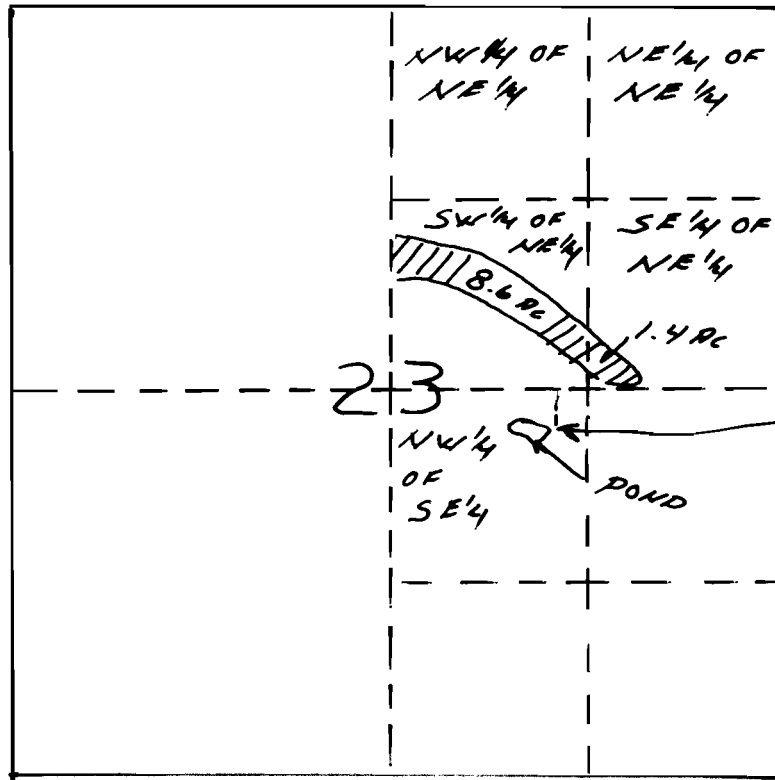

THE P.O.D. IS
LOCATED 140'
WEST AND 150'
SOUTH OF THE
NE CORNER OF THE
NW 1/4 OF THE
SE 1/4 OF SEC.
23

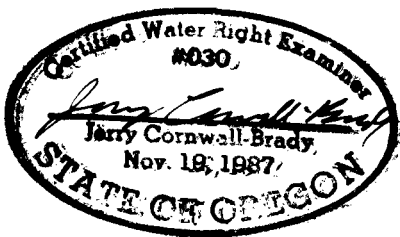

THE PURPOSE OF THIS MAP IS TO IDENTIFY
THE LOCATION OF THE WATER RIGHT. IT IS
NOT INTENDED TO PROVIDE INFORMATION
RELATIVE TO THE LOCATION OF PROPERTY
OWNERSHIP BOUNDARY LINES.