

Application No. R-75540  
Permit No.

CERTIFICATE NO. 69717

MILE 30  
WALLONIA

RIVER

STOCK PONDS

Parsnip

Creek

Pond 11

Pond 10

CORNER 3329

SPRING

SPRING

SPRING

SPRING

SPRING

x35547

x35637

37667 x

33687 x

3665 x

36587

36887

STOCK POND

WATER RESOURCES  
SALEM, OREGON

x39017

STOCK POND

3705 T

x35757

33357

16

15

14

21

22

23

27

26

28


33

P

P

UNDS

UNDS

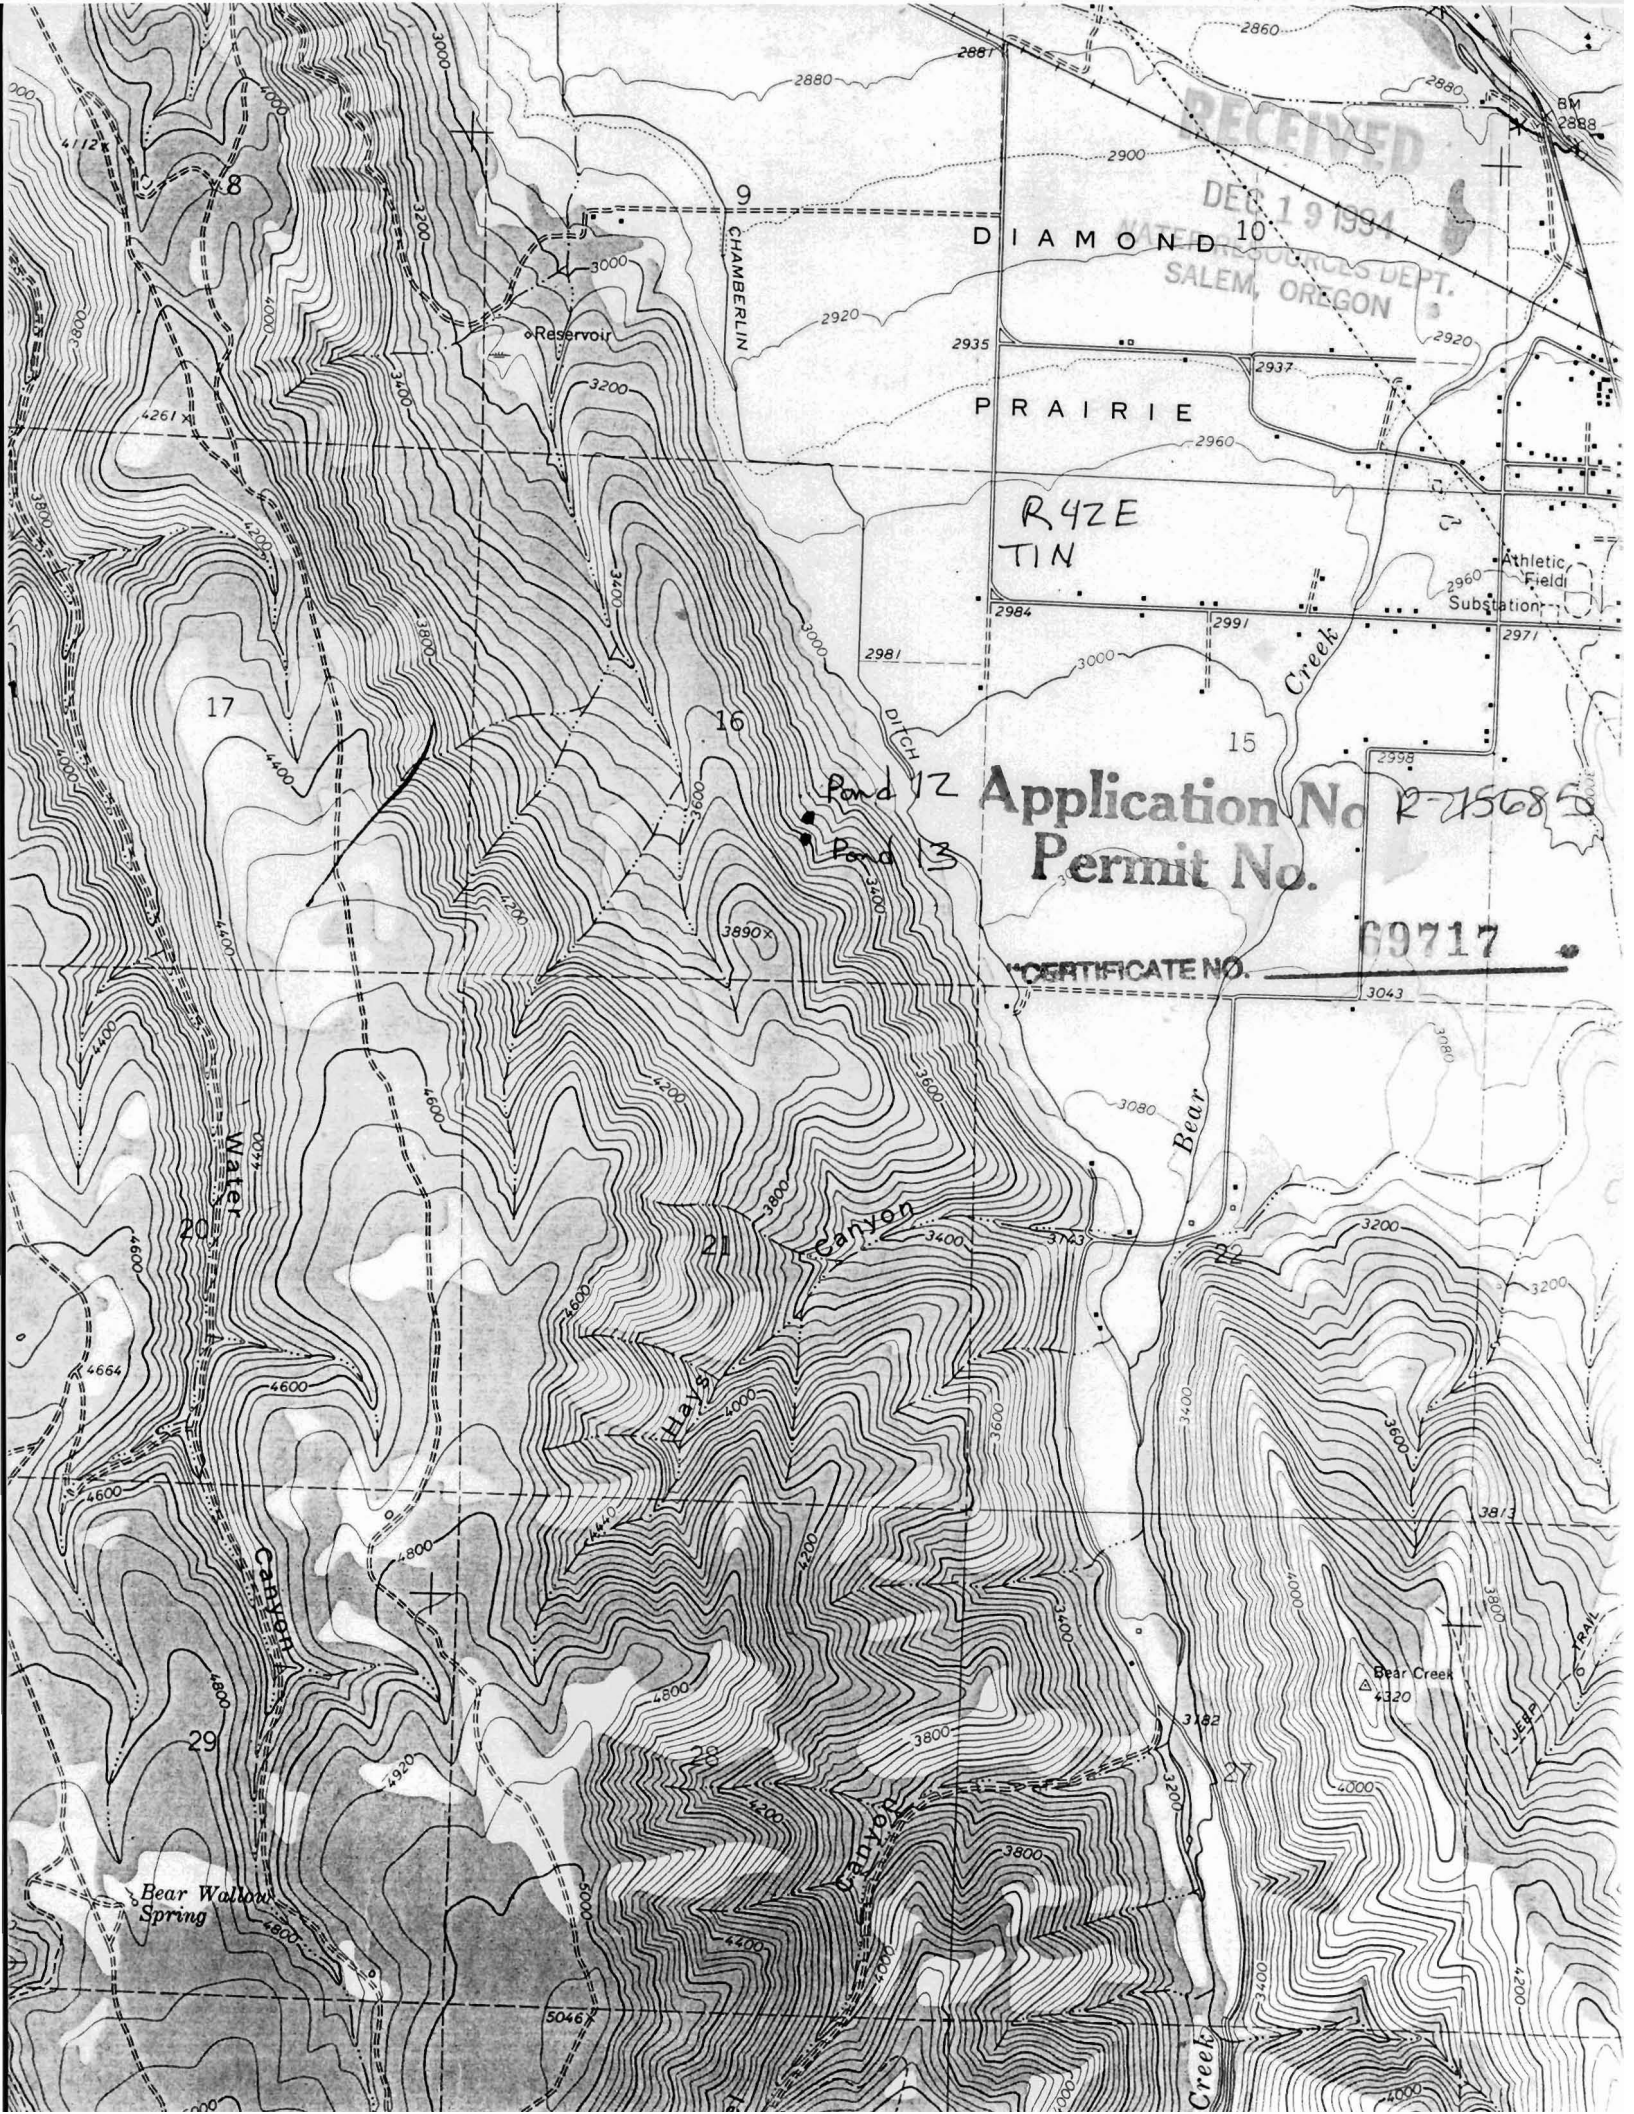

RECEIVED  
DEC 19 1994  
WATER RESOURCES DEPT.  
SALEM, OREGON

DIAMOND 10

PRAIRIE

R4ZE  
TIN

Application No R-215685  
Permit No.

CERTIFICATE NO. 69717  
3043

CHAMBERLIN

Creek

Bear

Canyon

Hays

Creek

Bear Wallon  
Spring

Bear Creek  
4320

BM  
2888

17

16

15

21

22

29

28

27

8

9

10

Reservoir

Pond 12

Pond 13

DITCH

Athletic  
Field  
Substation

4600

4800

4920

5046

5000

4400

4200

4200

4000

3800

3200

3000

3800

3200

3000

