


RECEIVED

DEC 22 1994

WATER RESOURCES DEPT
SALEM, OREGON

T.8S.,R.6W.,W.M.

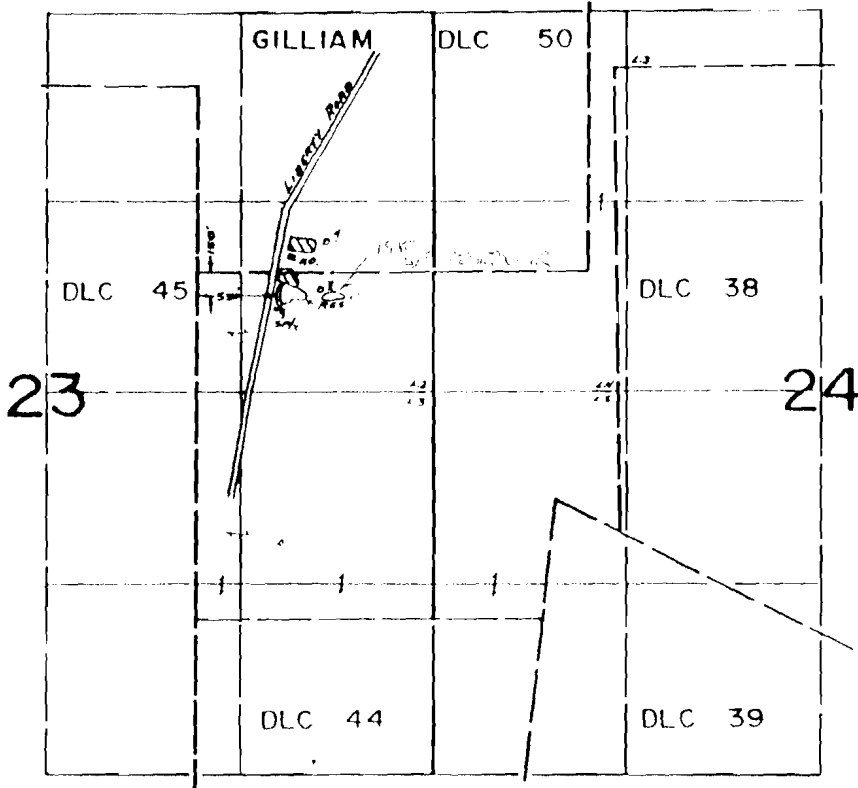

V. J. ... 2-70692
 Permit No.

"CERTIFICATE NO. 69721"

FINAL PROOF SURVEY

UNDER

R-56828 R-6763
 Application No. 56829 Permit No. 42627

IN NAME OF

MIKE MCCRYSTAL

Surveyed Sept. 9, 1981, by L. J. OLL