

The sketch below is made solely for the purpose of assisting in locating said premises and the Company ass no liability for variations, if any, in dimensions and location ascertained by actual survey.


Pioneer National Title Insurance Company
A TICOR COMPANY

"CERTIFICATE NO. 69722"

Application No. R-15693
Permit No.



SEE

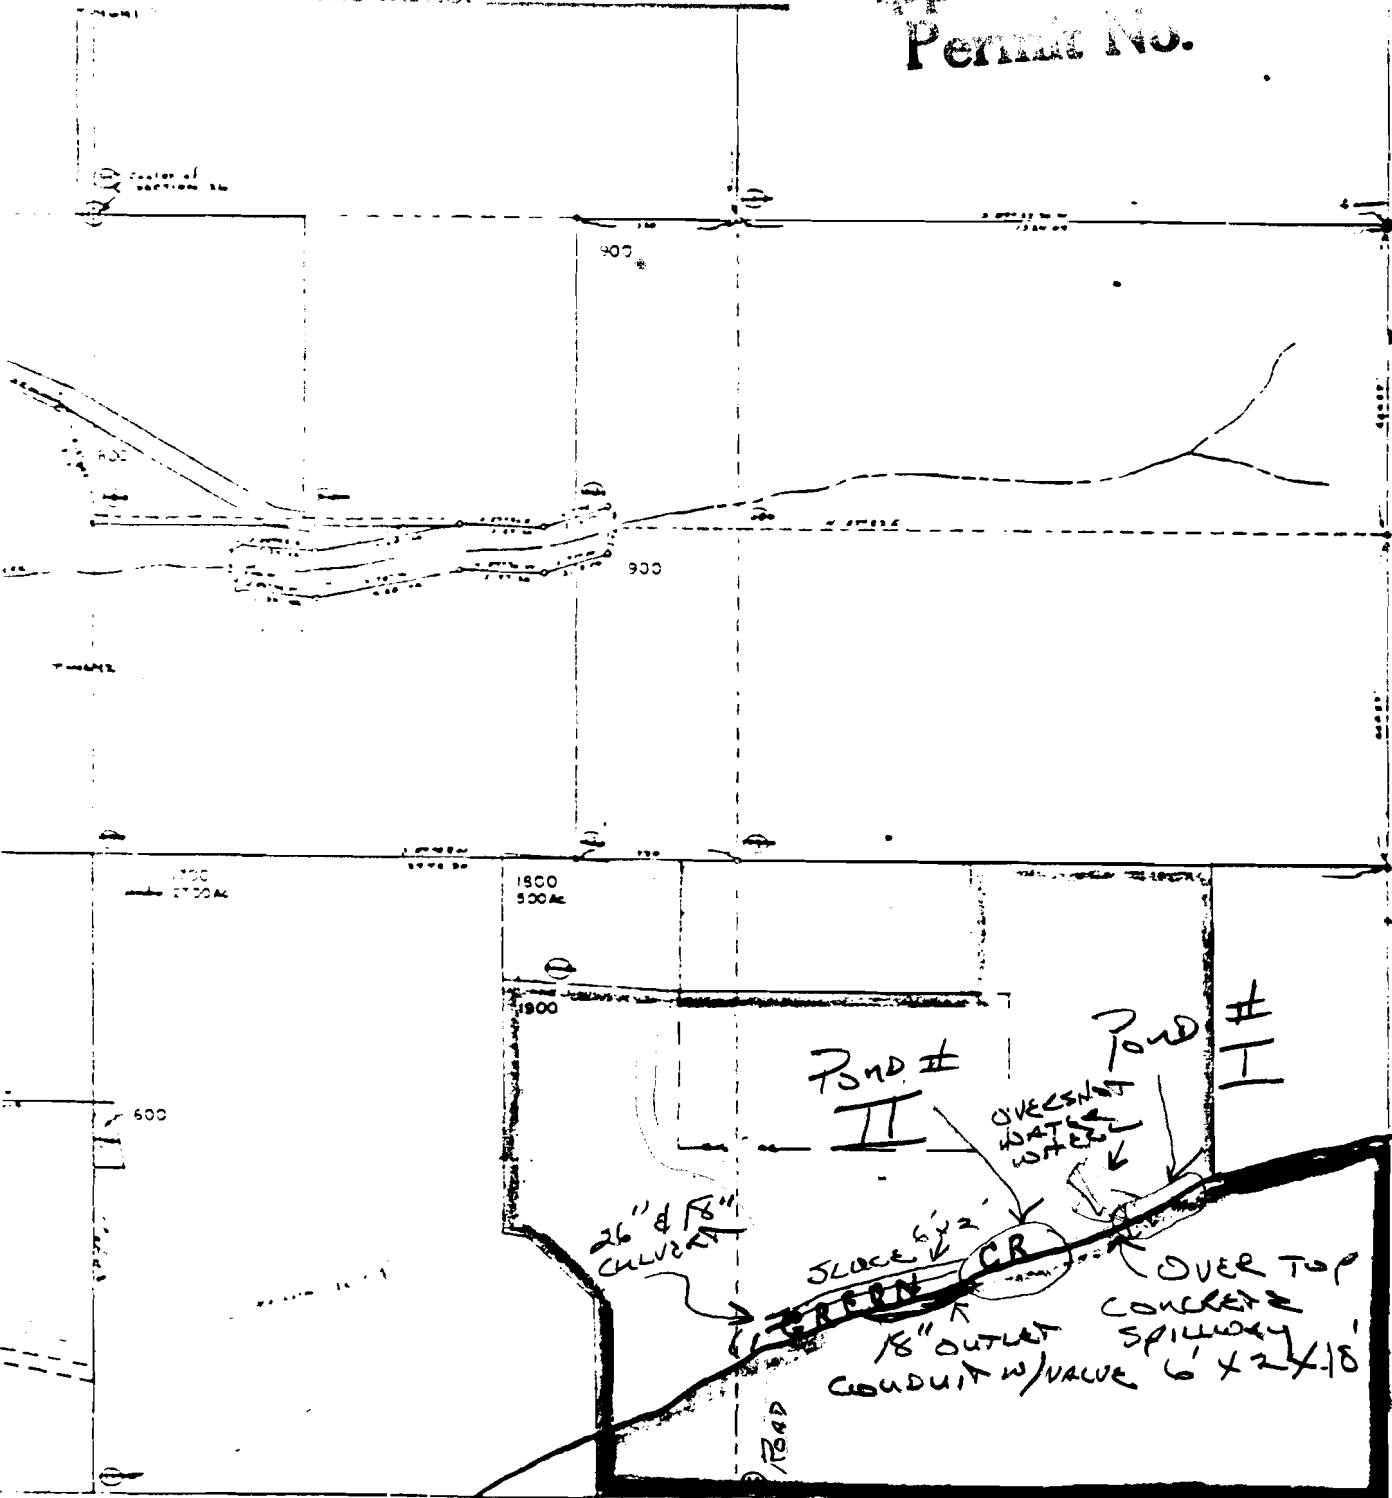

IS 9 2
IS 9 2