


Weyerhaeuser Company

Water Storage Site Map

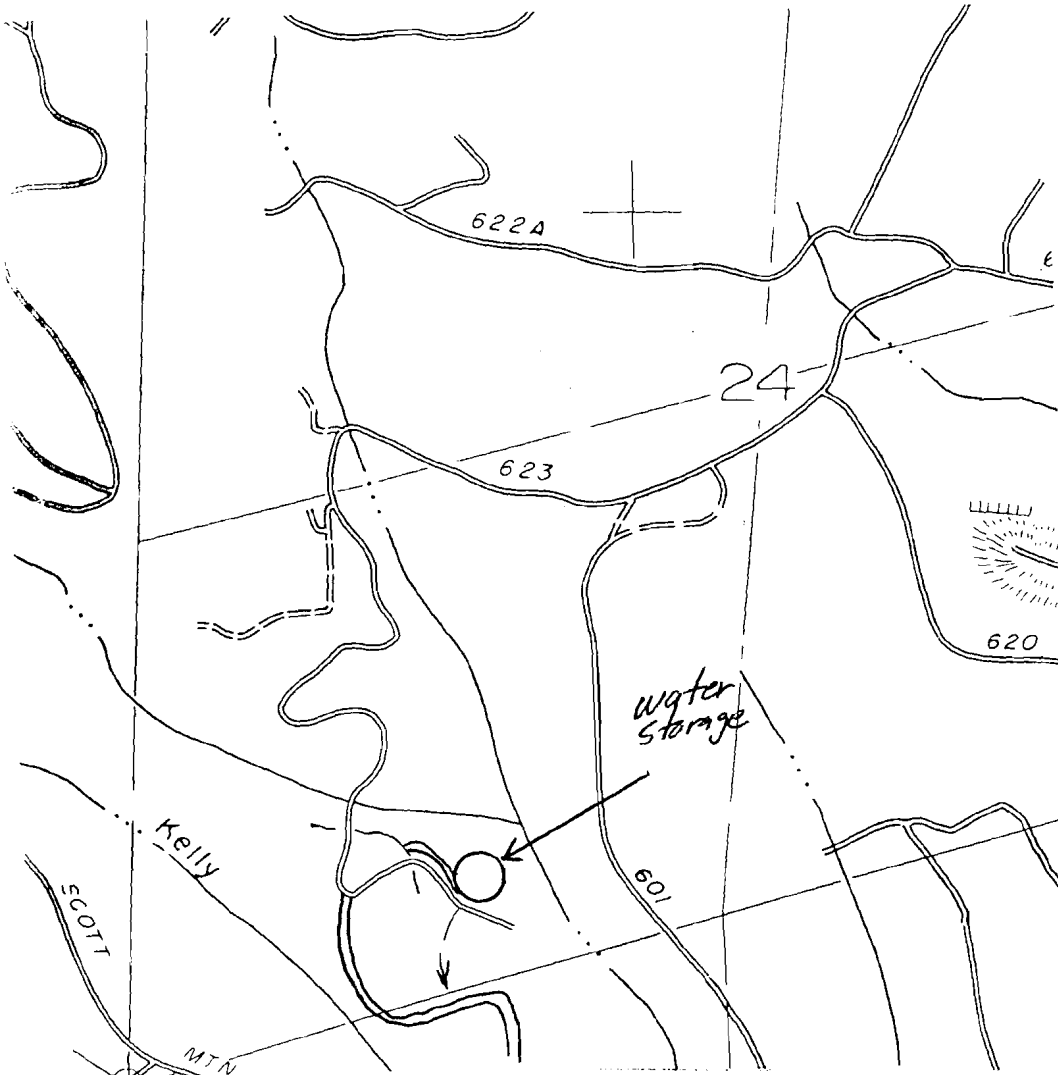

N↑

Map Scale: 1" = 1000 feet

Section 24

Township 25S

Range 3W

Forty SE 1/4, SW 1/4

River Basin Umpqua

RECEIVED

DEC 20 1994

WATER RES. DIV. DEPT.
SALEM, OREGON

Gallons of Water Stored: 99600

"CERTIFICATE NO." 69724

Purpose of Impounded Water:

1. Emergency Fire Suppression
2. water for brush/grass control