

"CERTIFICATE NO. 69732"

Application No. Q-75404
Permit No.


Weyerhaeuser Company
Willamette Timberlands

Water Storage Site Map

RECEIVED

DEC 20 1994

WATER RESOURCES DEPT.
SALEM, OREGON

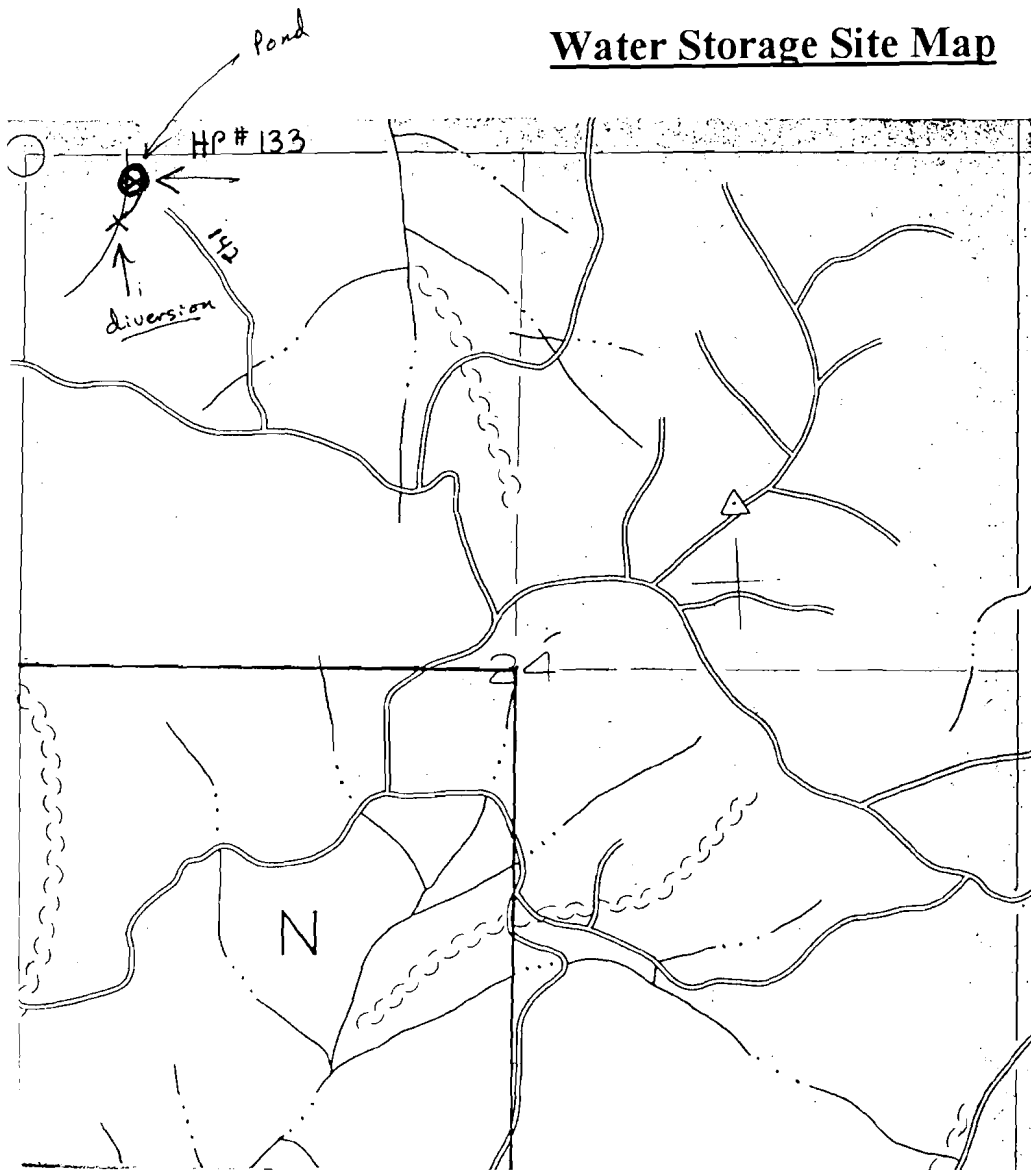

N↑

Map Scale: 1" = 1000 feet

Section 24

Township 14S

Range 2E

Forty NW 1/4, NW 1/4

River Basin South Santiam

Gallons of Water Stored: 53,000

Purpose of Impounded Water:

1. Emergency Fire Suppression

2. _____

Application No. R-75706

Permit No.

CERTIFICATE NO.

69732

Weyerhaeuser Company
Willamette Timberlands

Water Storage Site Map

RECEIVED

DEC 20 1994

WATER RESOURCES DEPT.
SALEM, OREGON

N↑

Map Scale: 1" = 1000 feet


Section 33

Township 14S

Range 3E

Forty SW 1/4, SW 1/4

River Basin South Santiam

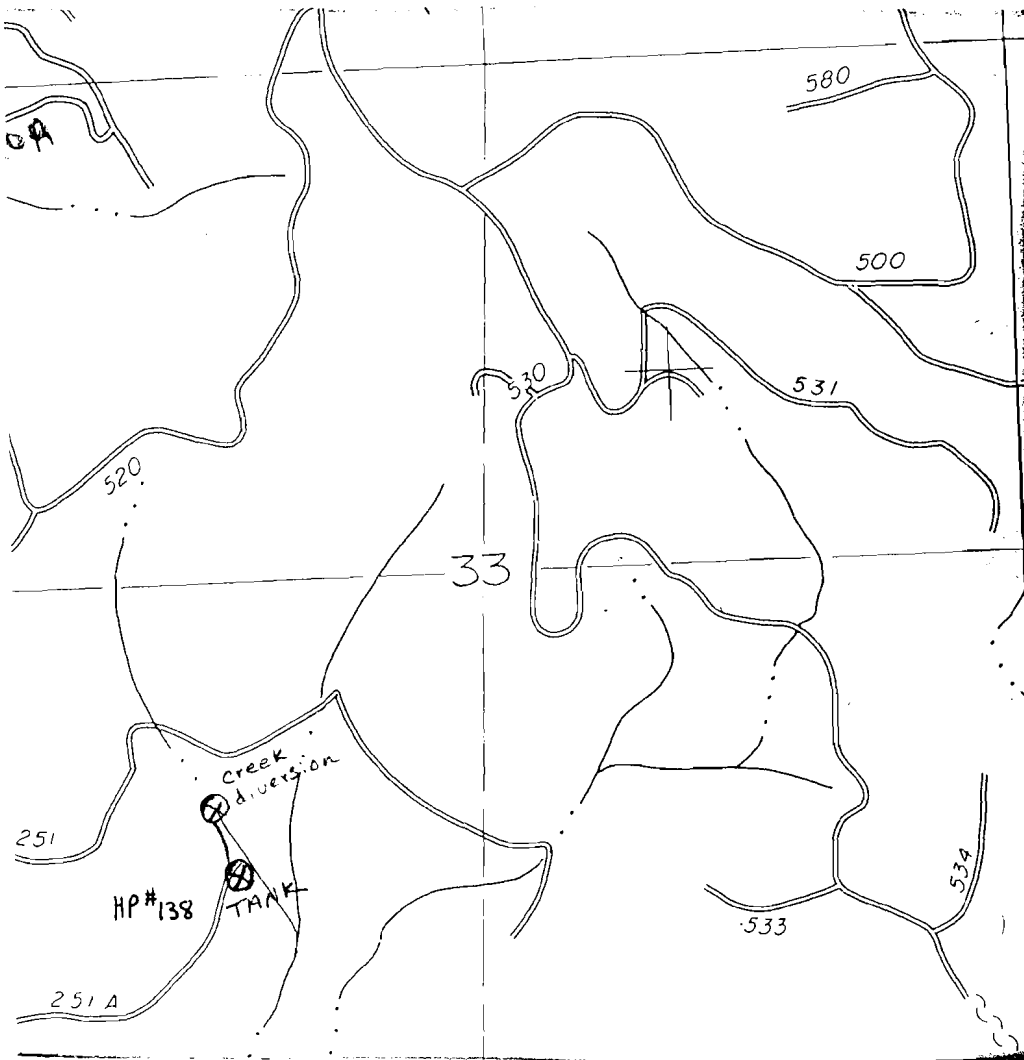

Gallons of Water Stored: 10,000

Purpose of Impounded Water:

① Emergency Fire Suppression

2. _____

Application No. R-75906
Permit No.

CERTIFICATE NO. 69732

Weyerhaeuser Company
Willamette Timberlands

Water Storage Site Map

RECEIVED

DEC 20 1994

WATER RESOURCES DEPT.
SALEM, OREGON

N↑

Map Scale: 1" = 1000 feet


Section 33

Township 14S

Range 3E

Forty SW 1/4, NE 1/4

River Basin South Santiam

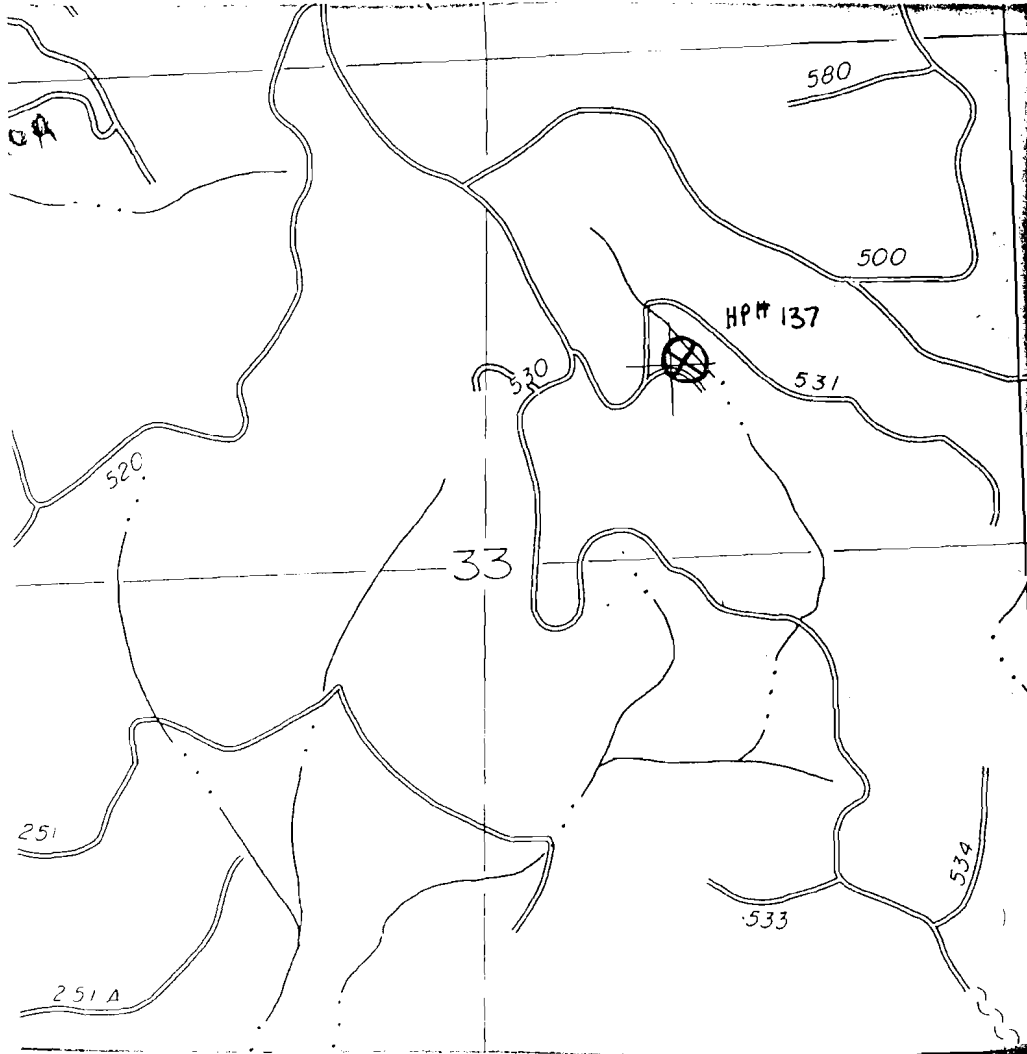

Gallons of Water Stored: 85,000

Purpose of Impounded Water:

1. Emergency Fire Suppression

2. _____