


"CERTIFICATE NO. 6973.3"

Application No. R-75707

Permit No.

Weyerhaeuser Company
Willamette Timberlands

Water Storage Site Map

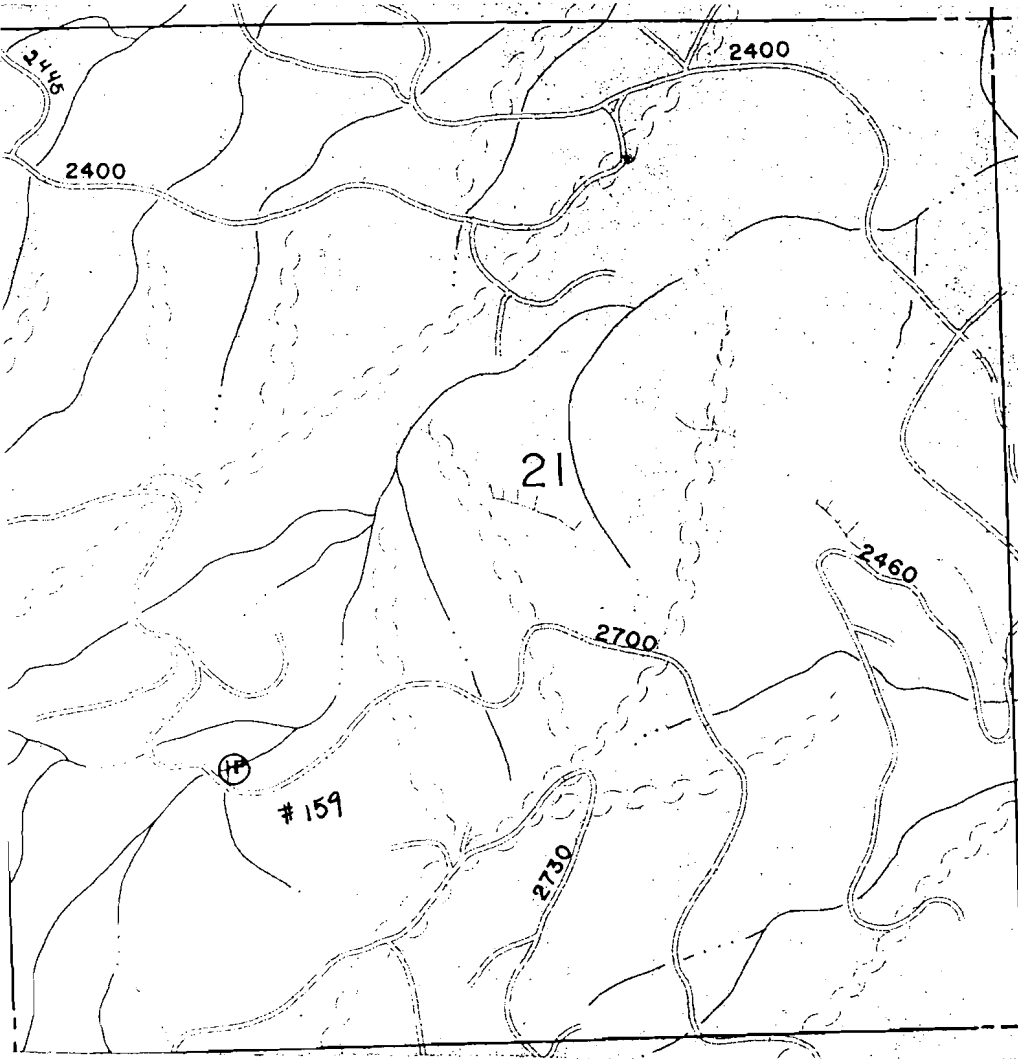

1 N↑

Map Scale: 1" = 1000 feet

Section 21

Township 15S

Range 2E

Forty NW 1/4 SW 1/4

River Basin Calapooia

Upper Willamette

RECEIVED

DEC 20 1994

WATER RESOURCES DEPT.
SALEM, OREGON

Gallons of Water Stored: 40,000

Purpose of Impounded Water:

1. Emergency Fire Suppression

2. _____

Application No. R-75707
Permit No.

Weyerhaeuser Company
Willamette Timberlands


CERTIFICATE NO. 69733

RECEIVED

DEC 20 1994

WATER RESOURCES DEPT.
SALEM, OREGON

Water Storage Site Map

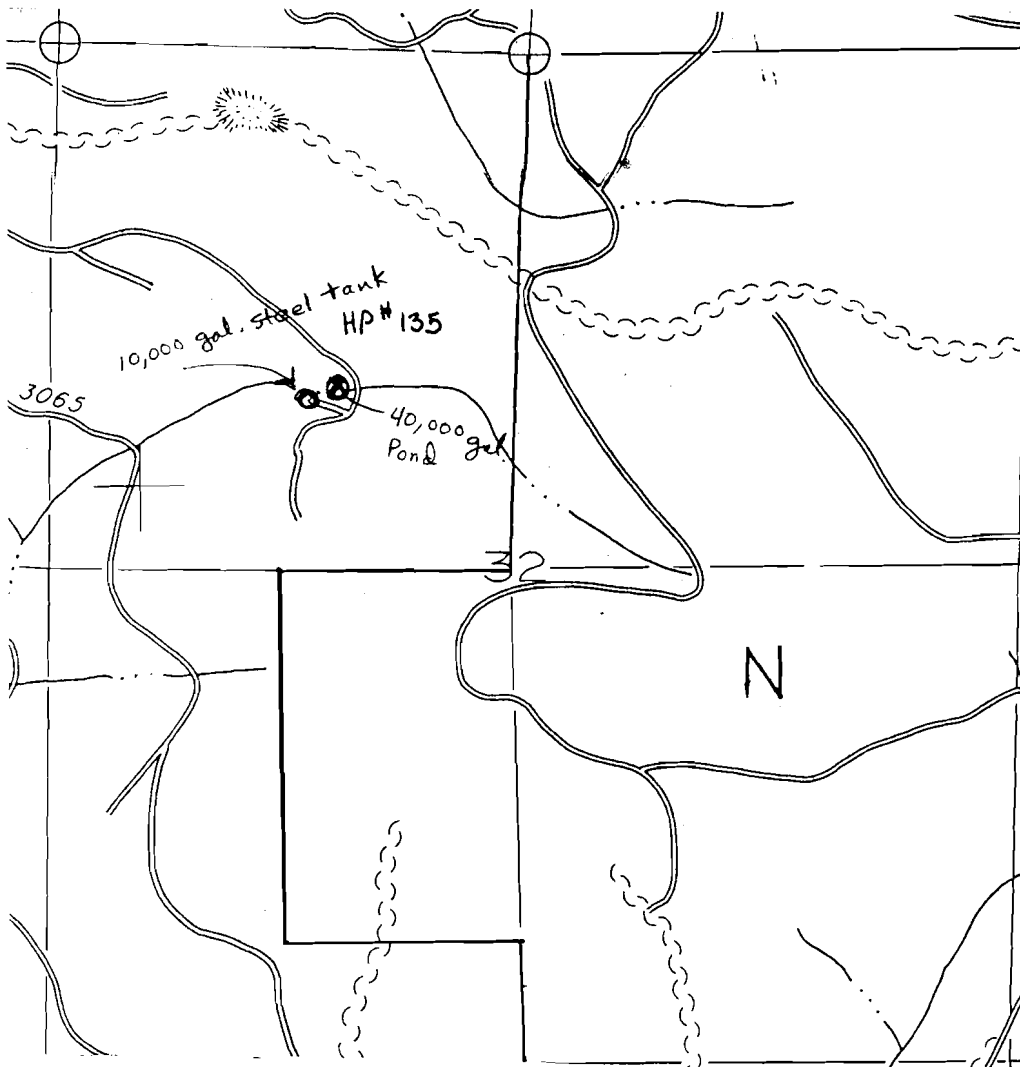

Gallons of Water Stored: ~~10,000~~ 40,000

Purpose of Impounded Water:

1. Emergency Fire Suppression

2. _____

Application No. R-75707
Permit No.

Weyerhaeuser Company
Willamette Timberlands


"CERTIFICATE NO. 69733"

RECEIVED

DEC 20 1994

WATER RESOURCES DEPT.
SALEM, OREGON

Water Storage Site Map

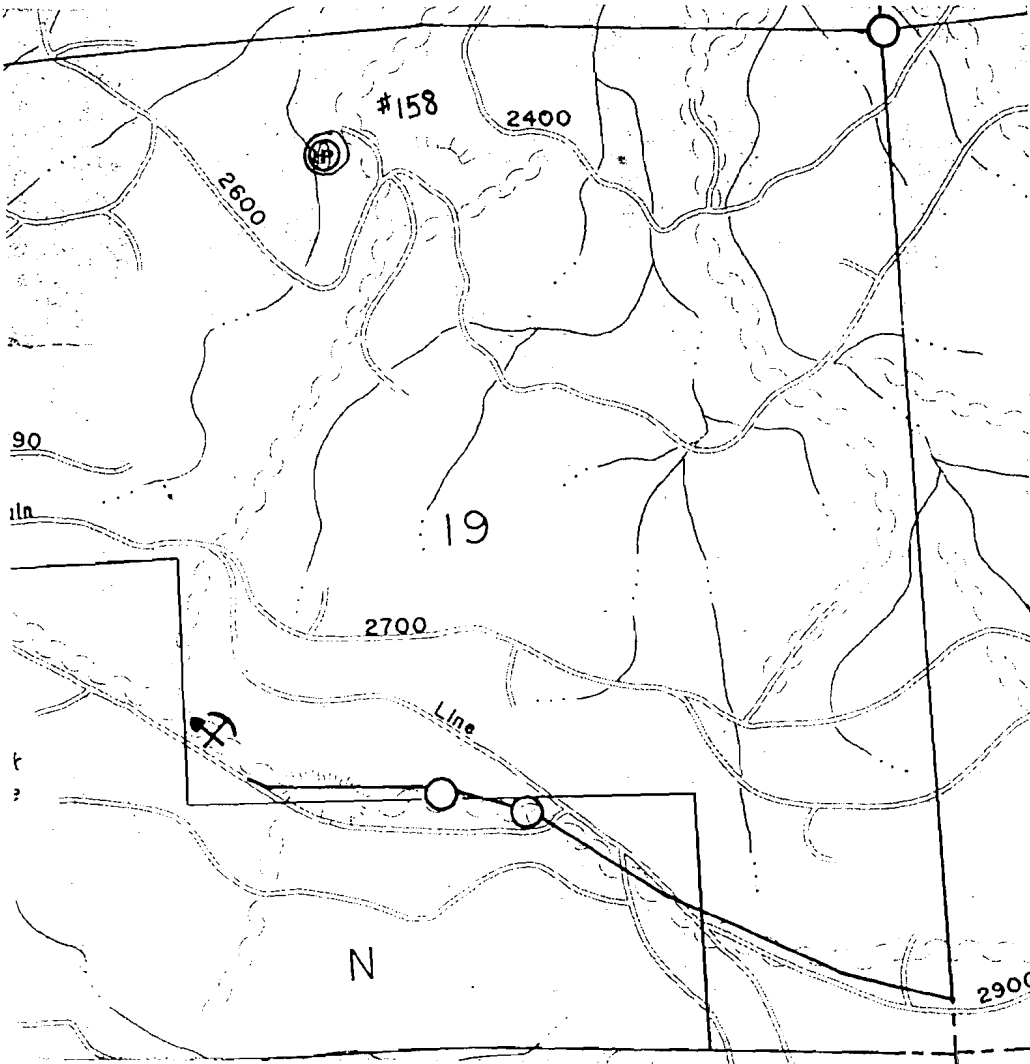

3 N↑

Map Scale: 1" = 1000 feet

Section 19

Township 15S

Range 2E

Forty NE 1/4, NW 1/4

River Basin Calapooia

Upper Willamette

Gallons of Water Stored: 200,000

Purpose of Impounded Water:

1. Emergency Fire Suppression

2. _____

Application No. R-75707

Permit No.

"CERTIFICATE NO. 69733"


Weyerhaeuser Company
Willamette Timberlands

RECEIVED

DEC 20 1994

WATER RESOURCES DEPT.
SALEM, OREGON

Water Storage Site Map

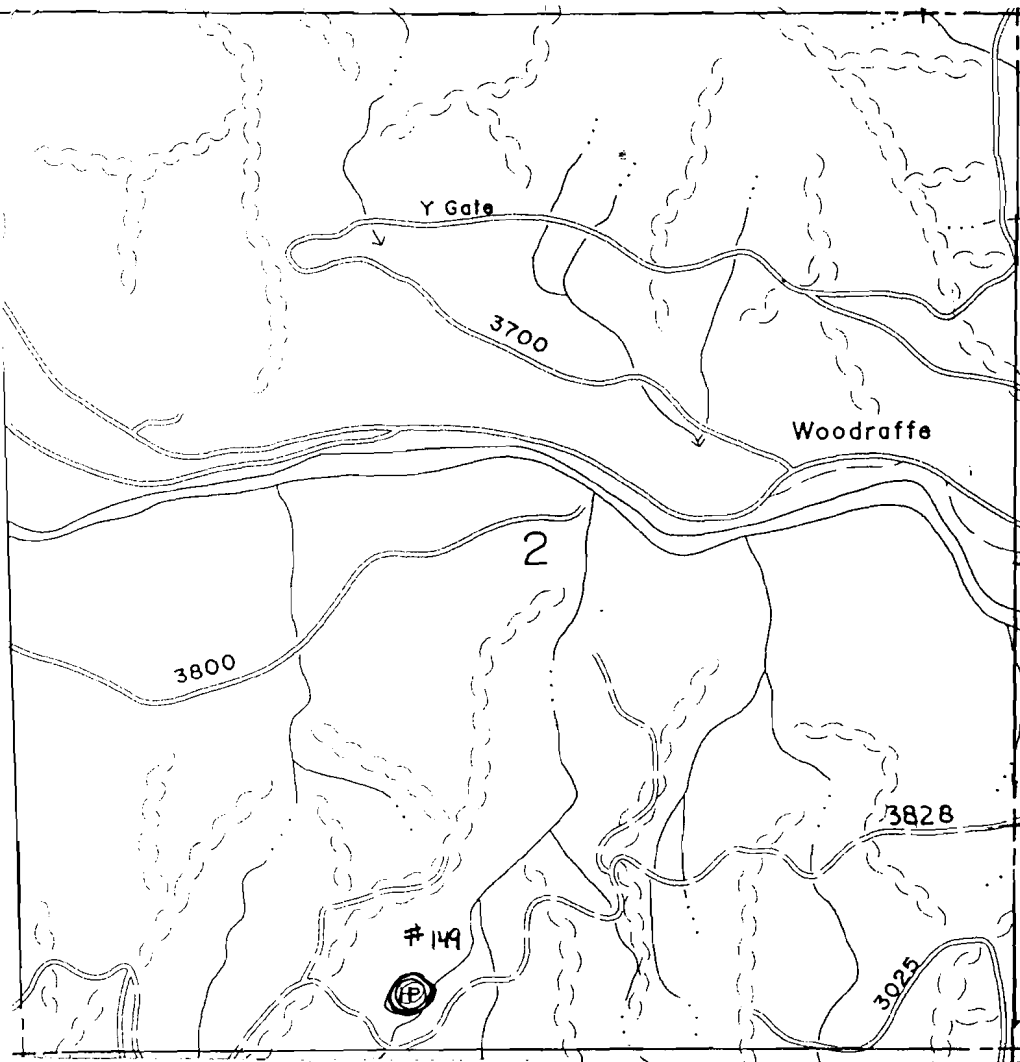

H N↑

Map Scale: 1" = 1000 feet

Section 2

Township 15S

Range 1E

Forty SE 1/4, SW 1/4

River Basin Calapooia

Upper Willamette

Gallons of Water Stored: 91,000

Purpose of Impounded Water:

1. Emergency Fire Suppression

2. _____

Application No. R-75707

Permit No.

"CERTIFICATE NO.

69733

Weyerhaeuser Company
Willamette Timberlands

Water Storage Site Map

RECEIVED

DEC 20 1994

WATER RESOURCES DEPT.
SALEM, OREGON



Map Scale: 1" = 1000 feet


Section 24

Township 15 South

Range 3 East

Forty NW 1/4 NE 1/4

River Basin Calapooia Rv.
(Upper Willamette)

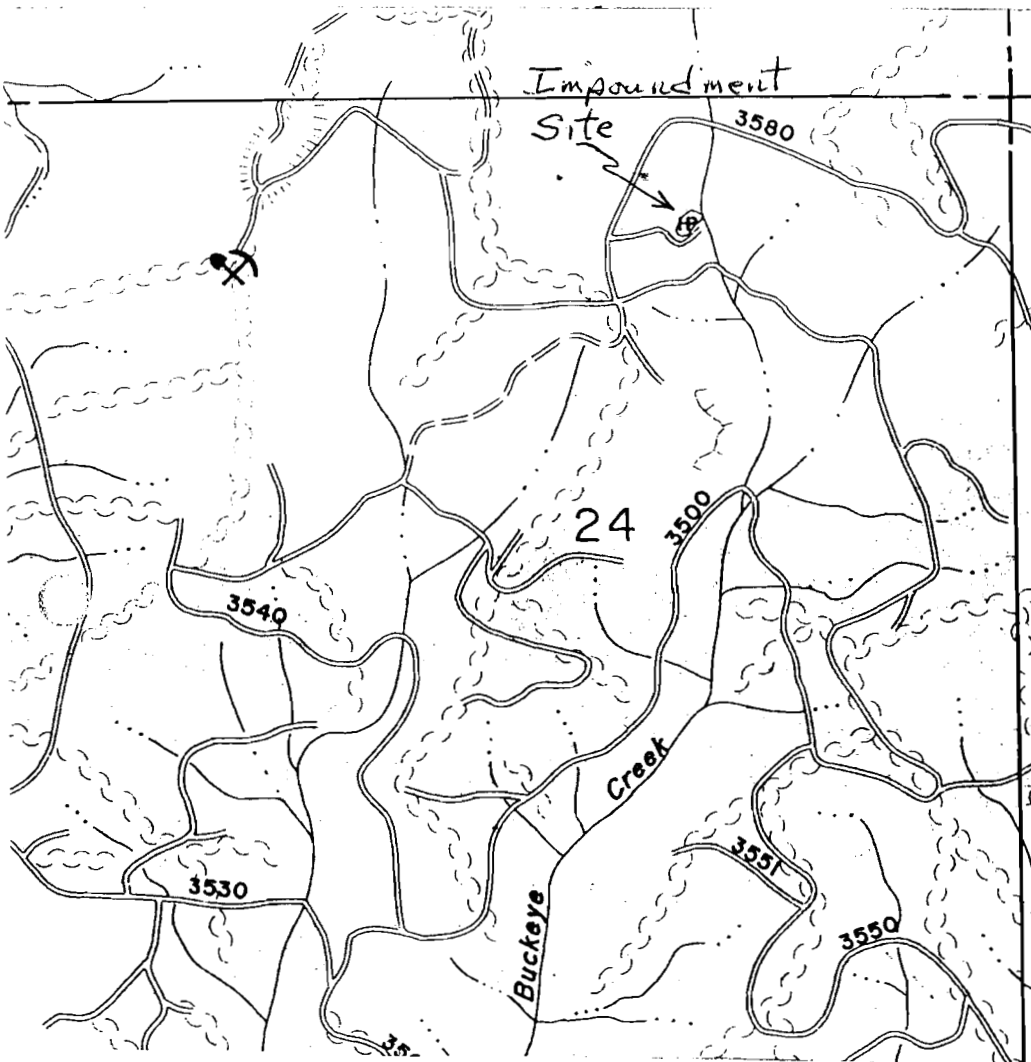

Gallons of Water Stored: 325,000

Purpose of Impounded Water:

1. Emergency Fire Suppression
2. Aerial Herbicide Application Water Supply

Application No.
Permit No.

R-75767

"CERTIFICATE NO."
Weyerhaeuser Company
Willamette Timberlands

69733

RECEIVED

DEC 20 1994

WATER RESOURCES DEPT.
SALEM, OREGON

Water Storage Site Map

6 N ↑

Map Scale: 1" = 1000 feet


Section 36

Township 15 South

Range 3 East

Forty NW 1/4 SE 1/4
SW 1/4 NE 1/4

River Basin Calapooia R.
(Upper Willamette)

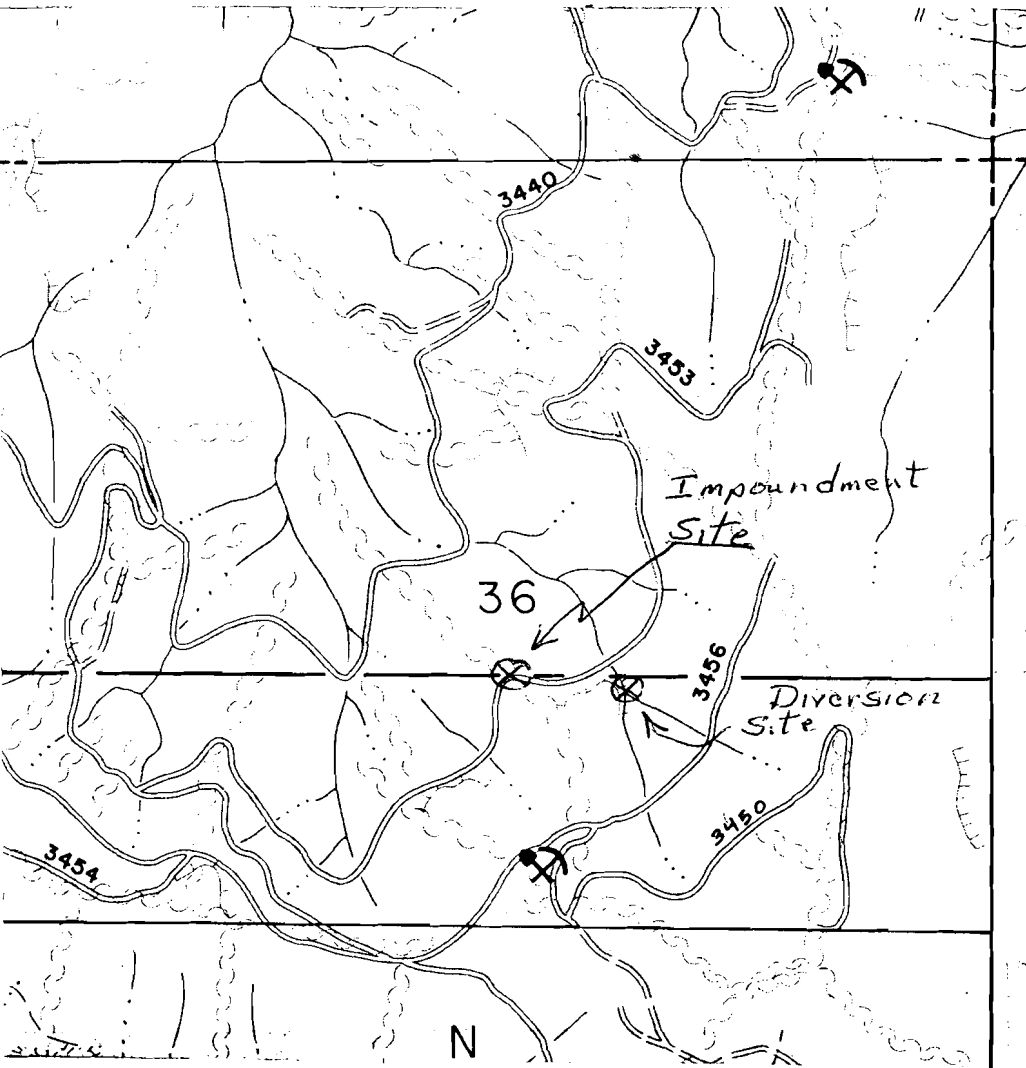

Gallons of Water Stored: 10,000

Purpose of Impounded Water:

1. Emergency Fire Suppression
2. _____

Application No. R-75707

Permit No.

"CERTIFICATE NO.

69733


Weyerhaeuser Company
Willamette Timberlands

RECEIVED

DEC 20 1994

Water Storage Site Map

WATER RESOURCES DEPT.
SALEM, OREGON

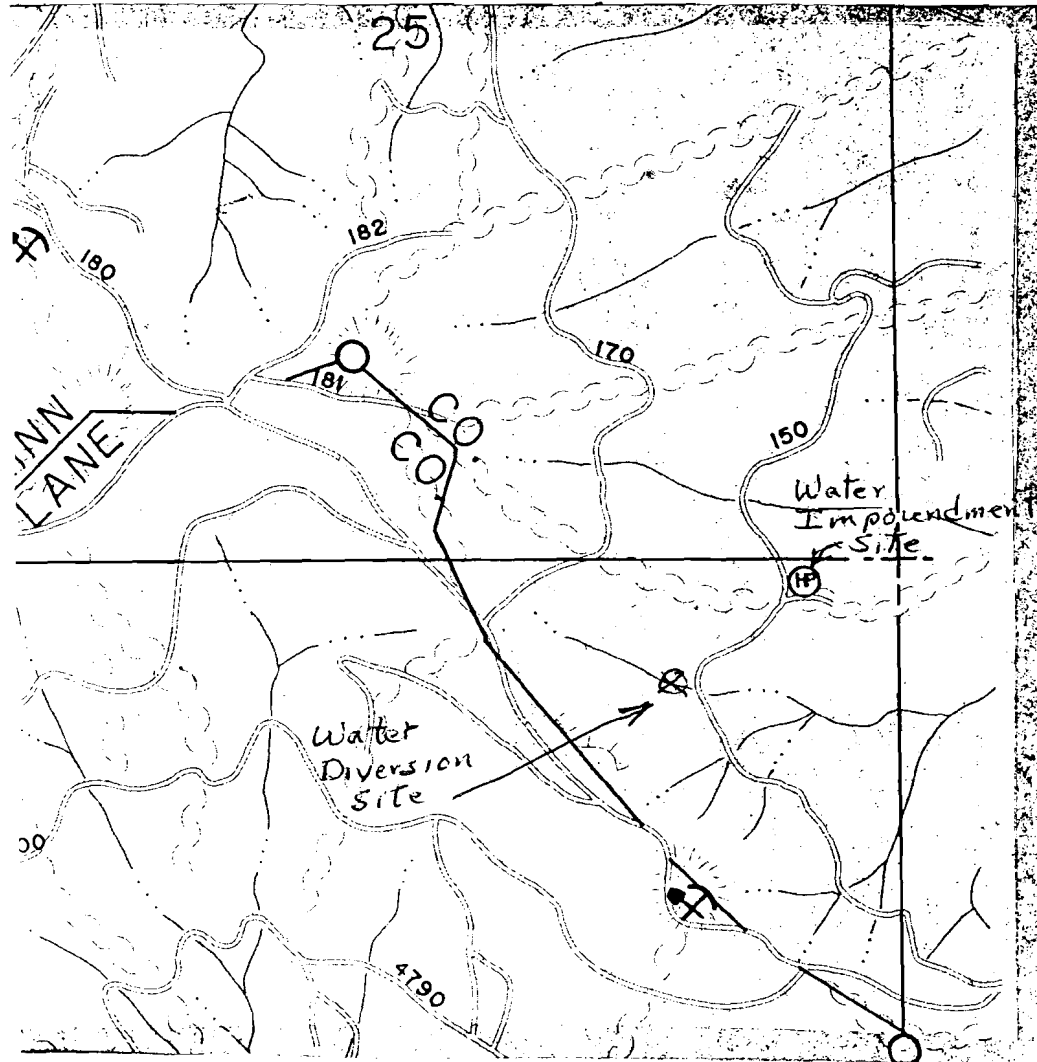

↑ N

Map Scale: 1" = 1000 feet

Section 36

Township 15 South

Range 2 East

Forty NE 1/4 NE 1/4

River Basin Calapooia Riv.
(Upper Willamette)

Gallons of Water Stored: 25,000

Purpose of Impounded Water:

1. Emergency Fire Suppression

2. _____

Application No. R-75707
Permit No.

Weyerhaeuser Company
Willamette Timberlands

"CERTIFICATE NO. 69733"

Water Storage Site Map

RECEIVED

DEC 20 1994

WATER RESOURCES DEPT.
SALEM, OREGON

4 N↑

Map Scale: 1" = 1000 feet


Section 27

Township 15 South

Range 3 East

Forty SE 1/4 SE 1/4

River Basin Calapooia R.
(Upper Willamette)

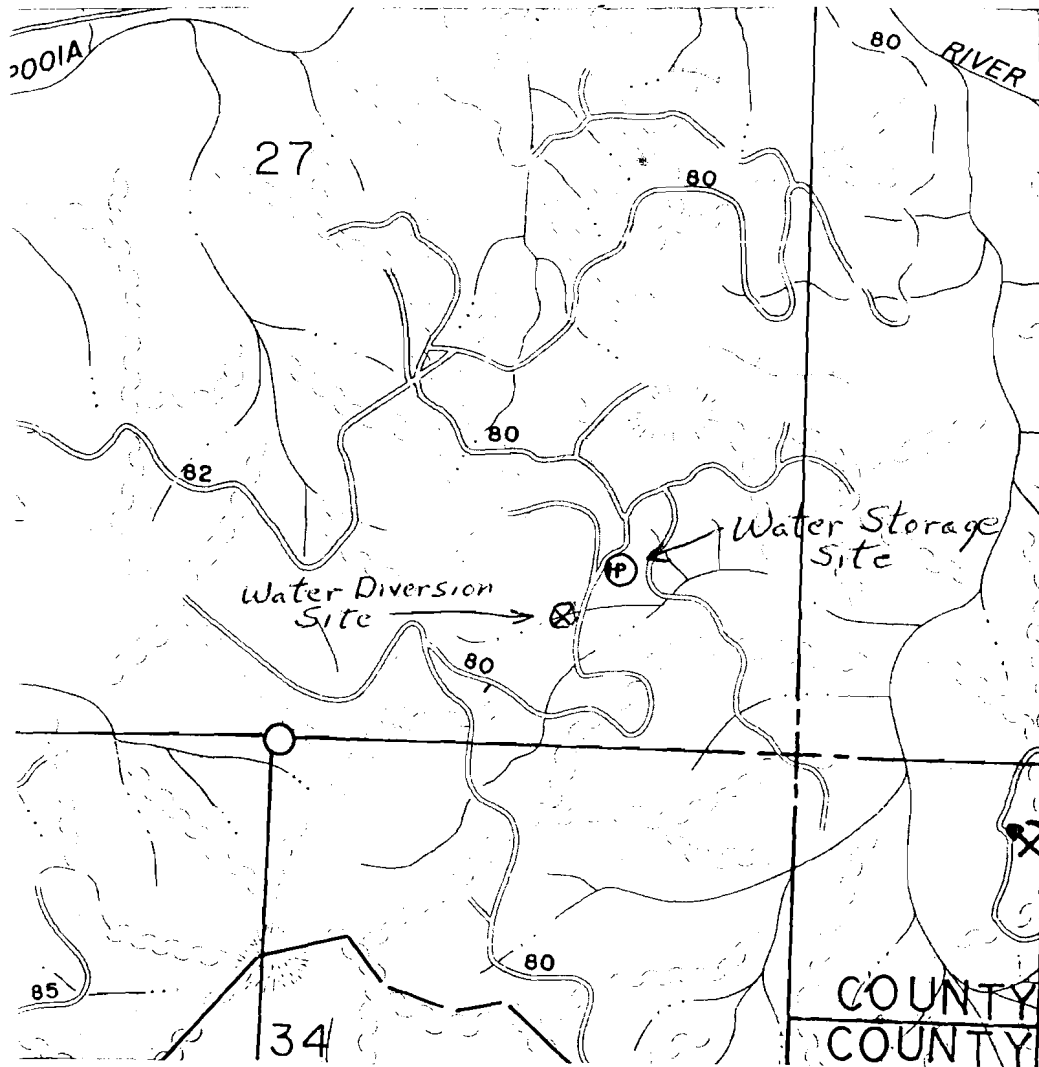

Gallons of Water Stored: 10,000

Purpose of Impounded Water:

1. Emergency Fire Suppression
2. _____

Application No 75707
Permit No.

~~"CERTIFICATE NO. 69733"~~
Weyerhaeuser Company
Willamette Timberlands

Water Storage Site Map

RECEIVED

DEC 20 1994

WATER RESOURCES DEPT.
SALEM, OREGON

9 N↑

Map Scale: 1" = 1000 feet


Section 21

Township 15 South

Range 3 East

Forty SW 1/4 NE 1/4

River Basin Calapooia R.
(Upper Willamette)

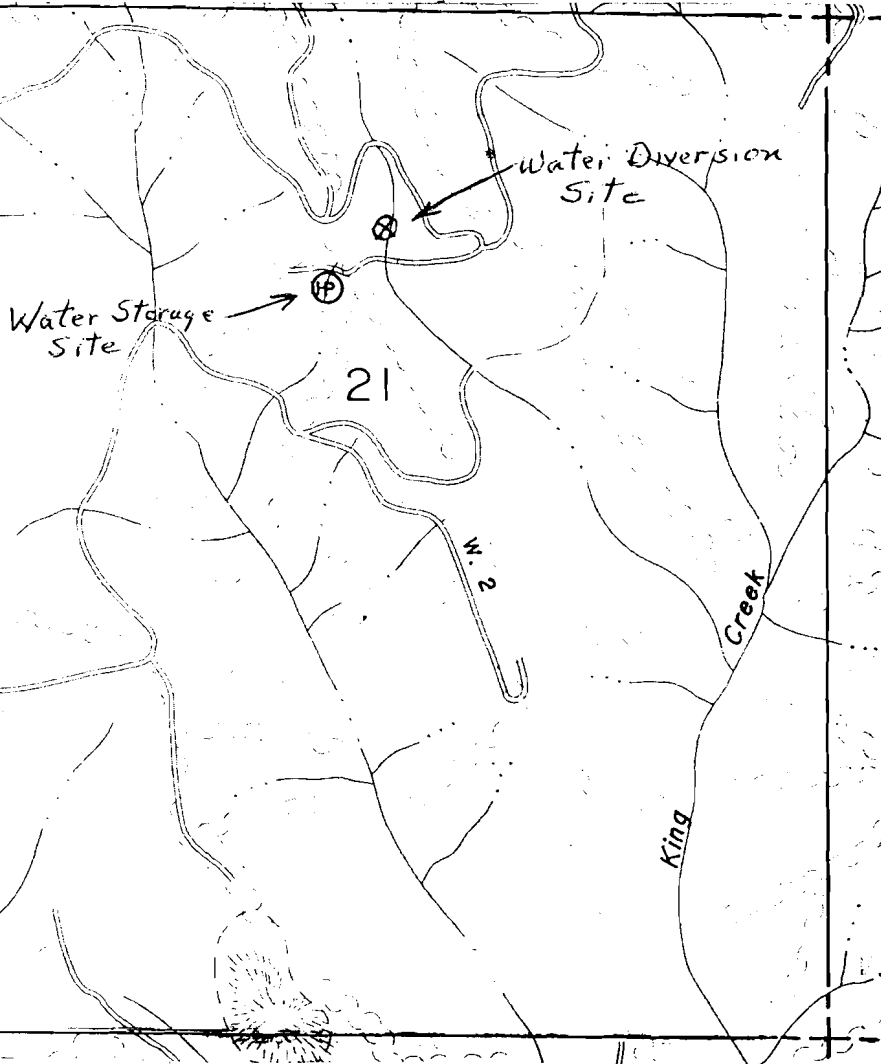

Gallons of Water Stored: 10,000

Purpose of Impounded Water:

1. Emergency Fire Suppression
2. _____


Application No 75707

Permit No. 69733

"CERTIFICATE NO.

Weyerhaeuser Company
Willamette Timberlands

Water Storage Site Map

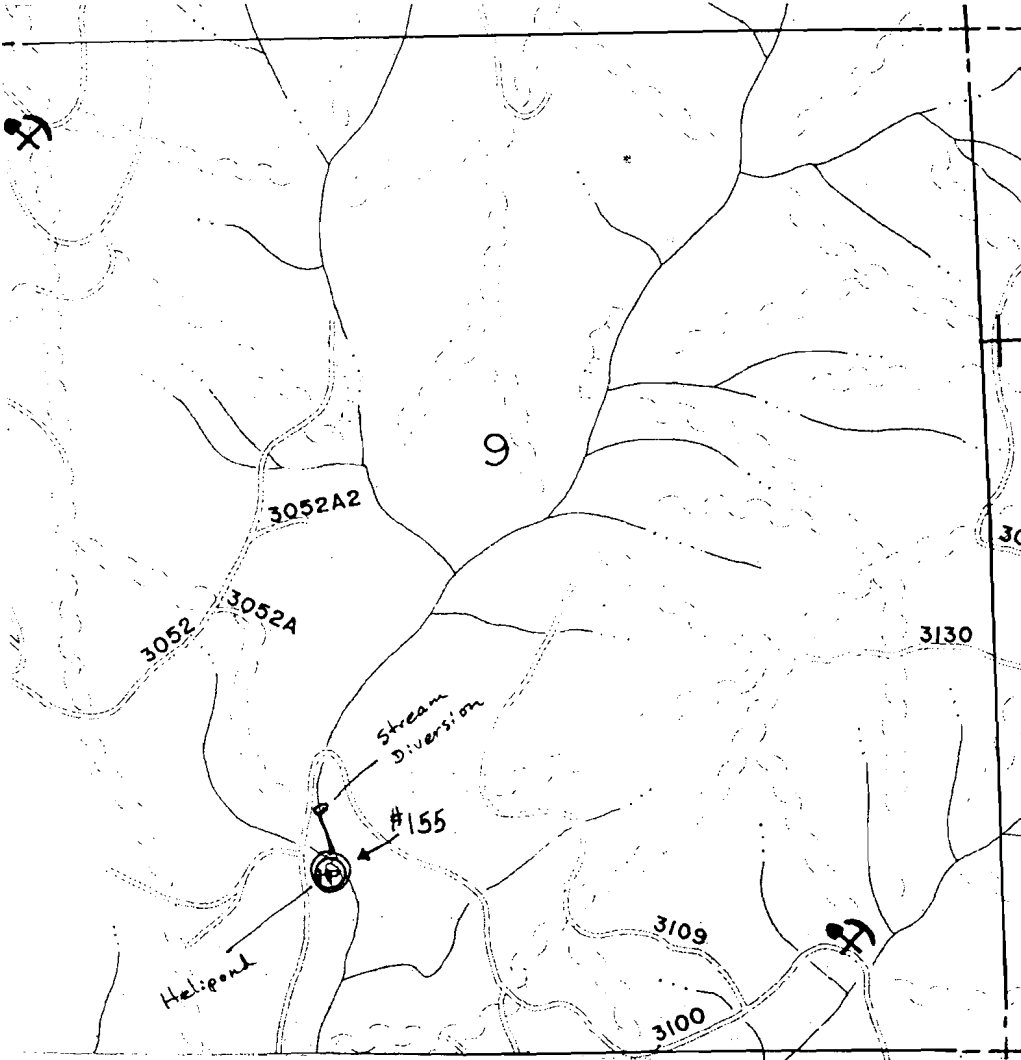

10 N↑

Map Scale: 1" = 1000 feet

Section 9

Township 15S

Range 2E

Forty SE 1/4, SW 1/4

River Basin South Sanham

RECEIVED

DEC 20 1994

WATER RESOURCES DEPT.
SALEM, OREGON

Gallons of Water Stored: ~~63,000~~ 199,000

Purpose of Impounded Water:

1. Emergency Fire Suppression

2. _____