

Application No. R-75708
Permit No.

Weyerhaeuser Company
Willamette Timberlands

CERTIFICATE NO. 69734

RECEIVED

DEC 20 1994

WATER RESOURCES DIVISION
SALEM, OREGON

1 N↑

Map Scale: 1" = 1000 feet


Section 36

Township 16S

Range 1W

Forty SE 1/4, SW 1/4

River Basin McKenzie

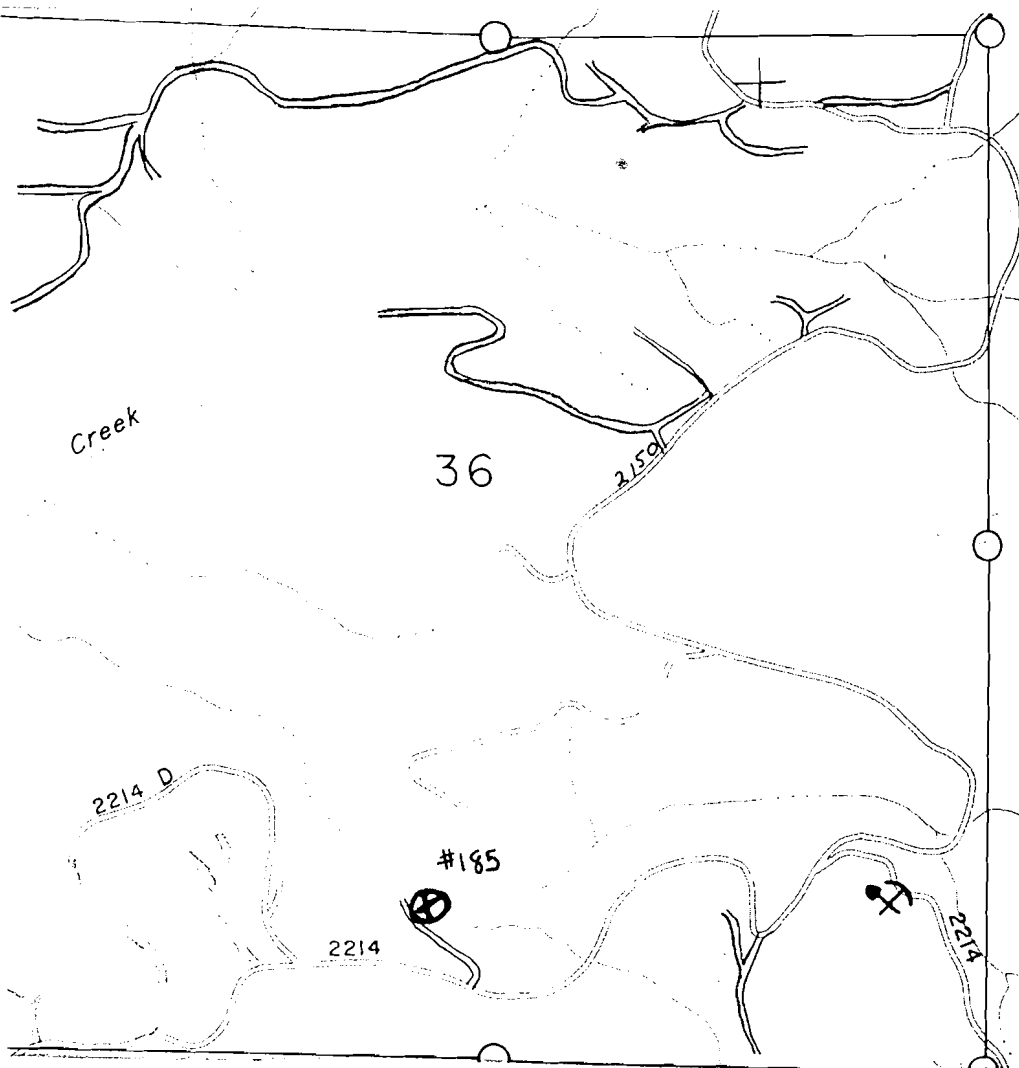

Gallons of Water Stored: 66,000

Purpose of Impounded Water:

① Emergency Fire Suppression

2. _____

Application No. 75708

Permit No.

69734

"CERTIFICATE NO. _____"

Weyerhaeuser Company

Willamette Timberlands

Water Storage Site Map

RECEIVED

DEC 20 1994

WATER
SALEM, OREGON

N↑

Map Scale: 1" = 1000 feet


Section 24

Township 16S

Range 1E

Forty NE 1/4, SW 1/4

River Basin McKenzie

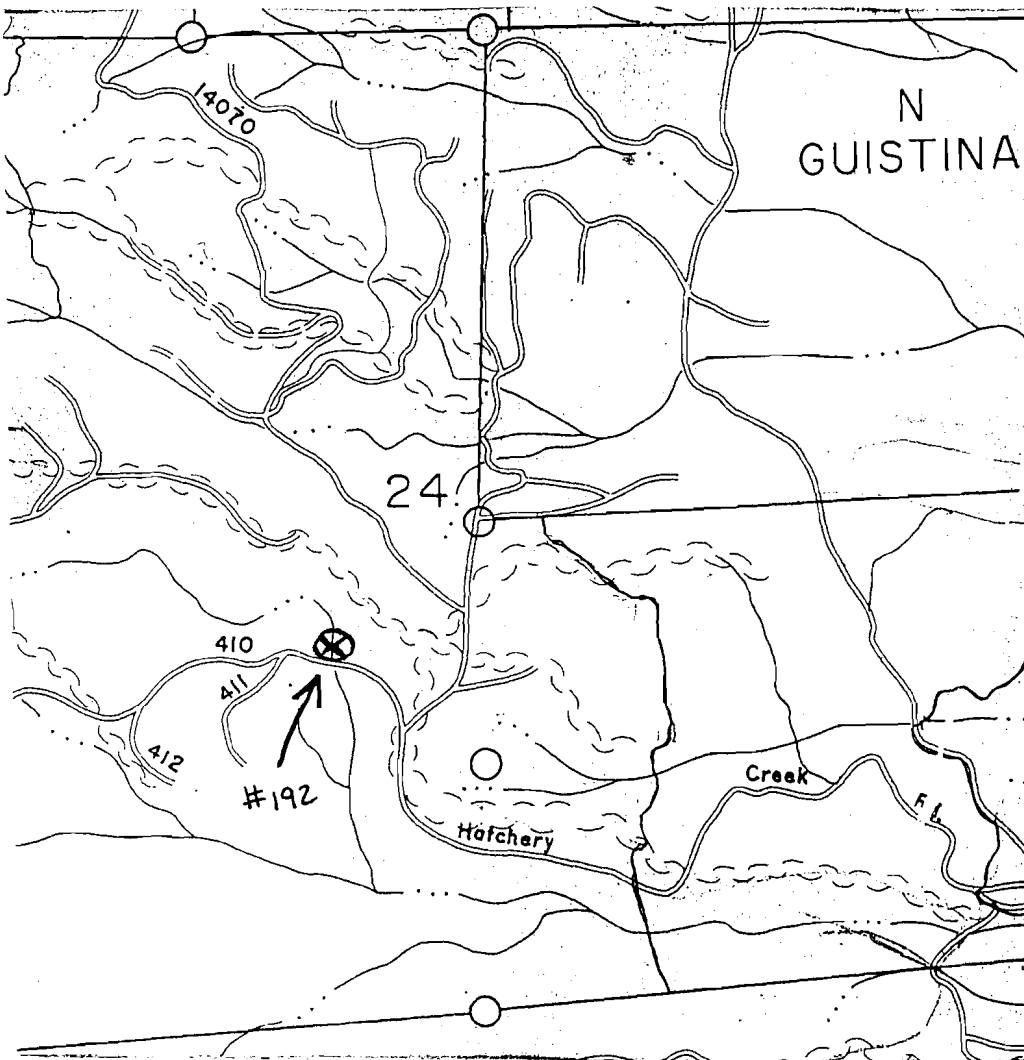

24"

Gallons of Water Stored: 67,500

Purpose of Impounded Water:

1. Emergency Fire Suppression
2. water source for herbicide spray

Application No. R-750708

Permit No.

Weyerhaeuser Company

Willamette Timberlands "CERTIFICATE NO. 69734"

RECEIVED

Water Storage Site Map

DEC 20 1994

WA. DEPT.
SALEM, OREGON

3 N↑

Map Scale: 1" = 1000 feet


Section 34

Township 16S

Range 1W

Forty SW 1/4, SE 1/4

River Basin McKenzie

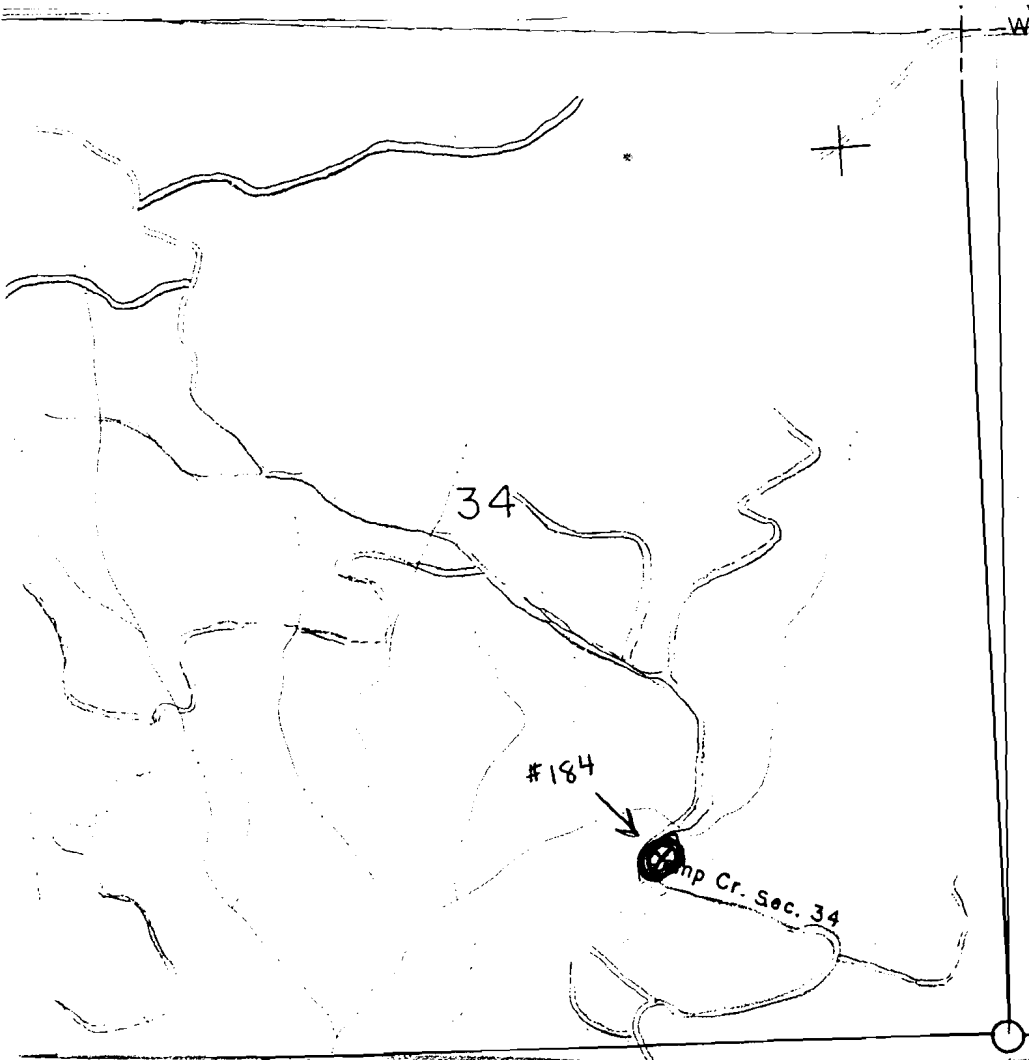

Gallons of Water Stored: 55,000

Purpose of Impounded Water:

1. Emergency Fire Suppression
2. Water source for herbicide spray

Application No. 75708
Permit No.

Weyerhaeuser Company

Willamette Timberlands CERTIFICATE NO. 69734

Water Storage Site Map

RECEIVED

DEC 20 1994

WATER RESOURCES DEPT.
SALEM, OREGON

4 N↑

Map Scale: 1" = 1000 feet


Section 24

Township 16S

Range 1W

Forty NW 1/4, NW 1/4

River Basin McKenzie

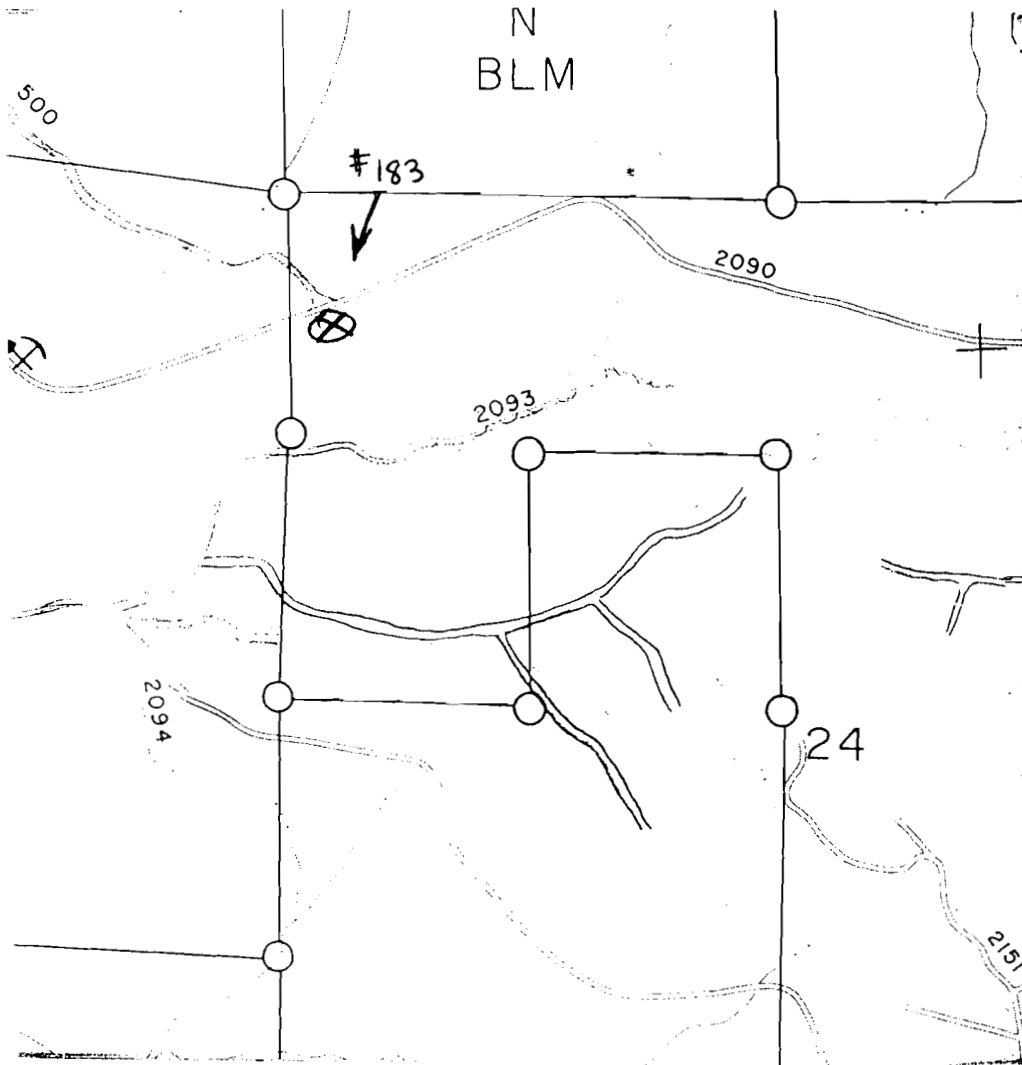

Gallons of Water Stored: 24,000

Purpose of Impounded Water:

① Emergency Fire Suppression

2. _____

Application No. R-75708
Permit No.

Weyerhaeuser Company
Willamette Timberlands


CERTIFICATE NO. 69734

RECEIVED

DEC 20 1994

WATER RESOURCES DEPT.
SALEM, OREGON

Water Storage Site Map

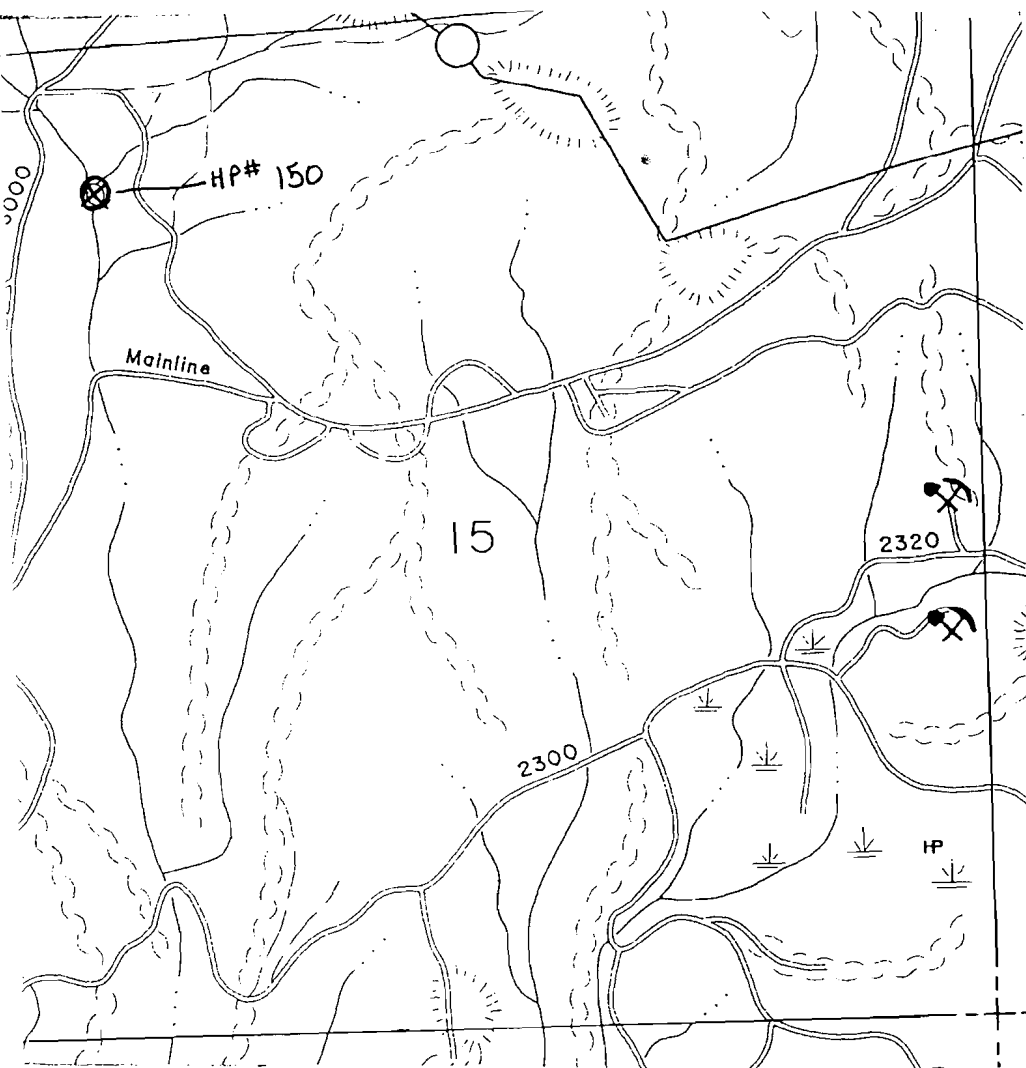

Map Scale: 1" = 1000 feet

Section 15

Township 15S

Range 1E

Forty NW 1/4, NW 1/4

River Basin McKenzie

Gallons of Water Stored: 350,000

Purpose of Impounded Water:

1. Emergency Fire Suppression

2.

Application No. R-75708

Permit No.

Weyerhaeuser Company
Willamette Timberlands

"CERTIFICATE NO.

69734

"

Water Storage Site Map

RECEIVED

DEC 20 1994

WATER RESOURCES DEPT.
SALEM, OREGON

6 N↑

Map Scale: 1" = 1000 feet


Section 13

Township 15S

Range 1W

Forty SE 1/4, SE 1/4

River Basin McKenzie

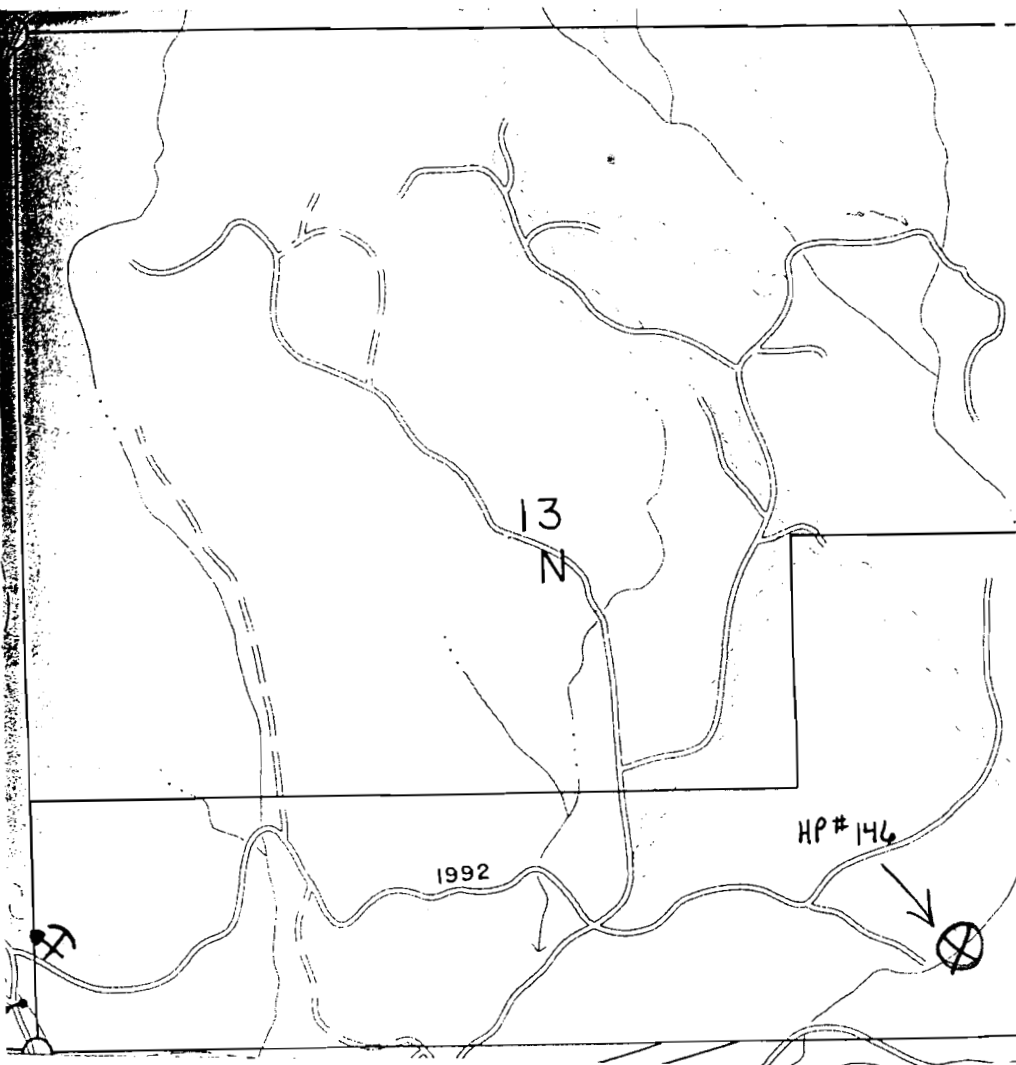

Gallons of Water Stored: 135,000

Purpose of Impounded Water:

1. Emergency Fire Suppression

2. _____

Permit No.
Weyerhaeuser Company
Willamette Timberlands

RECEIVED

WATER RESOURCES DEPT.
SALEM, OREGON

7 N↑


Section 14

Township 16 South

Range 2 East

Forty NW $\frac{1}{4}$ SE $\frac{1}{4}$

River Basin McKenzie
River

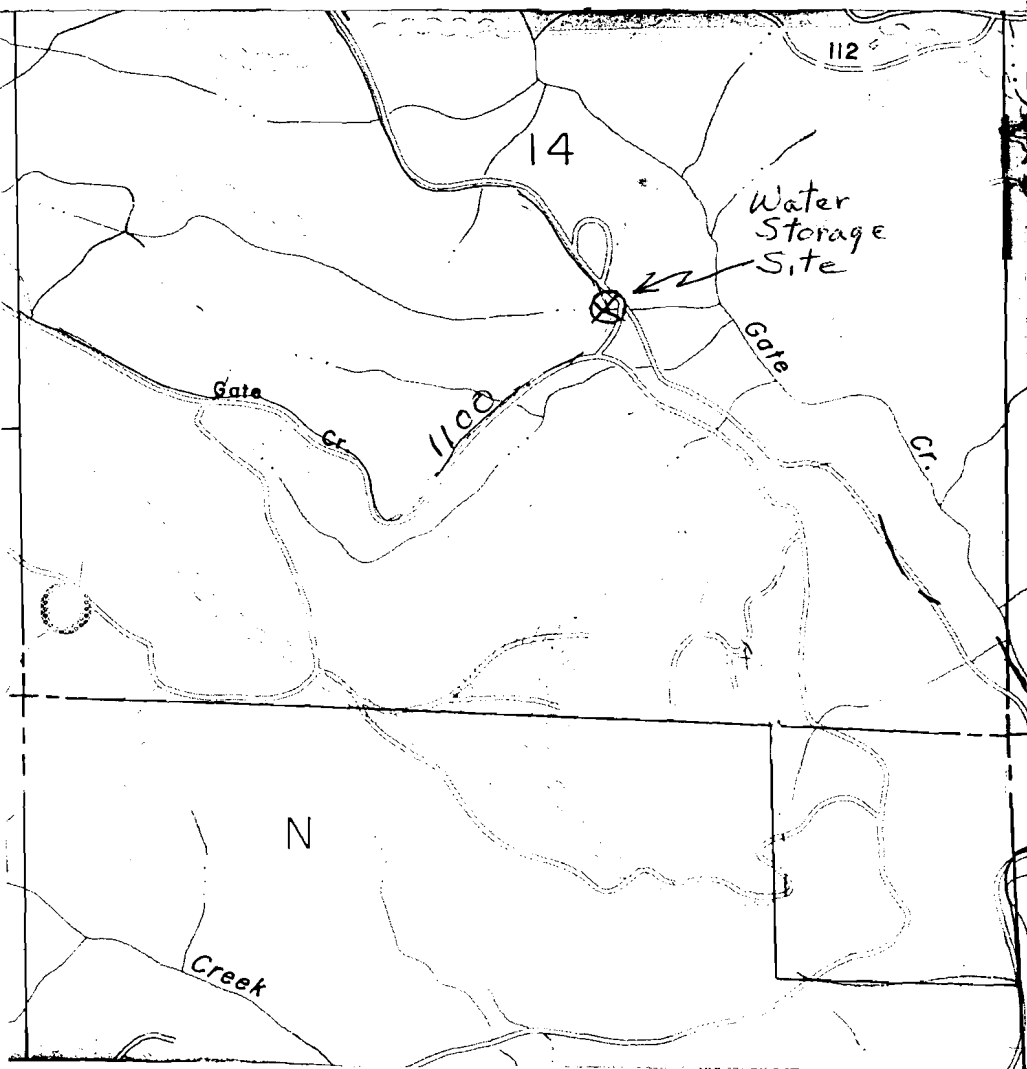

Gallons of Water Stored: 30,000

1. Emergency Fire Suppression


2. _____

Application No. R-15708
Permit No.

Weyerhaeuser Company
Willamette Timberlands

CERTIFICATE NO. 69734

Water Storage Site Map

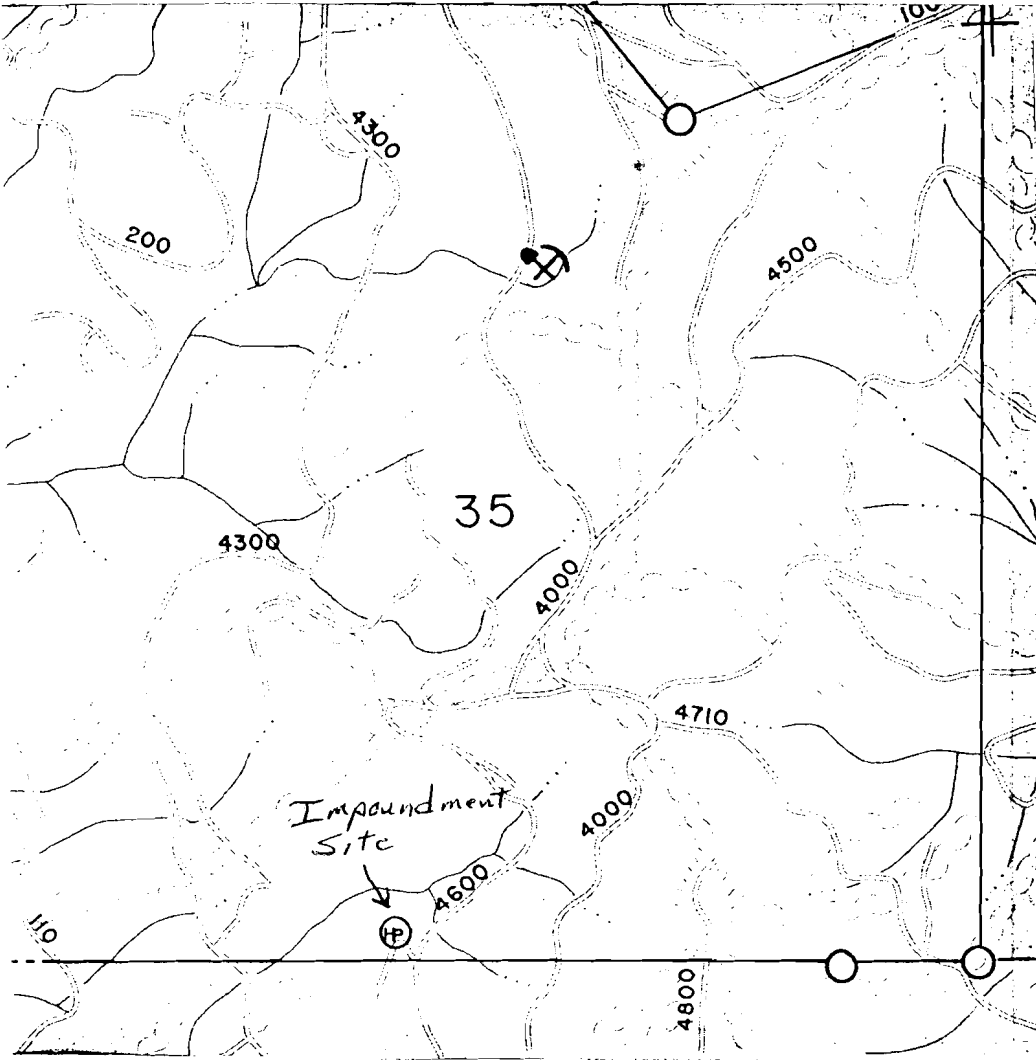

4 N↑

Map Scale: 1" = 1000 feet

Section 35

Township 15 South

Range 2 East

Forty SE 1/4 SW 1/4

River Basin McKenzie
River

RECEIVED

DEC 20 1994

WATER RESOURCES DEPT.
SALEM, OREGON

Gallons of Water Stored: 5,000

Purpose of Impounded Water:

1. Emergency Fire Suppression
2. _____


Application No. 12-75708
Permit No.

69734

Weyerhaeuser Company
Willamette Timberlands

CERTIFICATE NO. _____

Water Storage Site Map

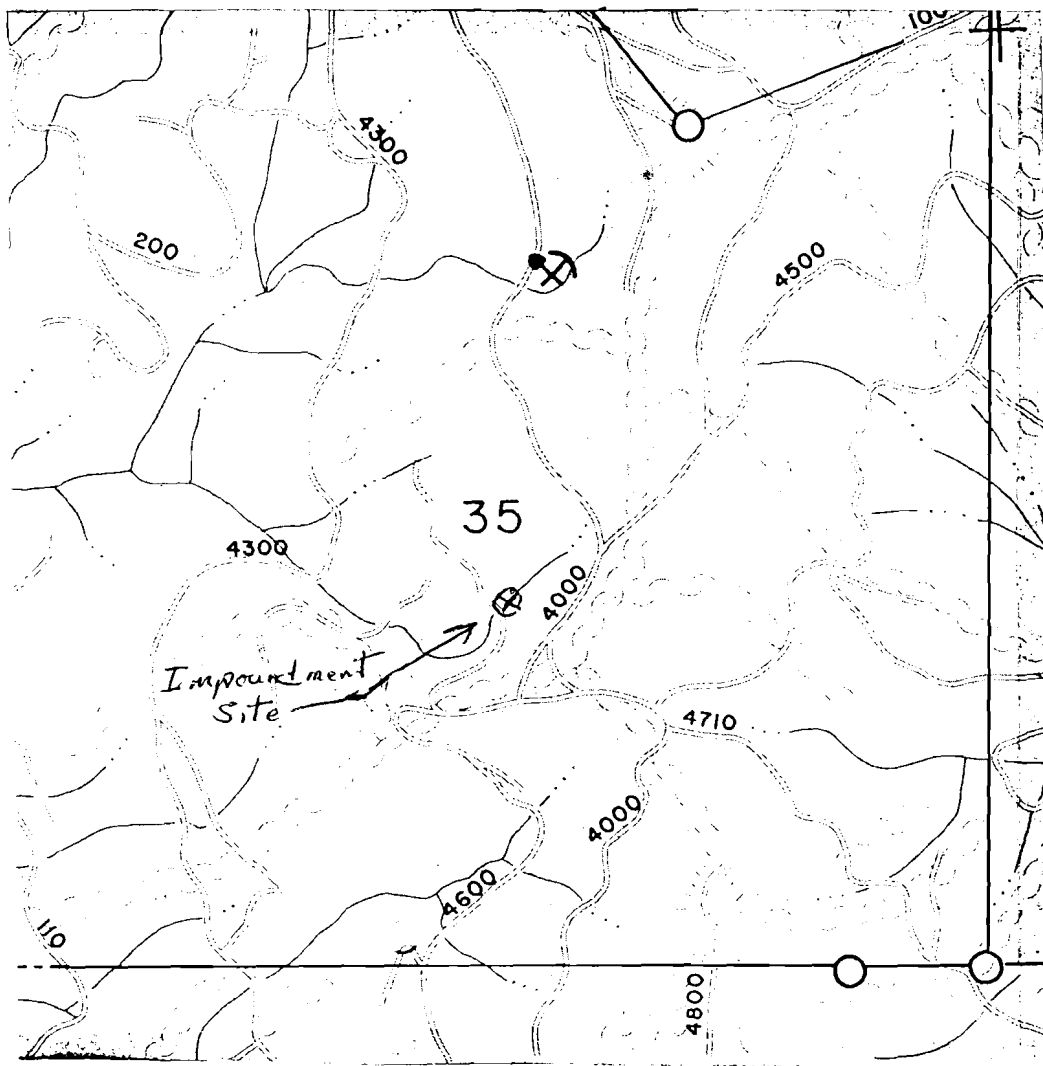

9 N↑

Map Scale: 1" = 1000 feet

Section 35

Township 15 South

Range 2 East

Forty NE¹/₄ SW¹/₄

River Basin McKenzie

River

RECEIVED

DEC 20 1994

WATER RESOURCES DEPT.
SALEM, OREGON

Gallons of Water Stored: 5,000

Purpose of Impounded Water:

1. Emergency Fire Suppression

2. _____

Application No.

R-75708

Permit No.


Weyerhaeuser Company
Willamette Timberlands

"CERTIFICATE NO.

69734

"

Water Storage Site Map

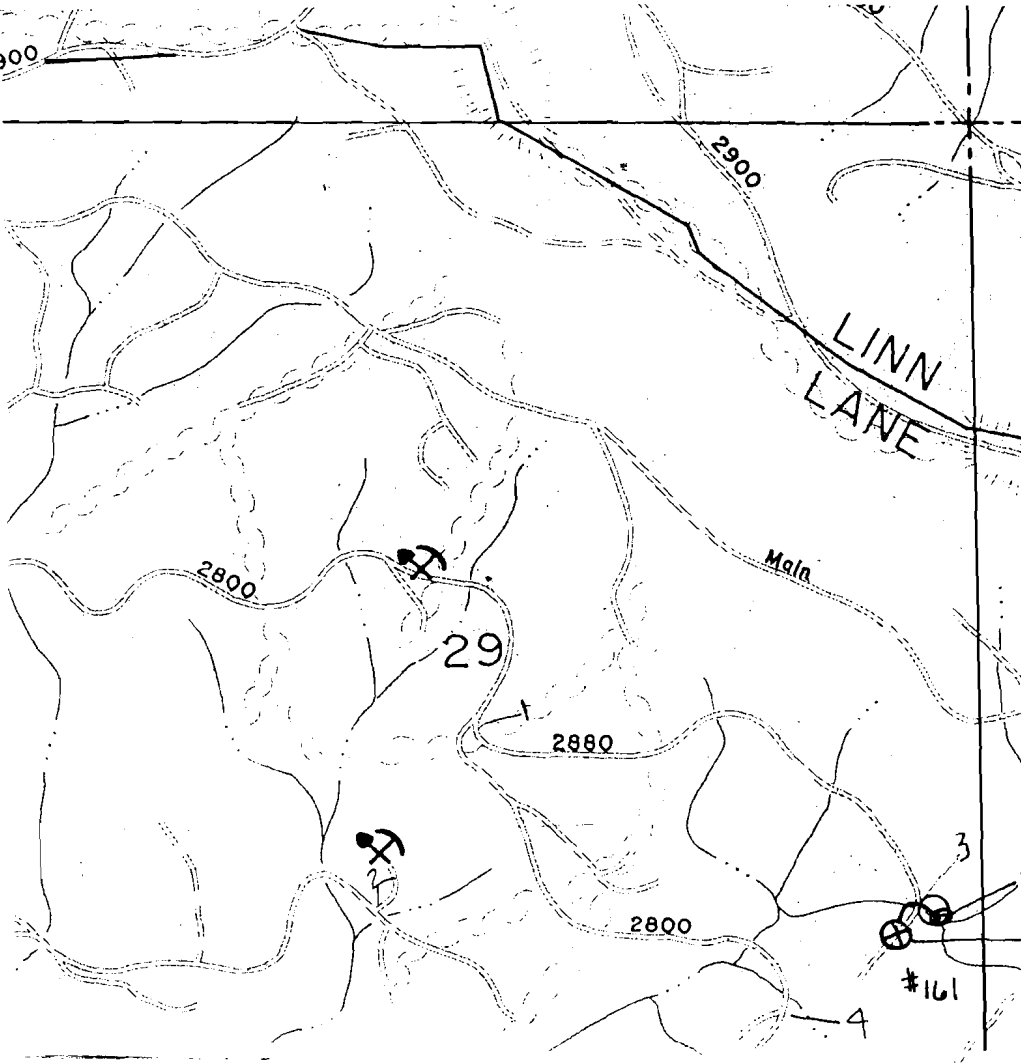

10 N↑

Map Scale: 1" = 1000 feet

Section 29

Township 15S

Range 2E

Forty SE 1/4, SE 1/4

River Basin McKenzie

RECEIVED

DEC 20 1994

WATER RESOURCES DIVISION
SALEM, OREGON

Gallons of Water Stored: 10,000

Purpose of Impounded Water:

① Emergency Fire Suppression

2. _____