

Application No. R-75711

Permit No.

"CERTIFICATE NO. 69737"
Weyerhaeuser Company
Willamette Timberlands

Water Storage Site Map

RECEIVED

DEC 20 1994

WATER RESOURCES DEPT.
SALEM, OREGON

NT

Map Scale: 1" = 1000 feet


Section 19

Township 16S

Range 1E

Forty SW¹/₄, SW¹/₄

River Basin McKenzie

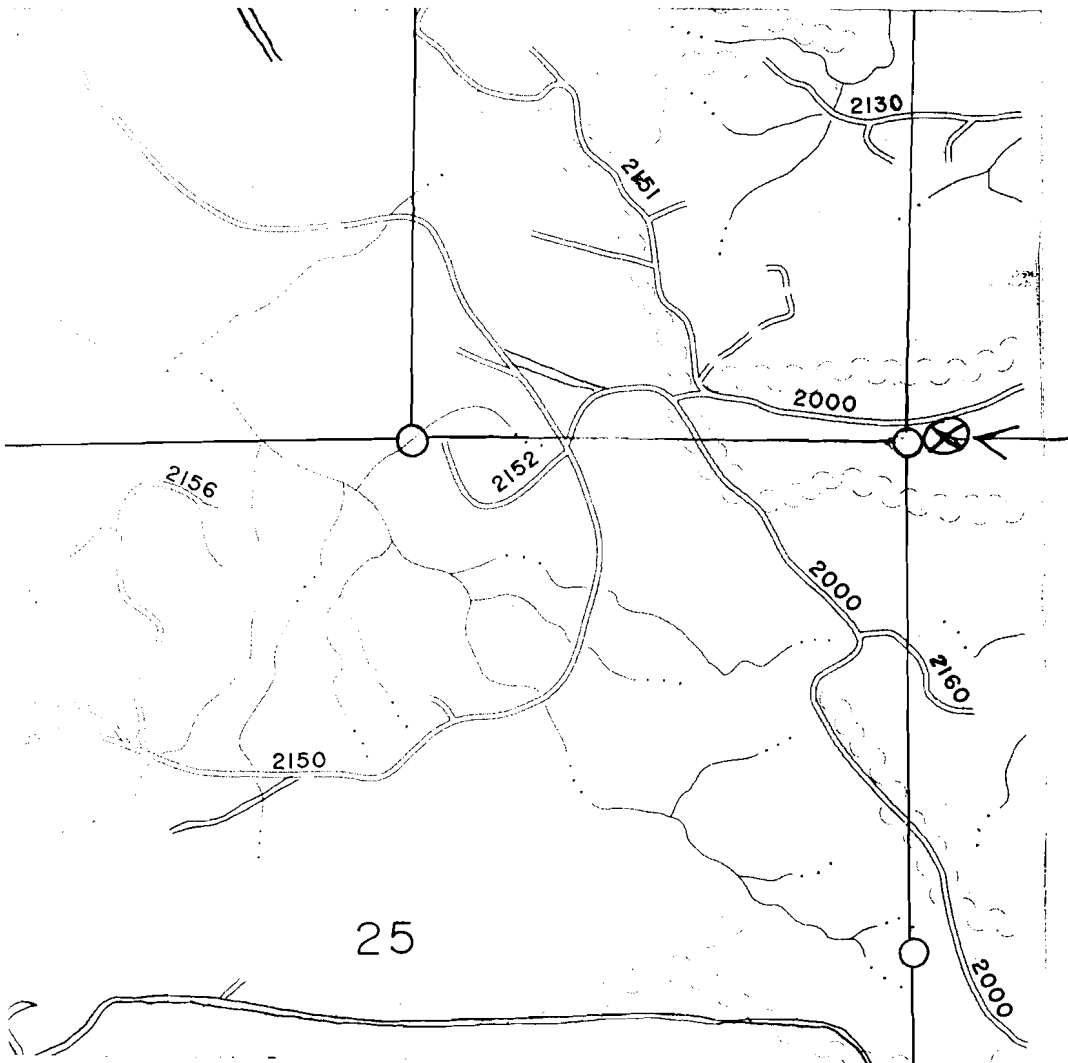

Gallons of Water Stored: 30,000

Purpose of Impounded Water:

1. Emergency Fire Suppression
2. water source for herbicide spray

Application No. R-75711

Permit No.

Weyerhaeuser Company
Willamette Timberlands

CERTIFICATE NO.

69737

RECEIVED

DEC 20 1994

WATER DIVISION
SALEM, OREGON

Water Storage Site Map

N↑

Map Scale: 1" = 1000 feet


Section 3

Township 16S

Range 1E

Forty SW 1/4, NW 1/4

River Basin McKenzie

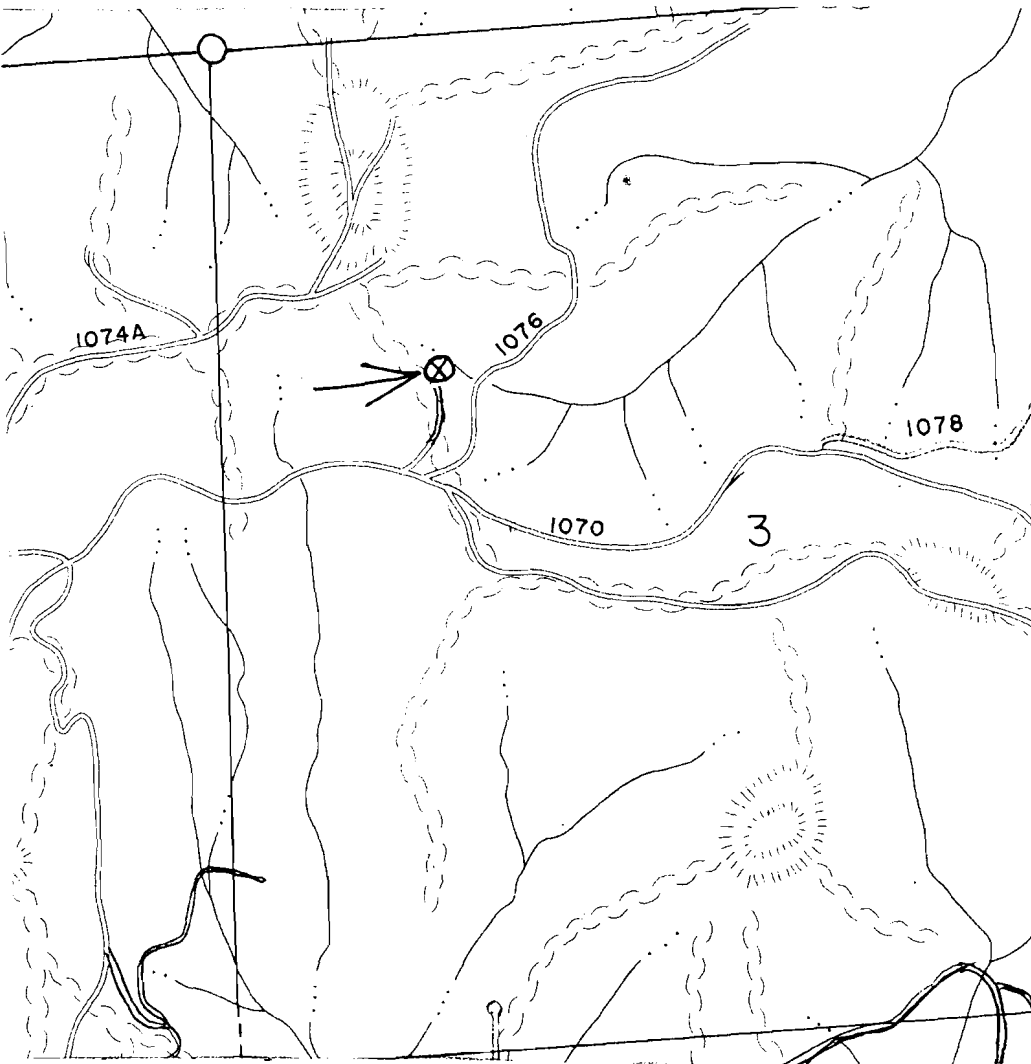

Gallons of Water Stored: 26,000

Purpose of Impounded Water:

1. Emergency Fire Suppression
2. Water source for herbicide spraying

Application No. R-75711
Permit No.

CERTIFICATE NO. 69737
Weyerhaeuser Company
Willamette Timberlands

Water Storage Site Map

RECEIVED

DEC 20 1994

WATER RESOURCES DEPT.
SALEM, OREGON

N↑

Map Scale: 1" = 1000 feet


Section 31

Township 15S

Range 1E

Forty SW 1/4, SW 1/4

River Basin McKenzie

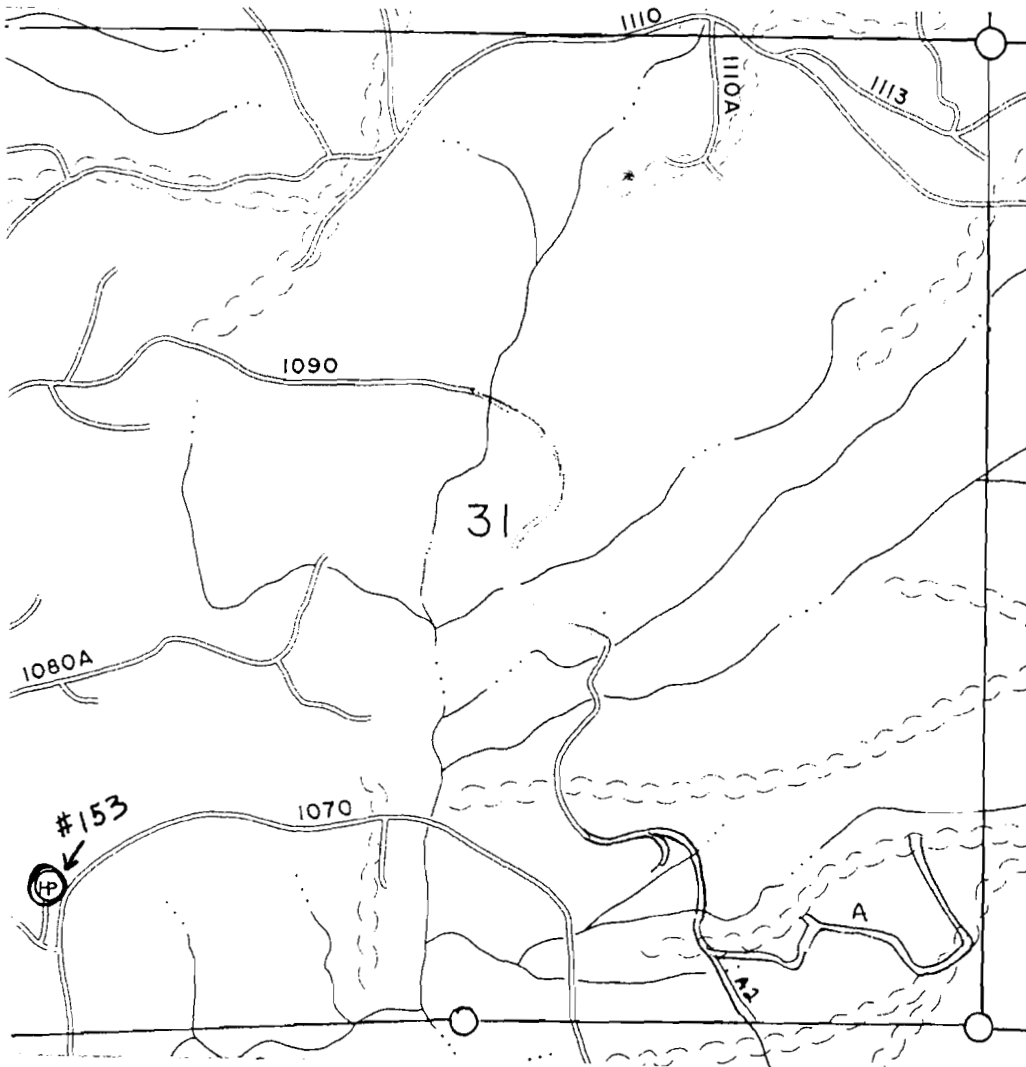

Gallons of Water Stored: 240,000

Purpose of Impounded Water:

1. Emergency Fire Suppression

2. _____

Application No. R-75711
Permit No.

"CERTIFICATE NO. 69737"

Weyerhaeuser Company
Willamette Timberlands

Water Storage Site Map

RECEIVED

DEC 20 1994


N↑

Map Scale: 1" = 1000 feet


Section 30

Township 16S

Range 1W

Forty SE 1/4, SW 1/4

River Basin McKenzie

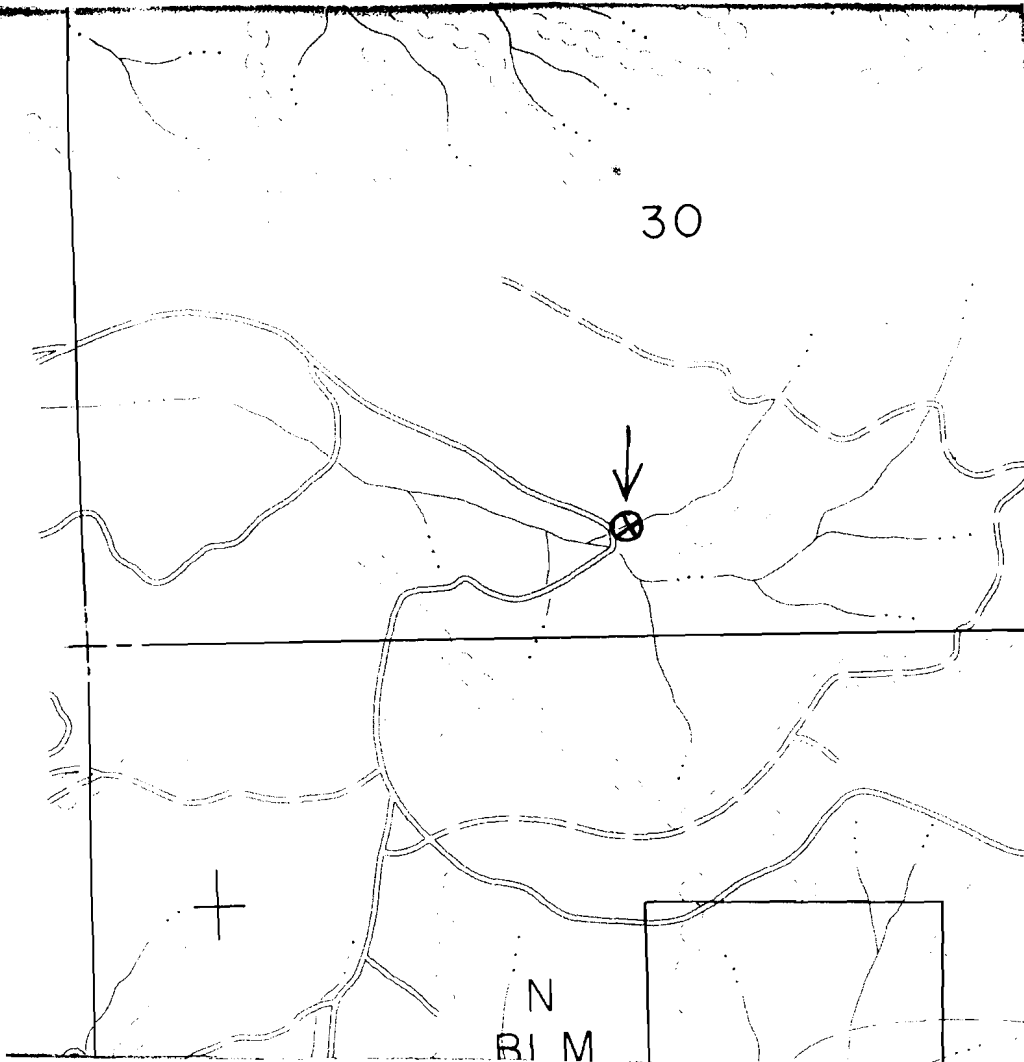

Gallons of Water Stored: 30,000

Purpose of Impounded Water:

1. Emergency Fire Suppression
2. water source for herbicide spray and road watering.

Application No. R-75711
Permit No.

"CERTIFICATE NO. 69737"
Weyerhaeuser Company
Willamette Timberlands

Water Storage Site Map

RECEIVED

DEC 20 1994

WATER RESOURCES DEPT.
SALEM, OREGON

N↑

Map Scale: 1" = 1000 feet


Section 20

Township 16S

Range 1E

Forty SE 1/4, SW 1/4

River Basin McKenzie

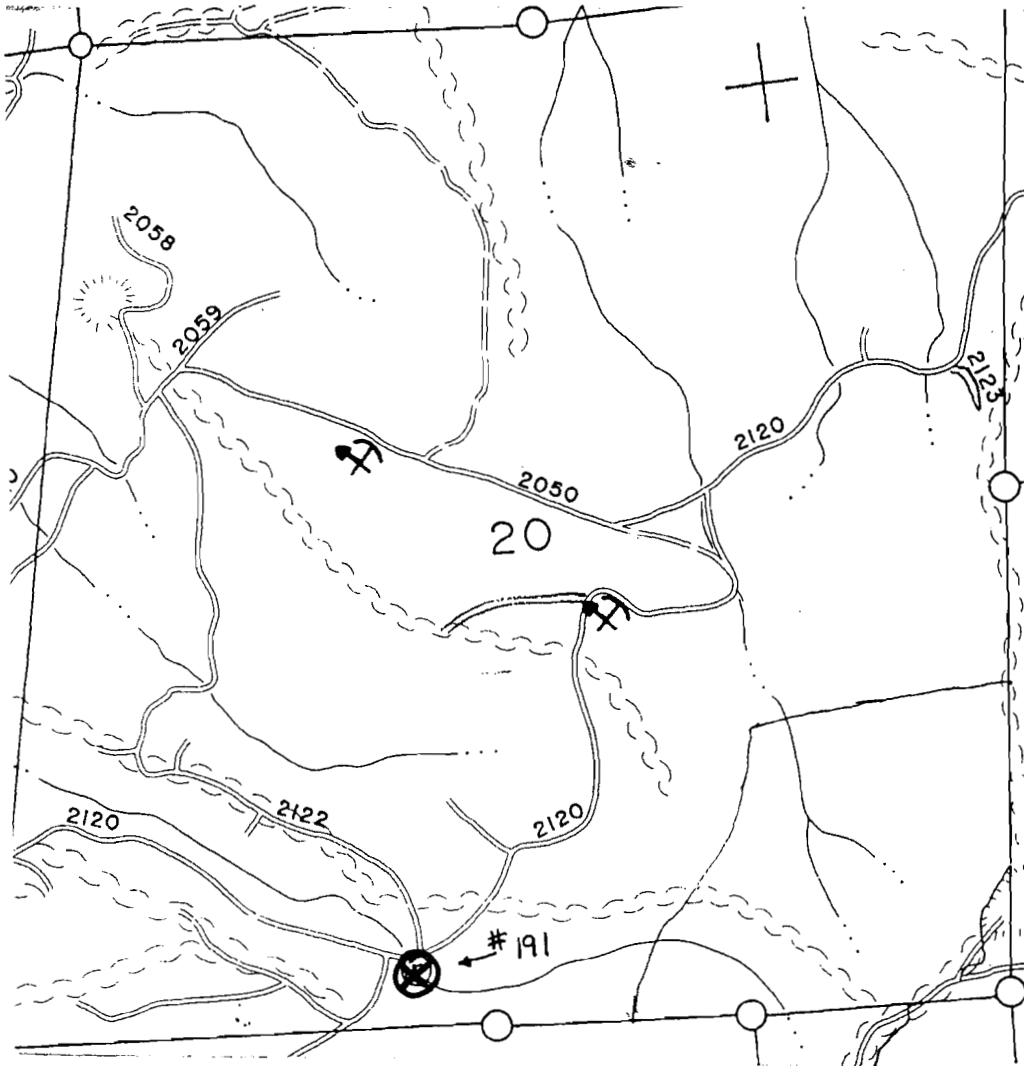

Gallons of Water Stored: 32,000

Purpose of Impounded Water:

1. Emergency Fire Suppression
2. water source for herbicide spray

24'

Application No. R-75711
Permit No.

"CERTIFICATE NO. 69737"
Weyerhaeuser Company
Willamette Timberlands

RECEIVED

DEC 20 1994

WATER RESOURCES DEPT.
SALEM, OREGON

Water Storage Site Map

N↑

Map Scale: 1" = 1000 feet


Section 15

Township 16S

Range 1E

Forty NW 1/4, SE 1/4

River Basin McKenzie

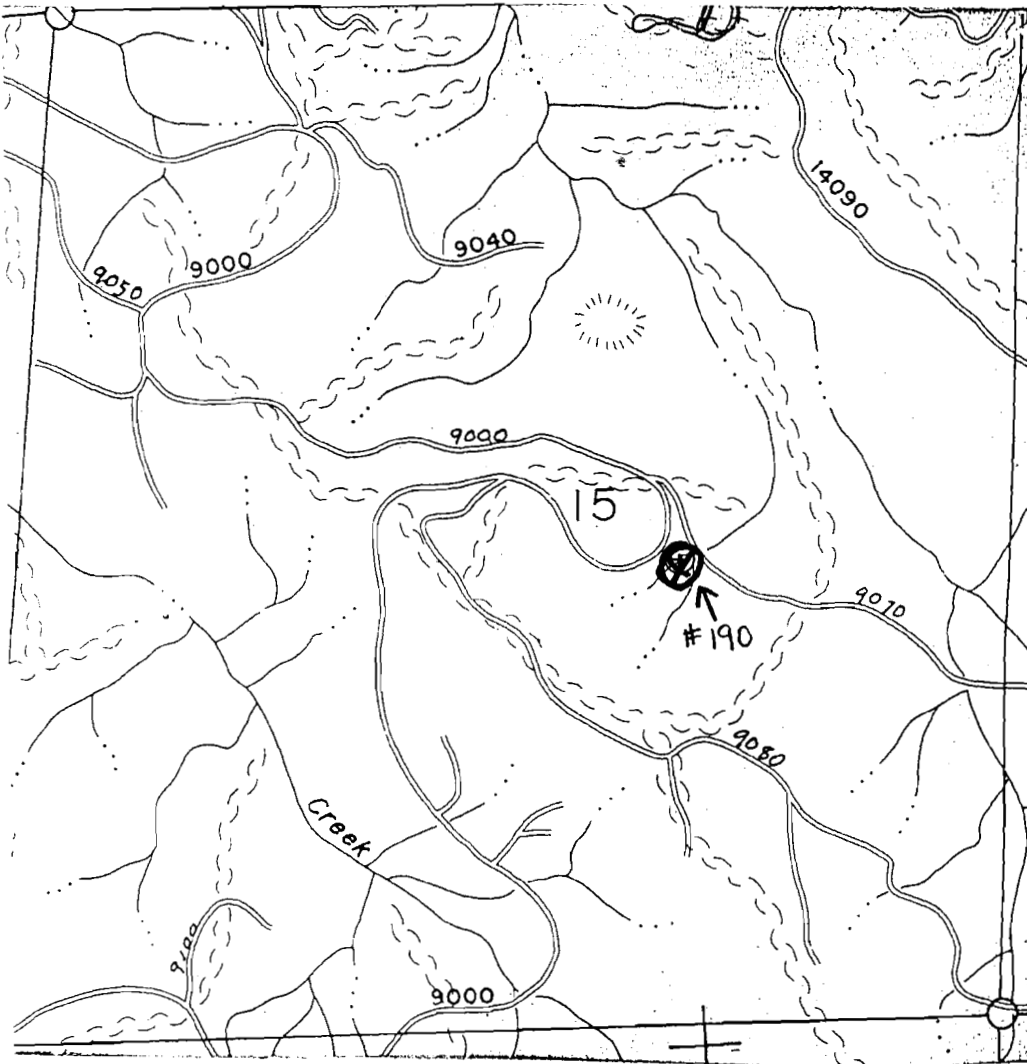

Gallons of Water Stored: 124,000

Purpose of Impounded Water:

- ① Emergency Fire Suppression
2. water source for herbicide spray

Application No. R-75711

Permit No.

"CERTIFICATE NO.

69737


Weyerhaeuser Company
Willamette Timberlands

RECEIVED

DEC 20 1994

WATER RESOURCES DEPT.
SALEM, OREGON

Water Storage Site Map

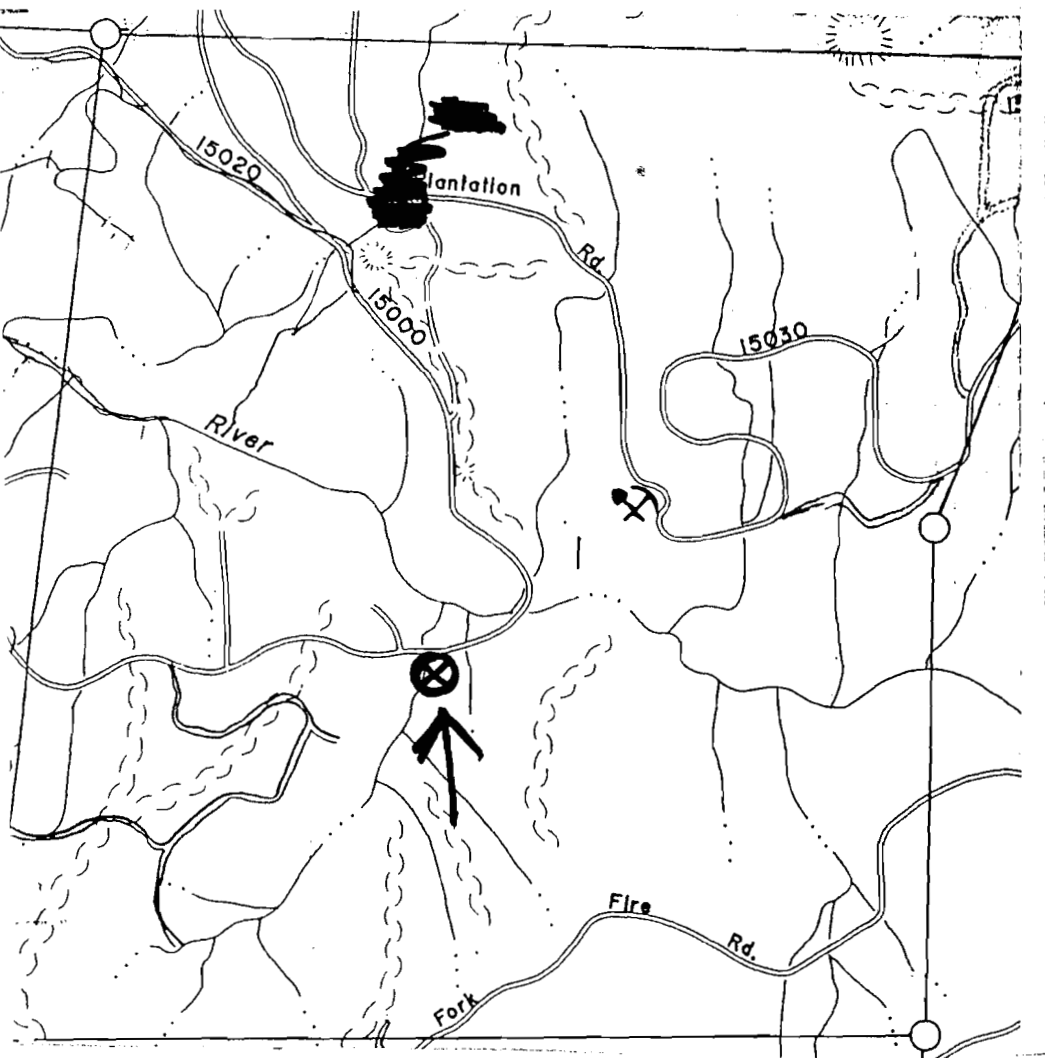

N↑

Map Scale: 1" = 1000 feet

Section 1

Township 16 S

Range 1 E

Forty NE 1/4 SW 1/4

River Basin McKenzie


Gallons of Water Stored: 32,000

Purpose of Impounded Water:

1. Emergency Fire Suppression (pump chance)
2. water source for herbicide spray

"CERTIFICATE NO. 69737"
Application No. 2-75711
Permit No.
Weyerhaeuser Company
Willamette Timberlands

Water Storage Site Map

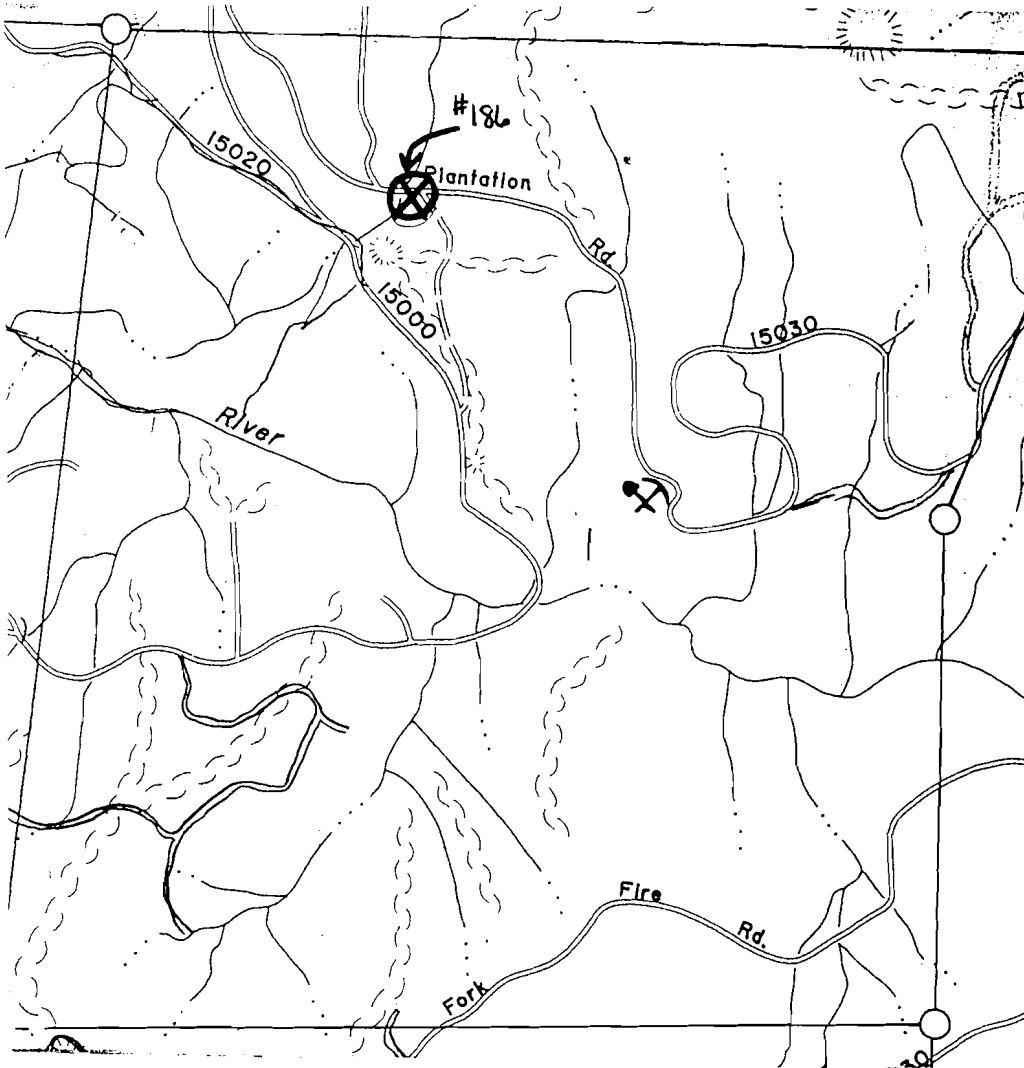

N↑

Map Scale: 1" = 1000 feet

Section 1

Township 16S

Range 1E

Forty NE 1/4, NW 1/4

River Basin McKenzie

RECEIVED

DEC 20 1994

WATER RESOURCES DIV.
SALEM, OREGON

Gallons of Water Stored: 315,000

Purpose of Impounded Water:

- ① Emergency Fire Suppression
2. _____

"CERTIFICATE NO. 69737"
Application No. R-75711
Permit No.

Weyerhaeuser Company
Willamette Timberlands

Water Storage Site Map

RECEIVED

DEC 20 1994

WATER RESOURCES DEPT.
SALEM, OREGON

N↑

Map Scale: 1" = 1000 feet


Section 12

Township 16S

Range 1E

Forty NE 1/4, SW 1/4

River Basin McKenzie

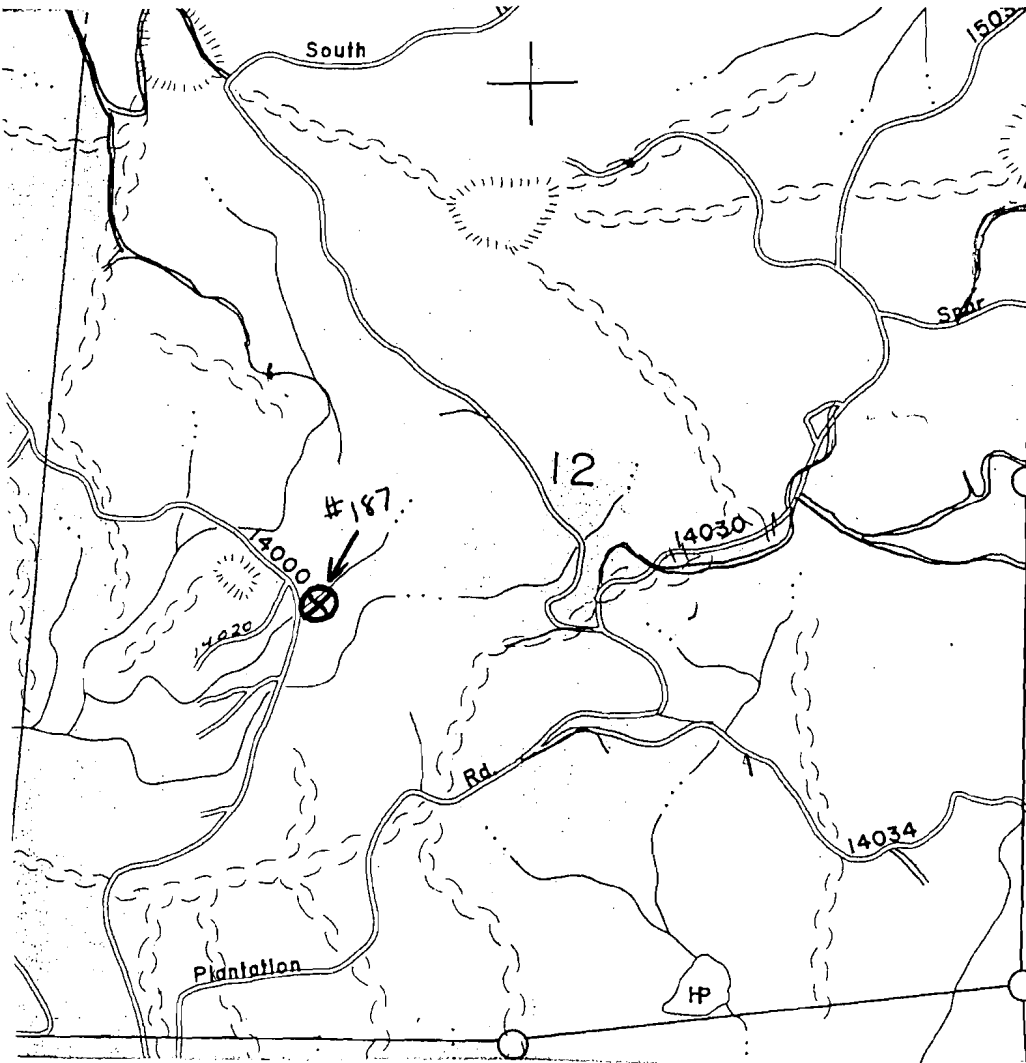

Gallons of Water Stored: 63,000

Purpose of Impounded Water:

1. Emergency Fire Suppression
2. water source for herbicide spray

Application No. 75711

Permit No.

CERTIFICATE NO.

69737

Weyerhaeuser Company
Willamette Timberlands

RECEIVED

DEC 20 1994

WATER RESOURCES DIVISION
SALEM, OREGON

Water Storage Site Map

N↑

Map Scale: 1" = 1000 feet


Section 13

Township 16S

Range 1E

Forty SW 1/4, SW 1/4

River Basin McKenzie

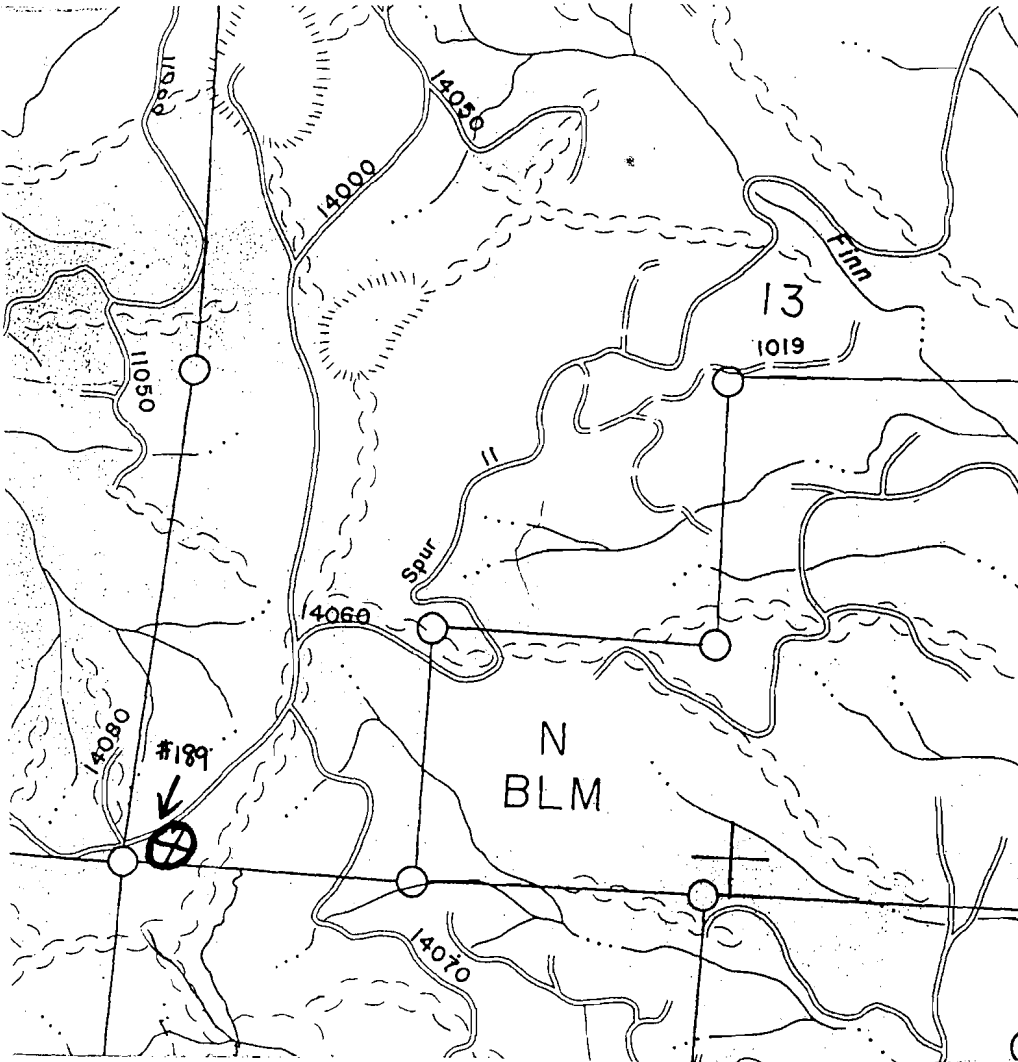

12-18

Gallons of Water Stored: 29,500

Purpose of Impounded Water:

1. Emergency Fire Suppression
2. Water source for herbicide spray