


Application No. 2-75713
Permit No. 69739

CERTIFICATE NO. 69739

REU 7/20/44
WATER RESOURCES DEPT
SALEM, OREGON

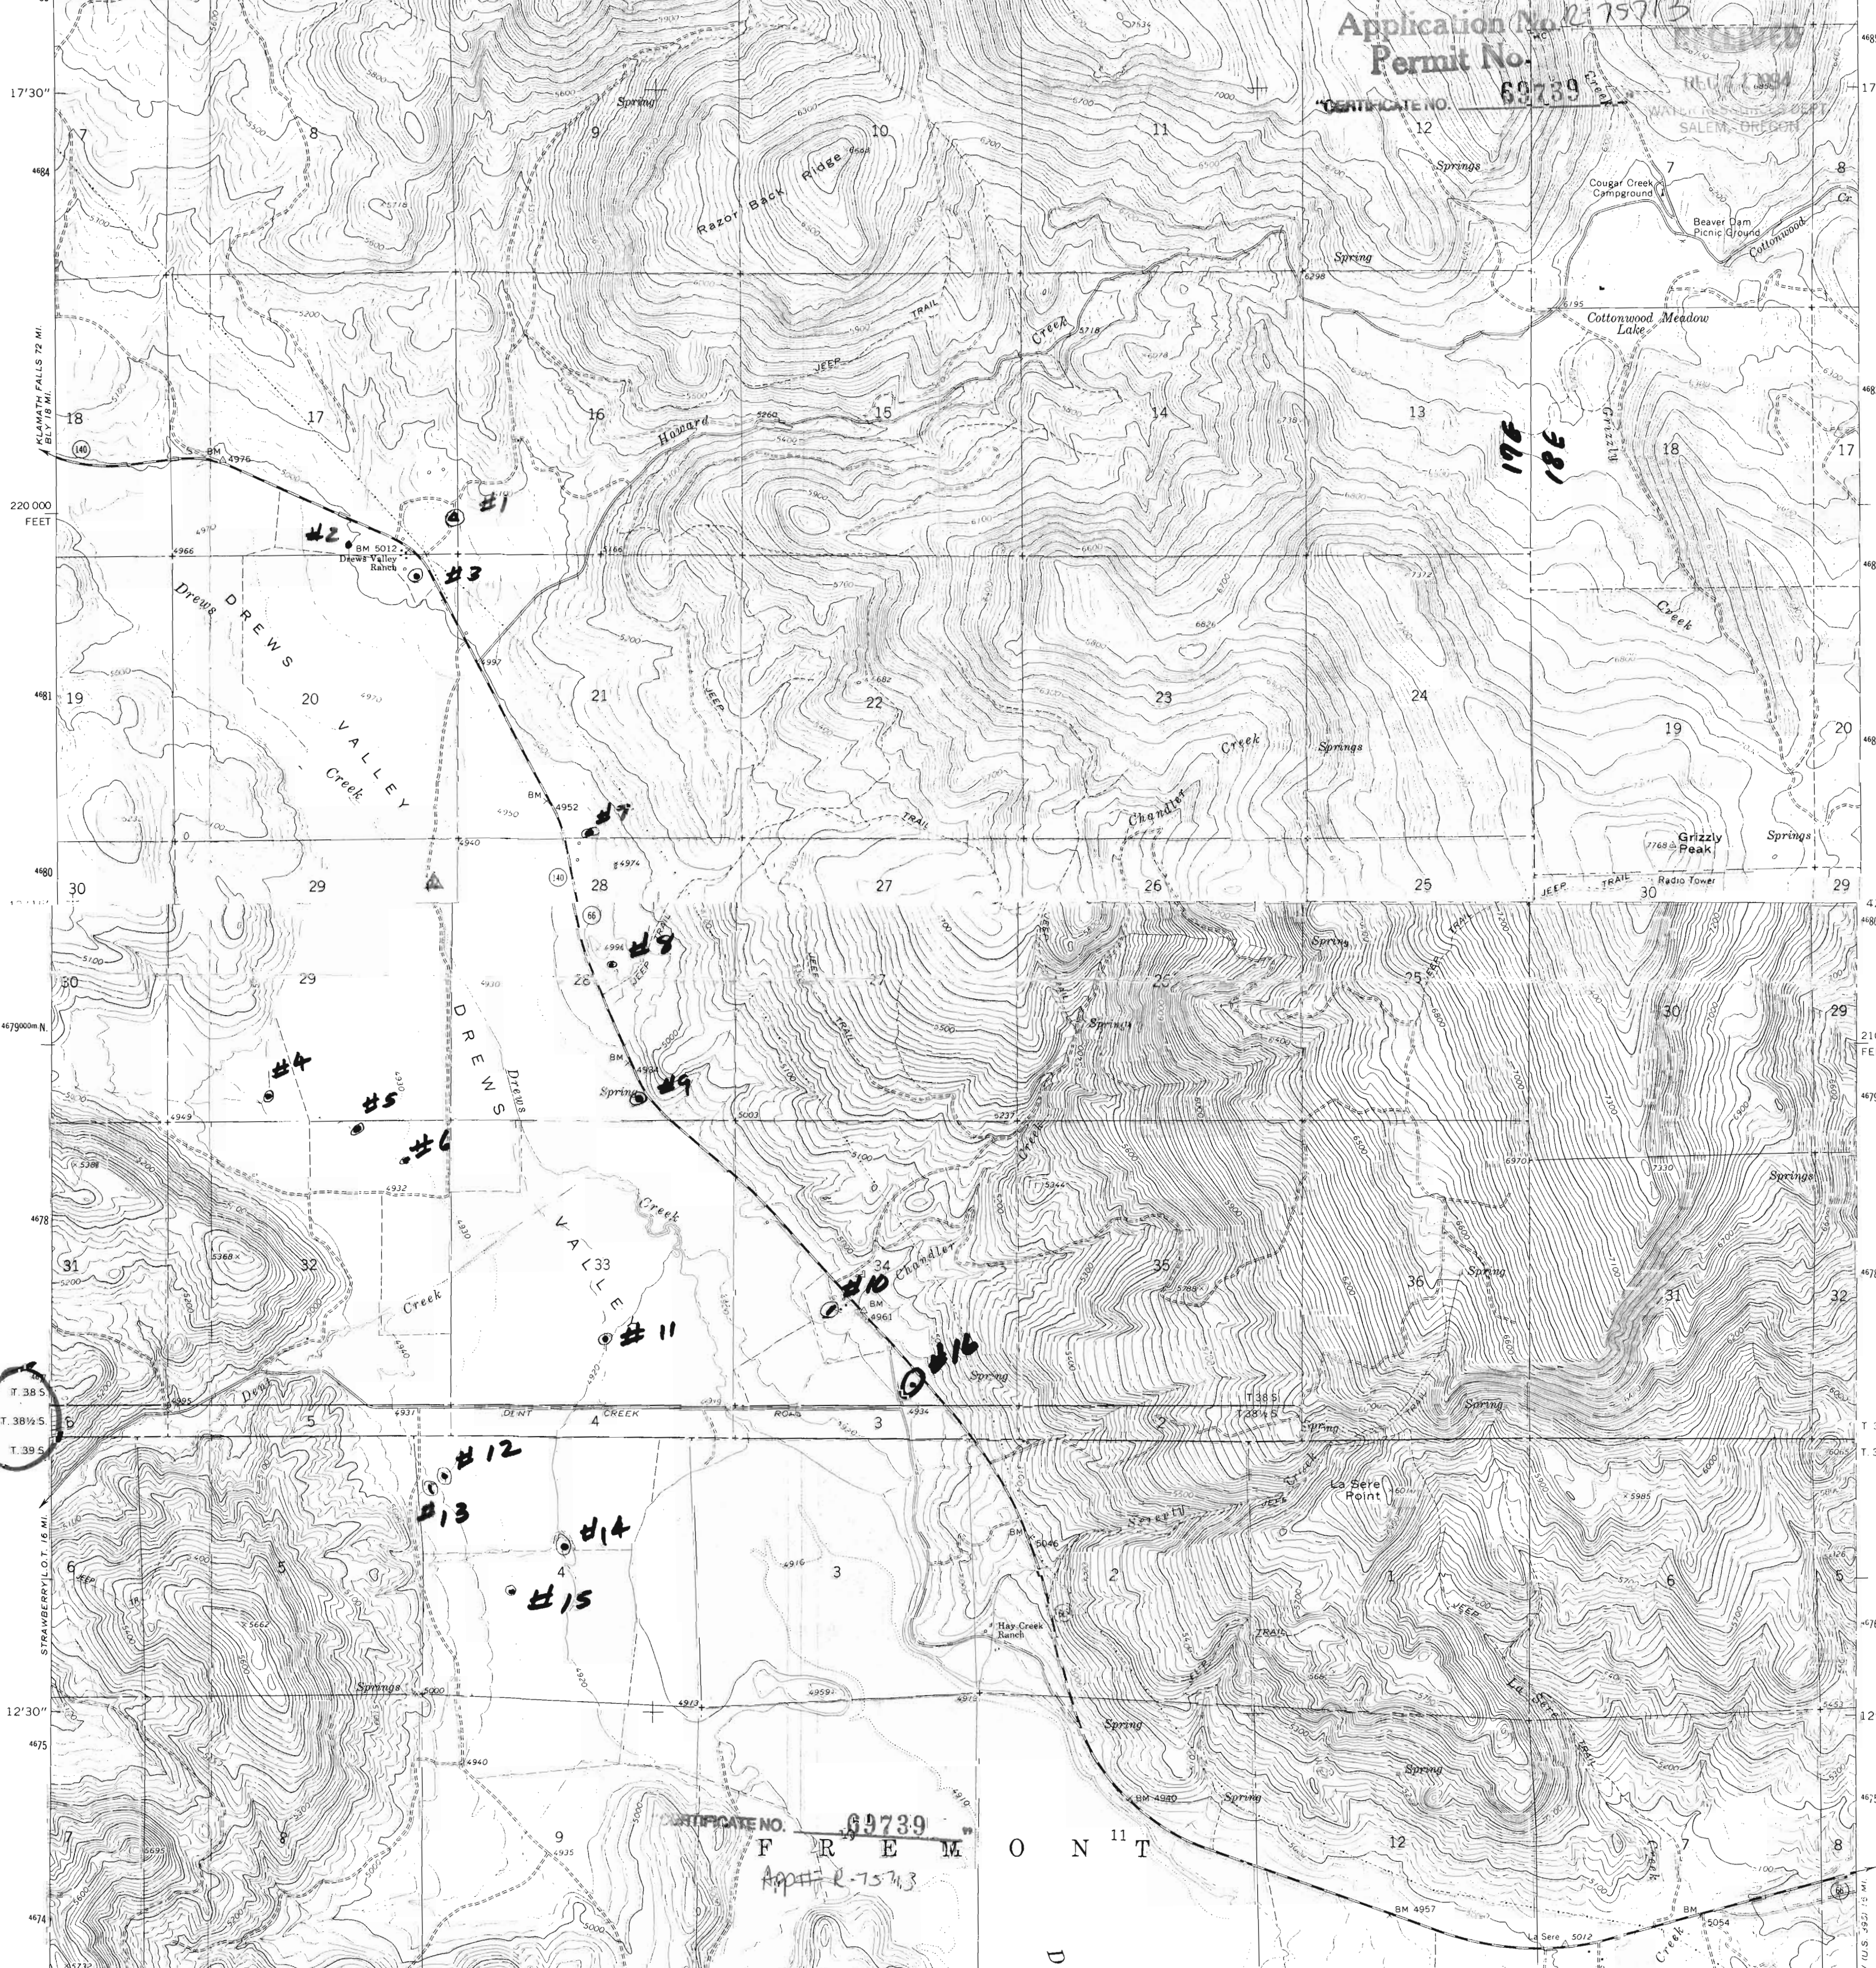

17'30"
4684
220 000
FEET
4681
4680
4679
4678
4675
12'30"
4674

17'30"
4685
4683
4682
468100
42'
4680
2100
FEET
4679
4678
4676
T. 38 S
T. 38 1/2 S
T. 39 S
4675
4674

CERTIFICATE NO. 69739
F R E M O N T
APR 7 1953

T. 38 S
T. 38 1/2 S
T. 39 S

#1
#2
#3
#4
#5
#6
#7
#8
#9
#10
#11
#12
#13
#14
#15

176
186

D