


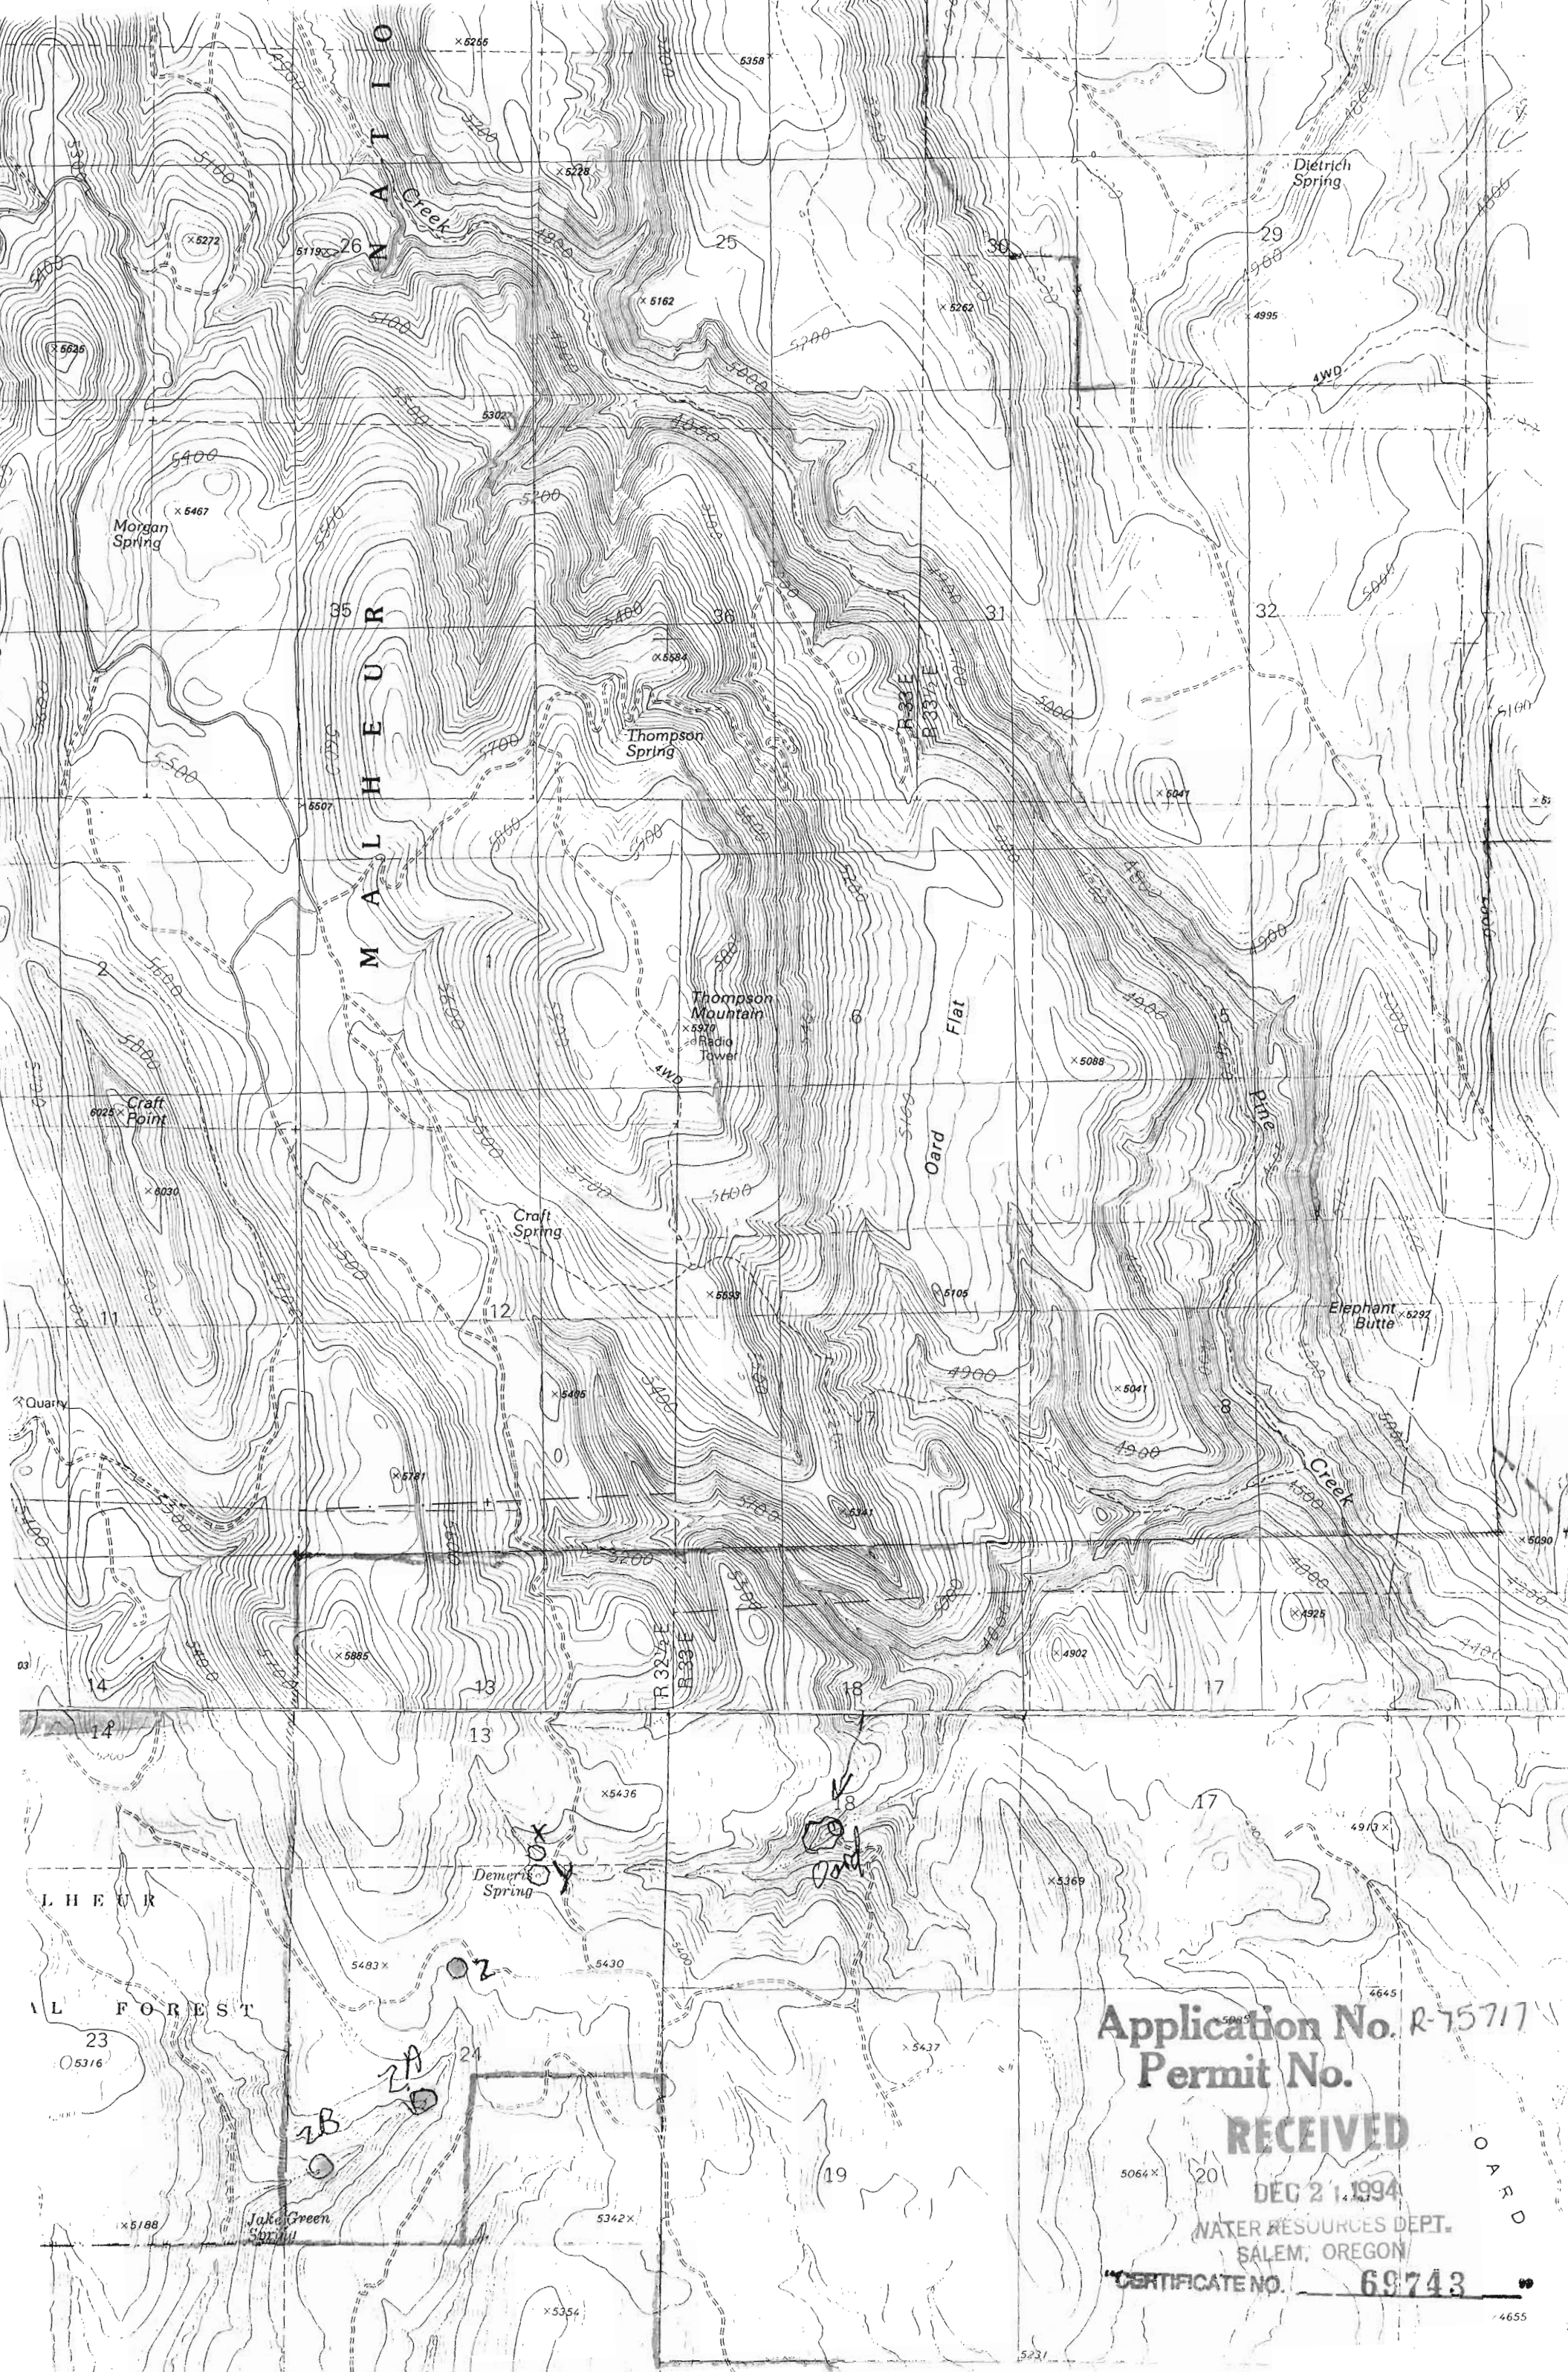

Application No. R-75717
Permit No.

RECEIVED

DEC 21 1994

WATER RESOURCES DEPT.
SALEM, OREGON

CERTIFICATE NO. 69743