


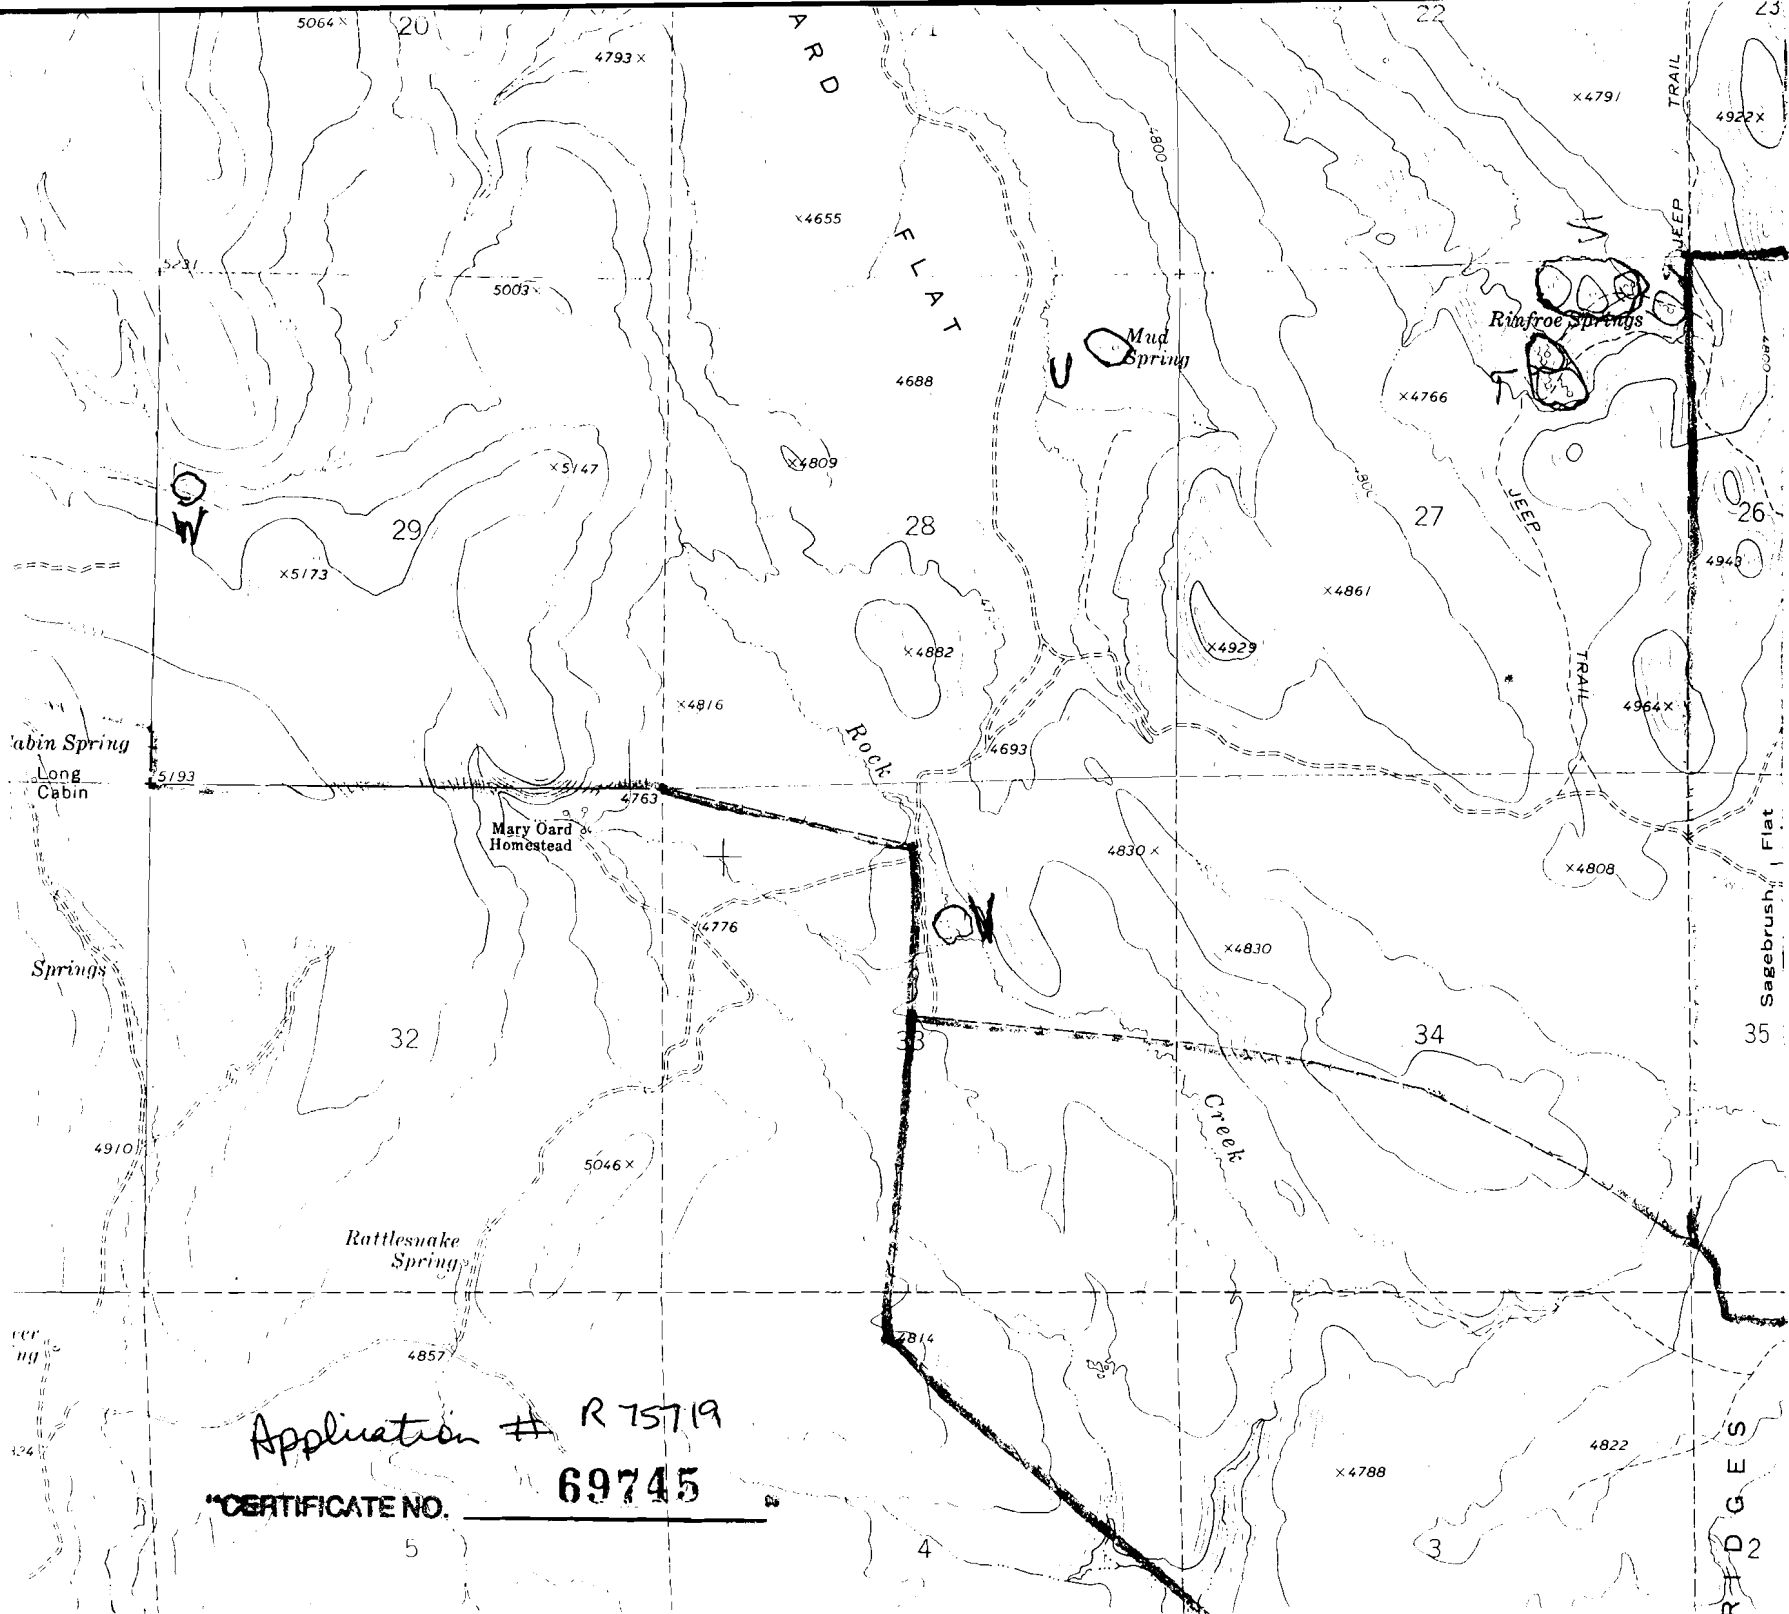

Application # R 75719

CERTIFICATE NO. 69745

5

4


3

2



"CERTIFICATE NO. 69745"

Application No. R-75719
Permit No.

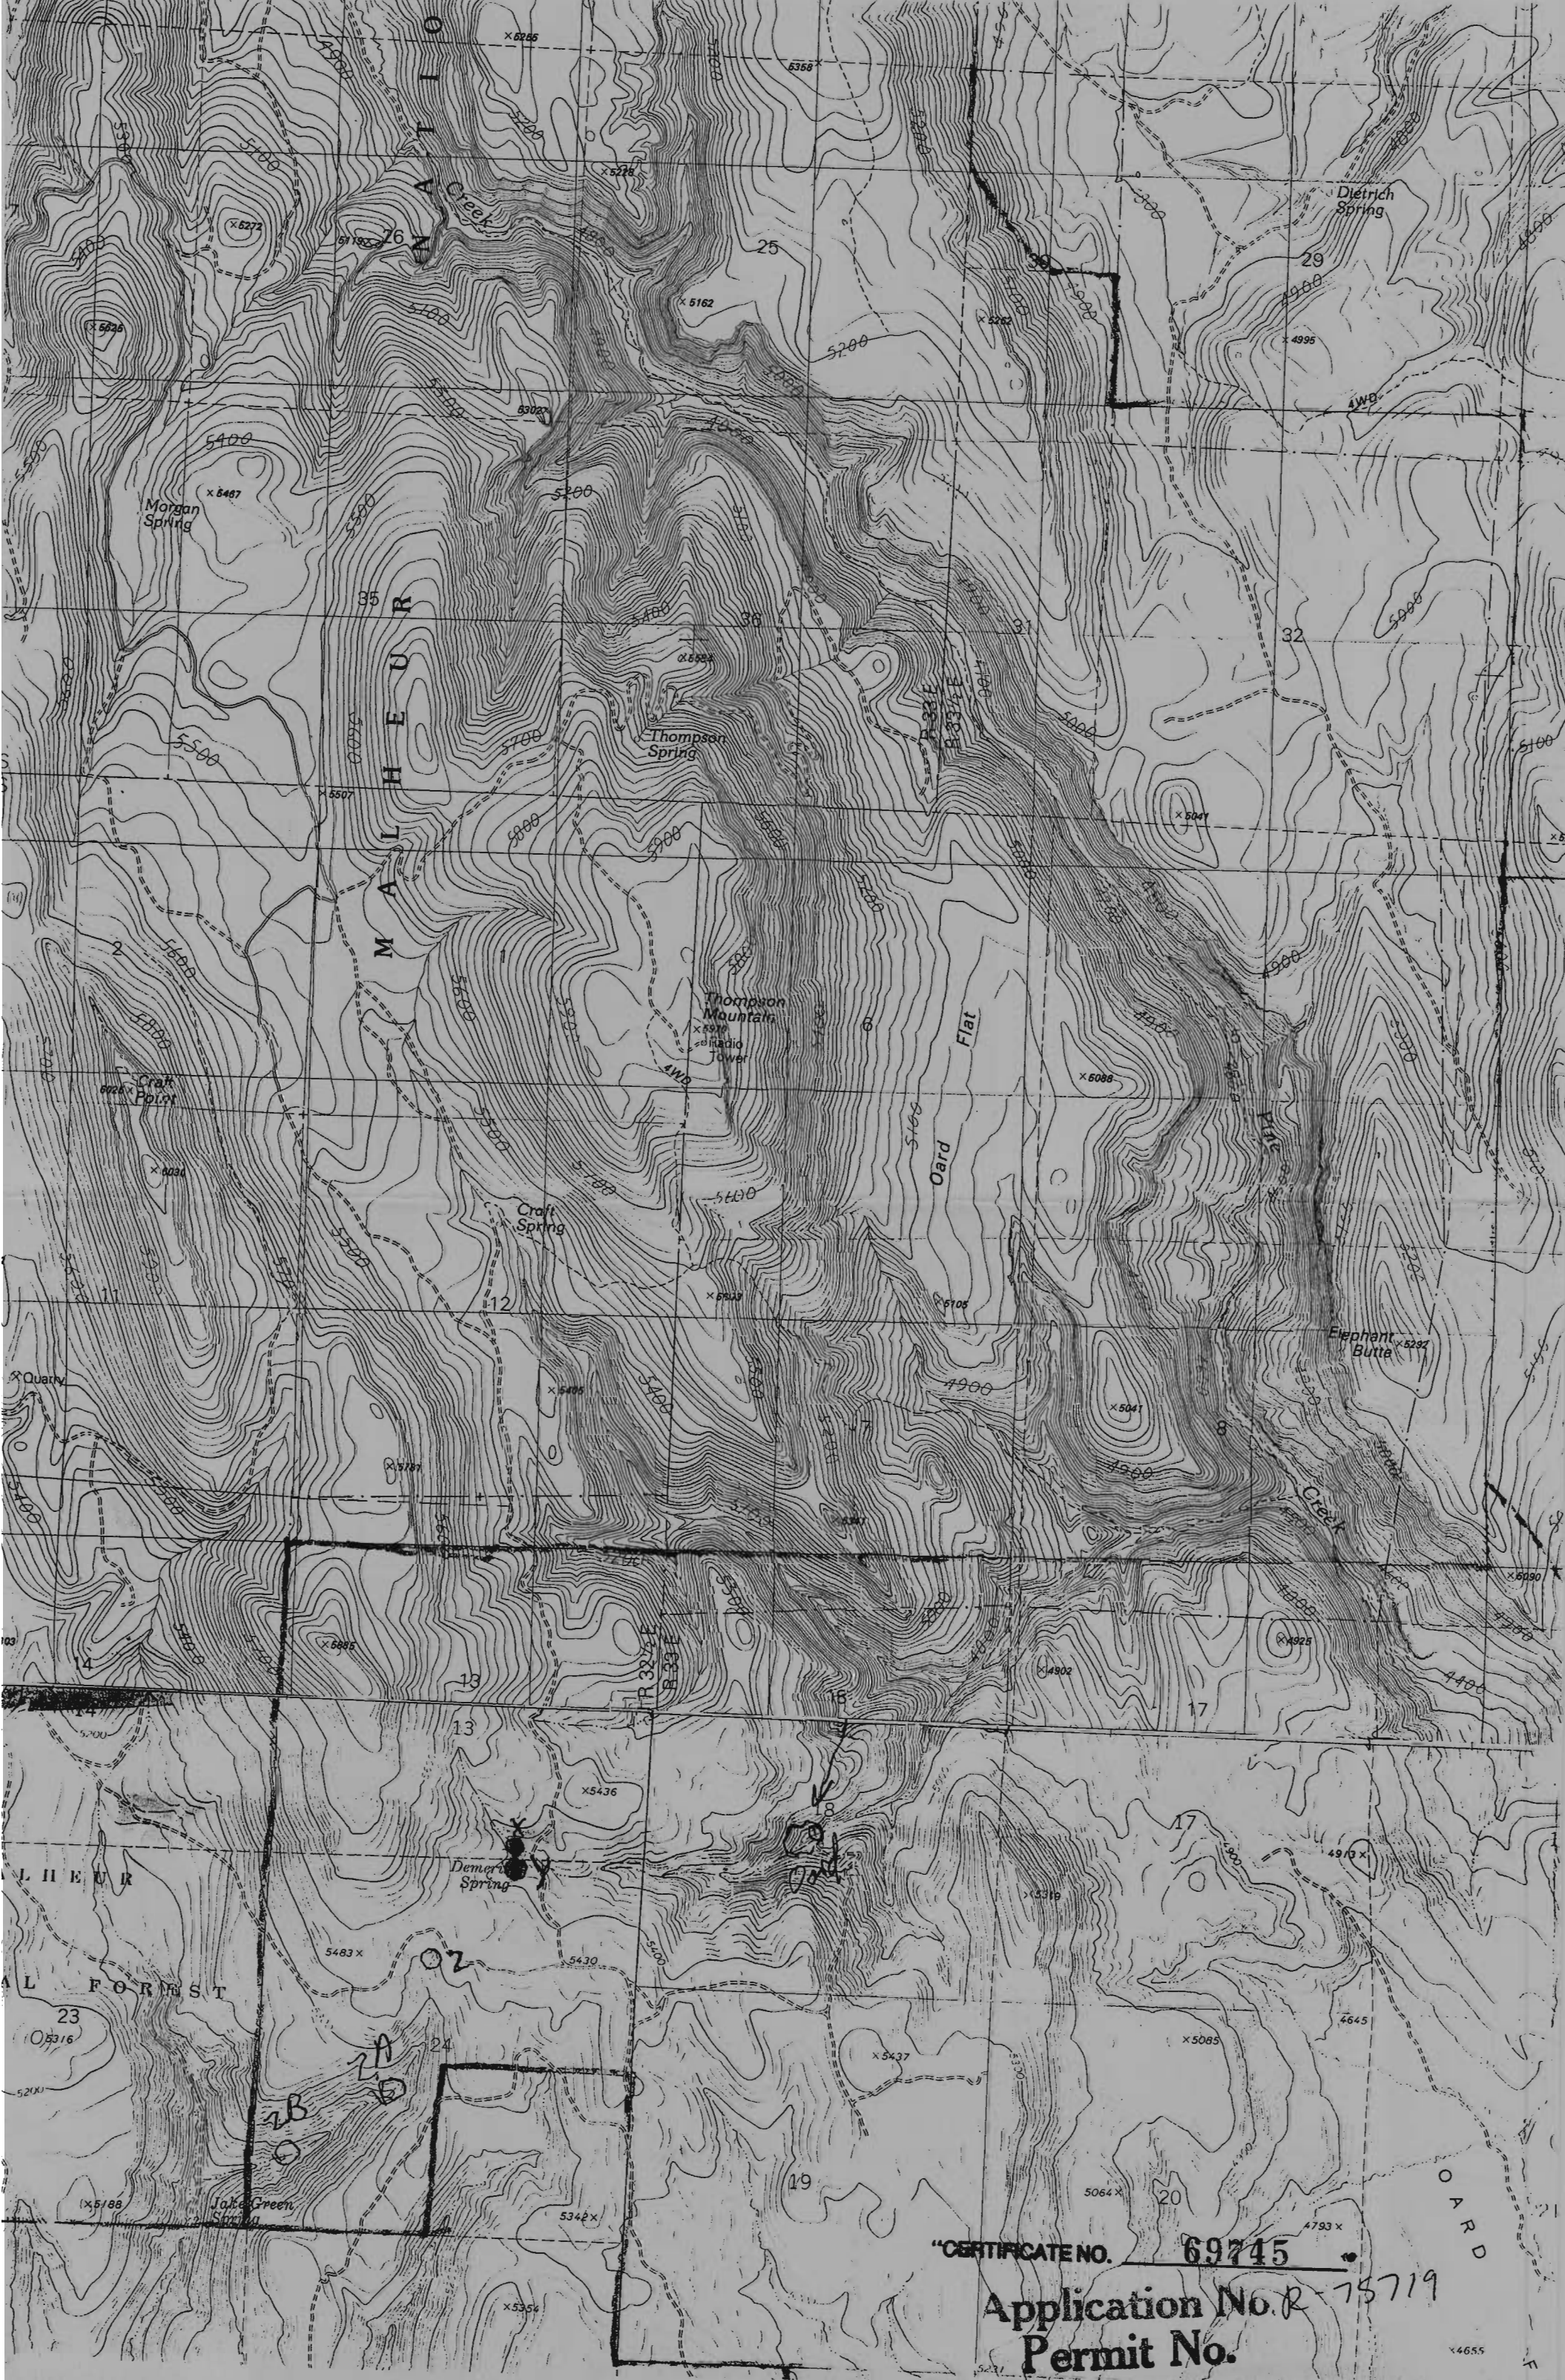

"CERTIFICATE NO. 69745"

Application No. R 75719
Permit No.



RECEIVED

DEC 21 1994

WATER RESOURCES DEPT.
SALEM, OREGON

CERTIFICATE NO.

69745

Application No.
Permit No.

R-75719