

RECEIVED

Polk Co. Regional Taxmap

Scale 1:272

08/13/94

Survey





Application No. R-75722

Permit No.

DEC 22 1994

WATER RESOURCES DEPT.
SALEM, OREGON

"CERTIFICATE NO. 69747"

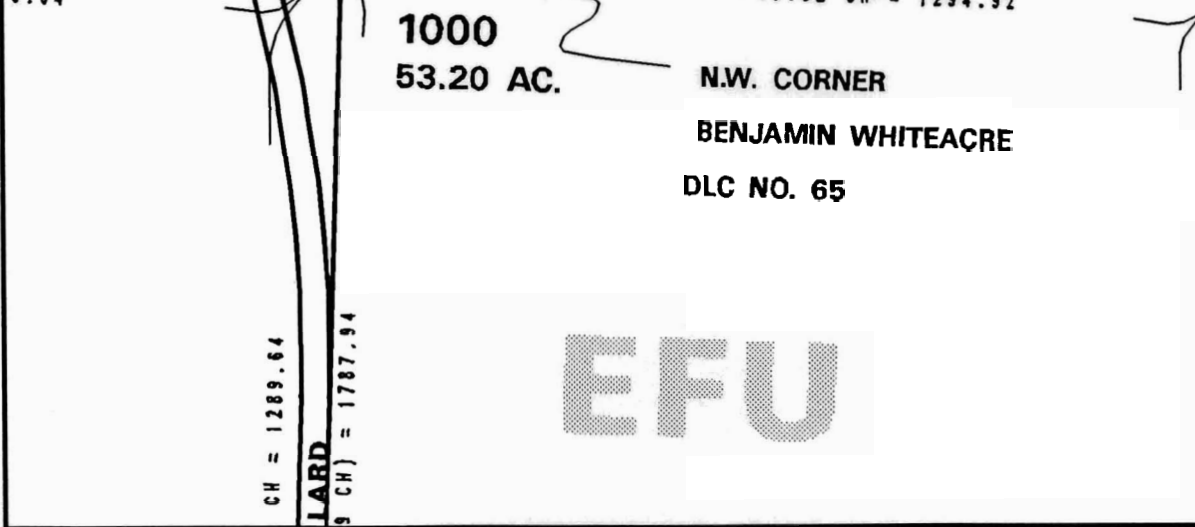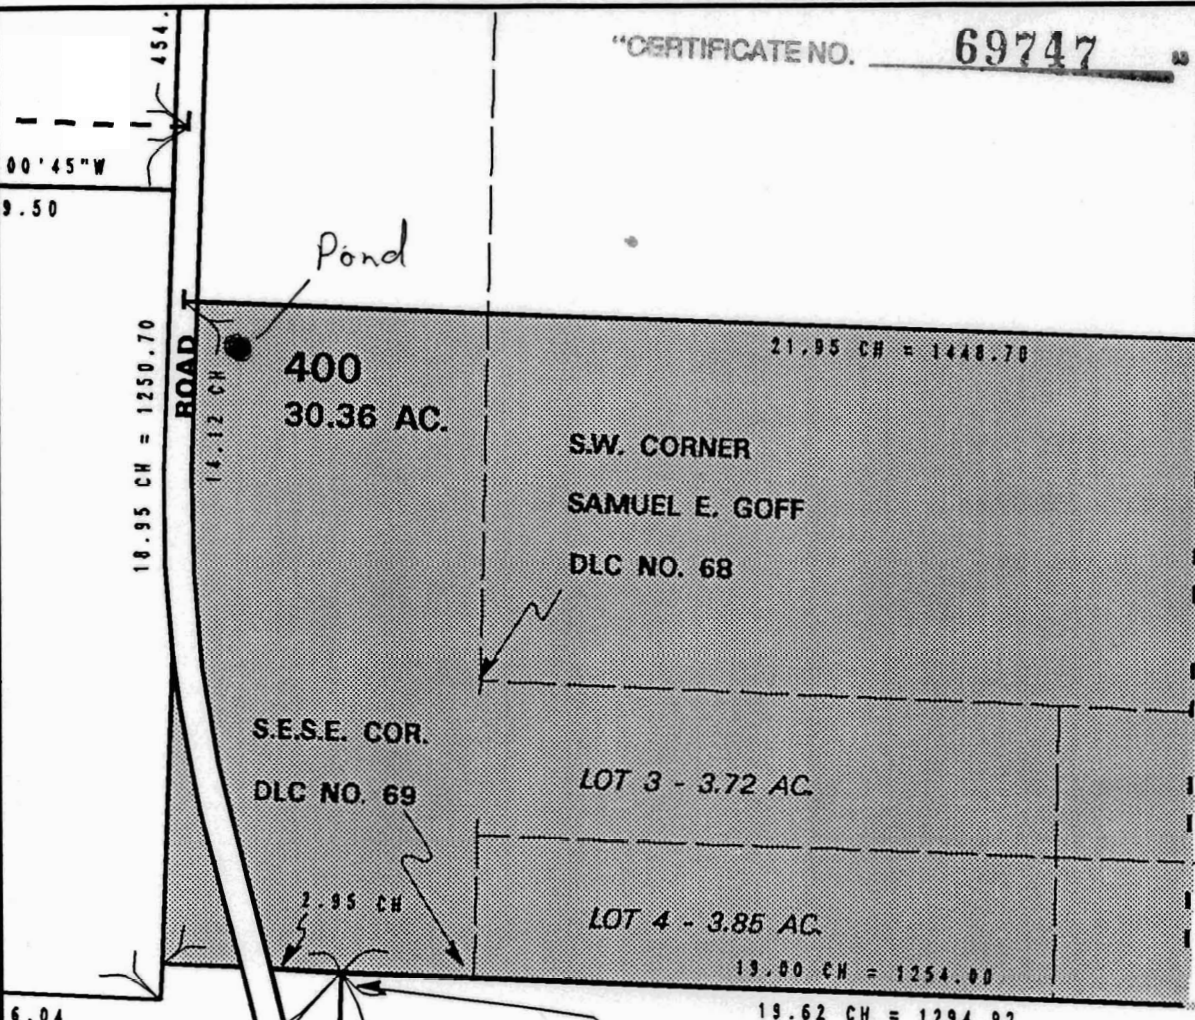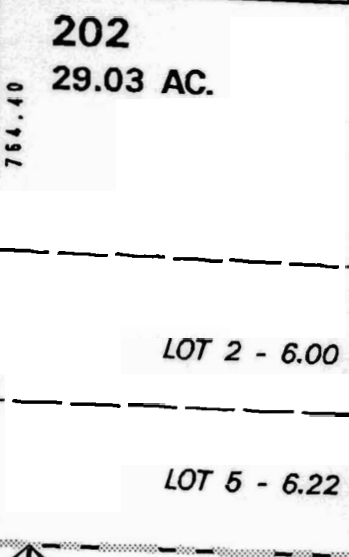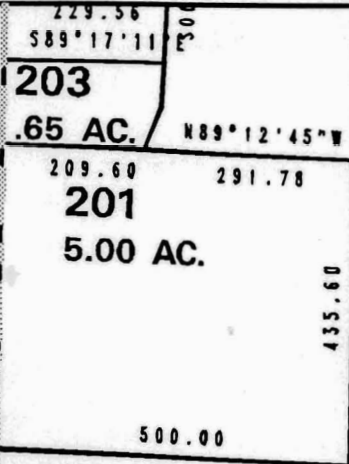

EFU

Note: Source of taxlots is County Assessor Map.