


R 75738

T.7S. R.2W. W.M. 69755

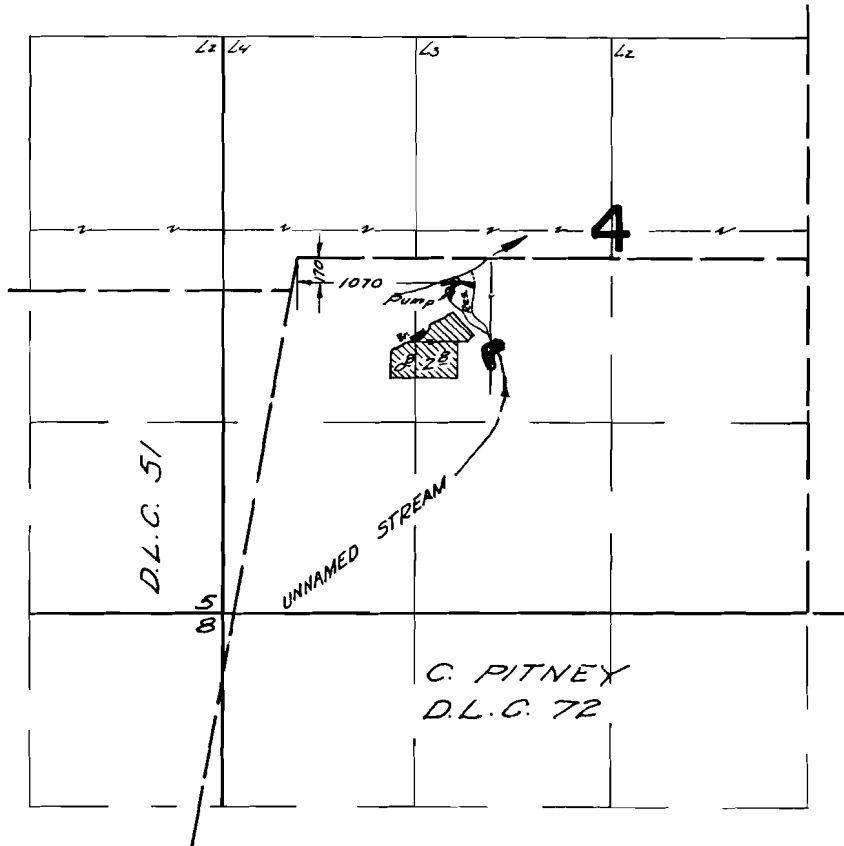

RECEIVED

FINAL PROOF SURVEY  
UNDER

DEC 22 1994

WATER RESOURCES DEPT  
SALEM, OREGON

R-40212 R-4491  
Application No. 40213 Permit No. 29993  
IN NAME OF

ALBERT I. NEEDHAM

Surveyed Nov. 22, 1967, by V. Garner