


R-75741

SE1/4 SEC 27 T.8S. R.3W. WM
MARION COUNTY, OREGON

B 3W 27D
69787
R-75741


SEE MAP B 3W 27A

DELETED TAX LOT
NUMBERS
01300
02500
01400
00101

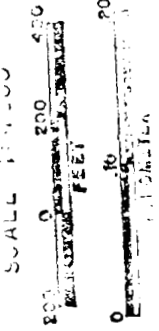

RECEIVED
DEC 23 1994

WATER RESOURCES DEPT
SALEM, OREGON
SEE MAP B 3W 27C

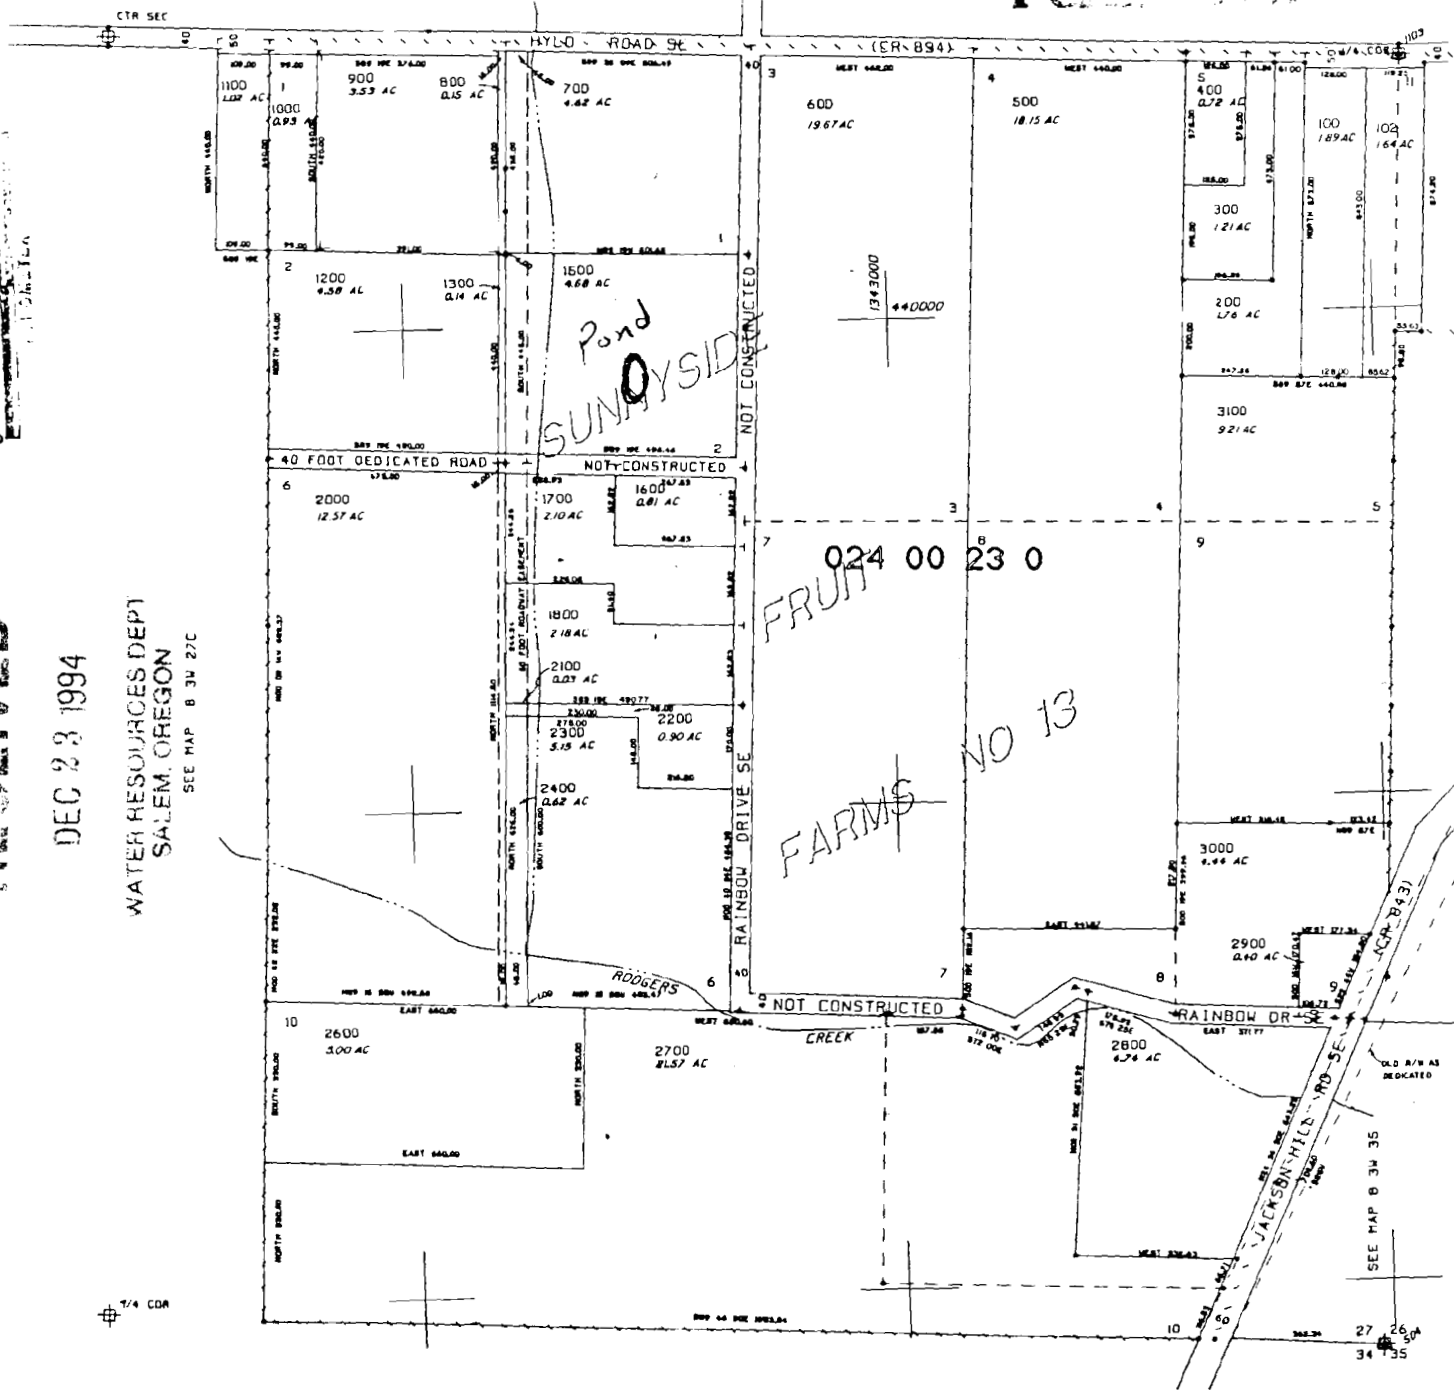

1"=200'
26-OCT-81

SEE MAP B 3W 26C

1/4 CDR

SEE MAP B 3W 35