SECTION 30 T.27S. R.6W. W.M.
DOUGLAS COUNTY

Application No. R-75746
Permit No.

27 6 30
& INDEX

1" = 400'

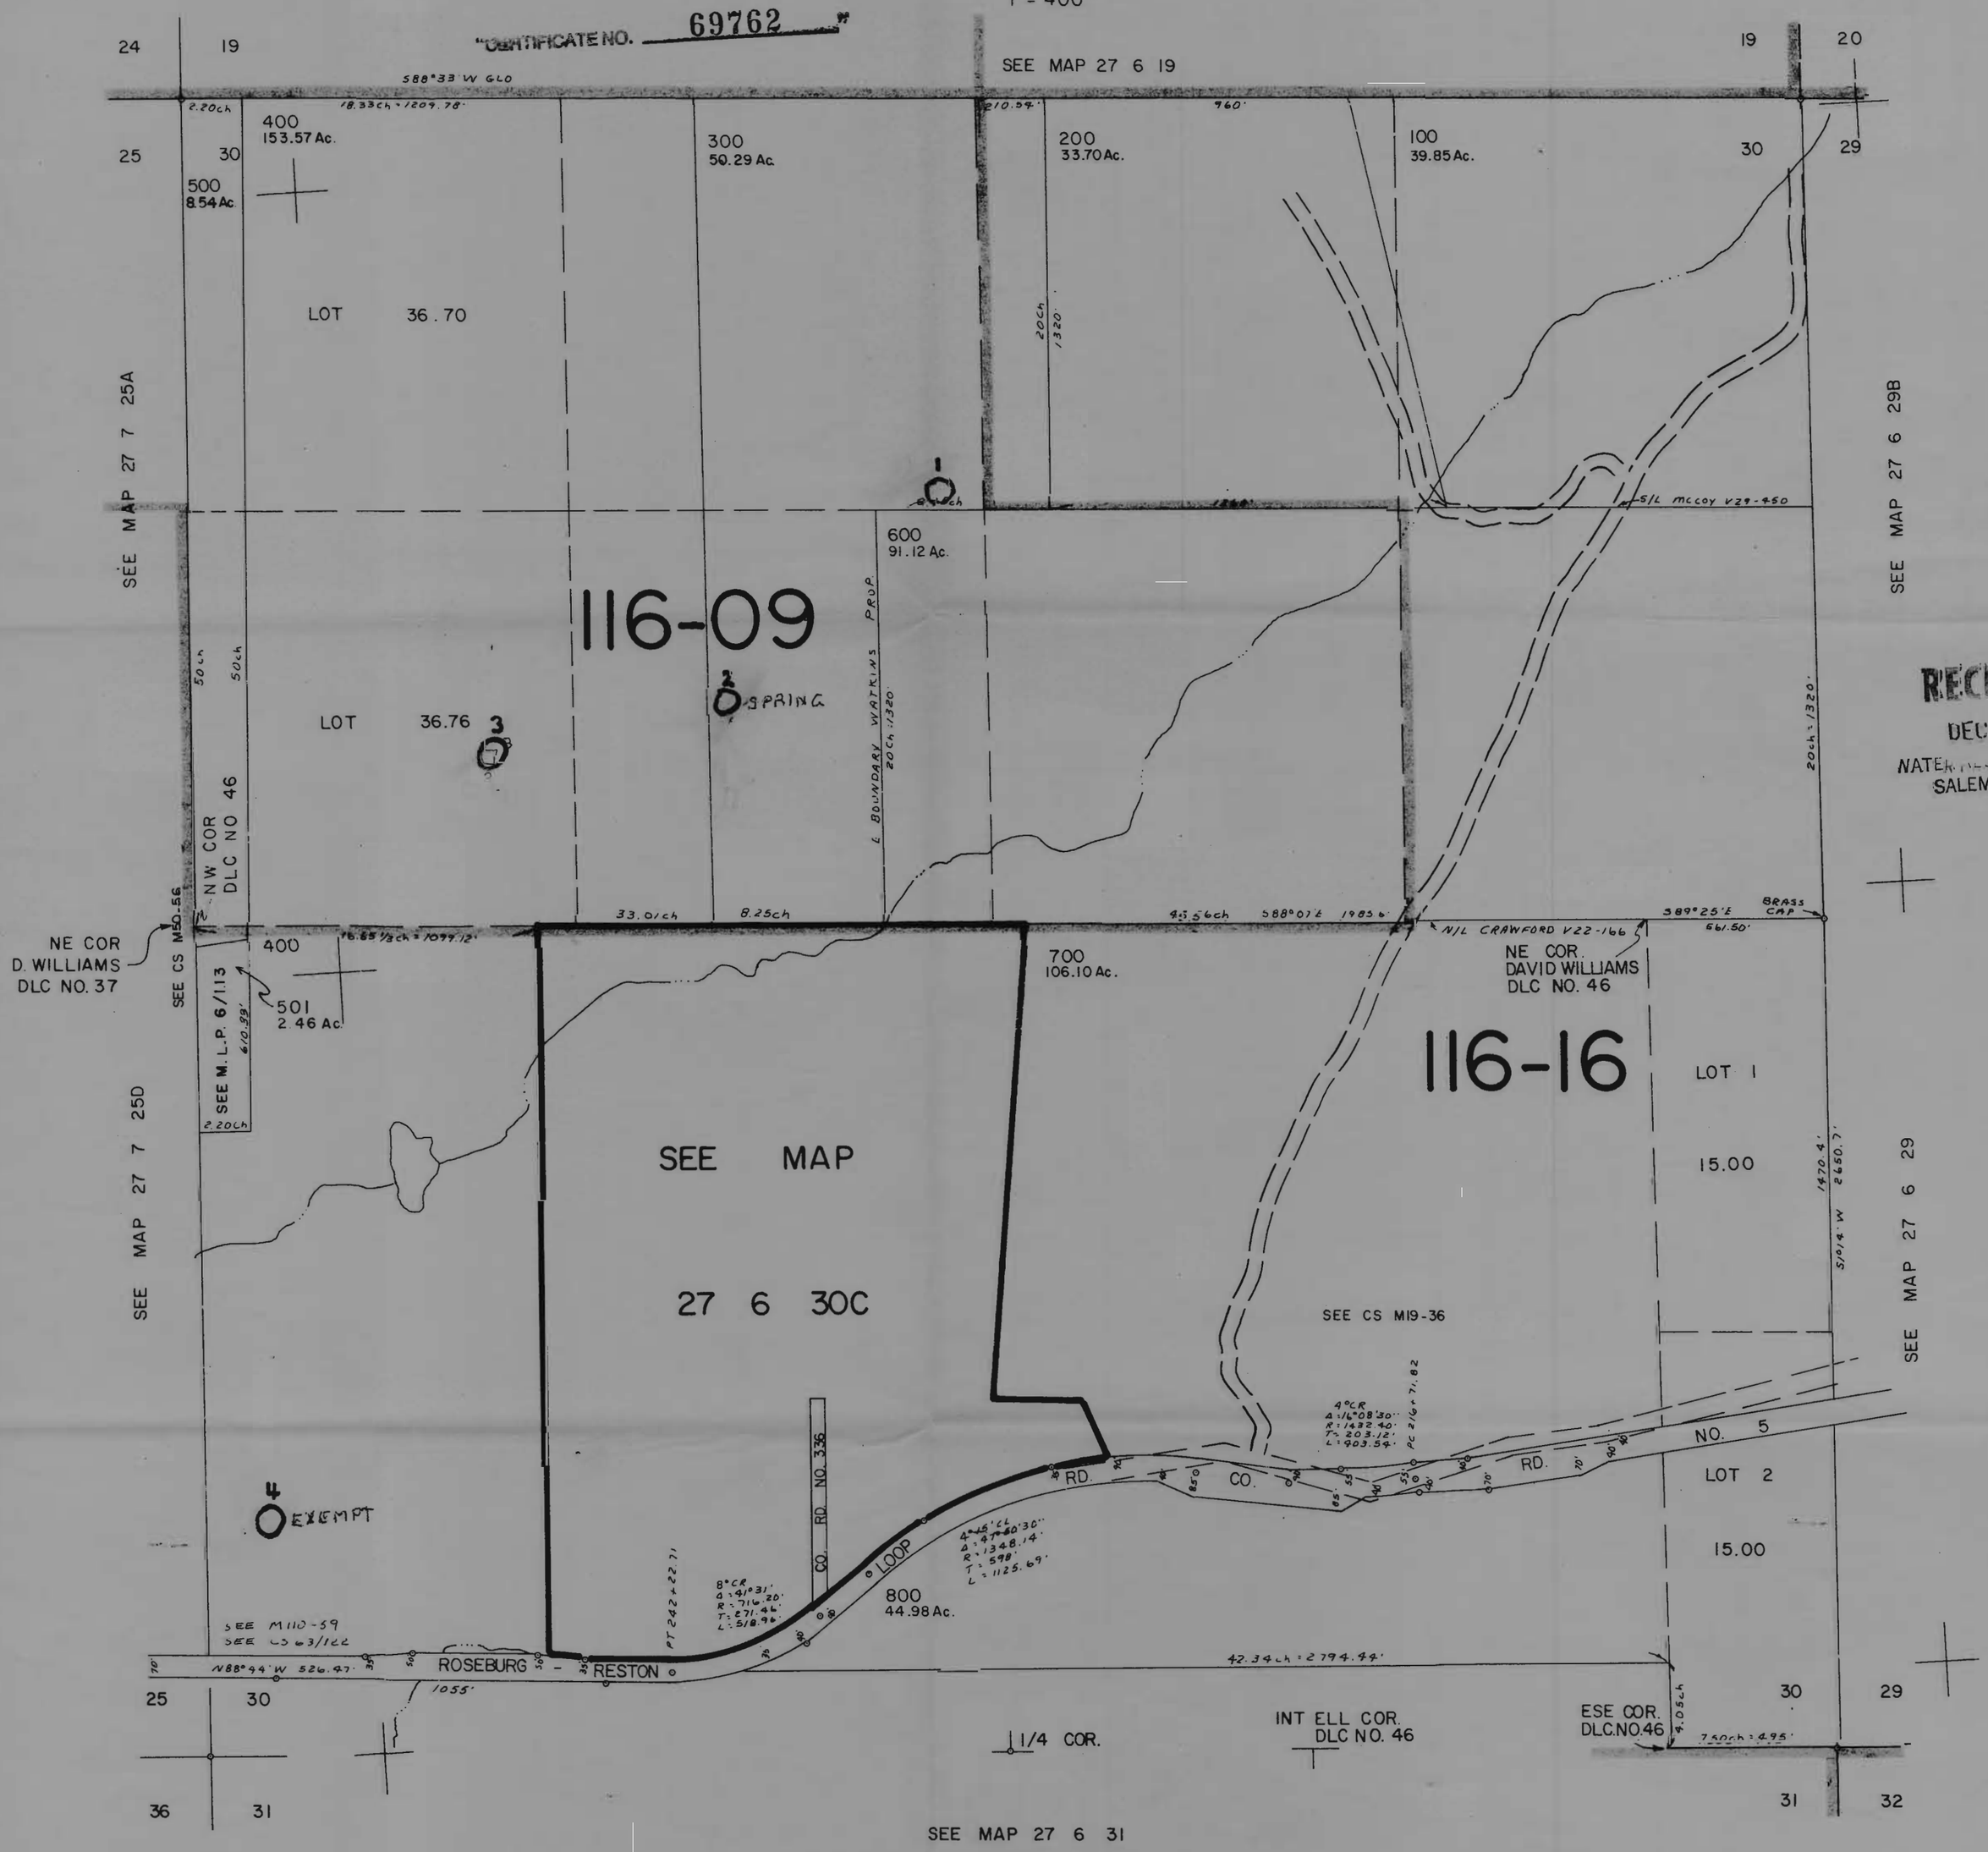

RECEIVED
DEC 21 1994
WATER RESOURCES DEPT.
SALEM, OREGON

570,000

27 6 30
& INDEX

1,215,000