


Not to Scale

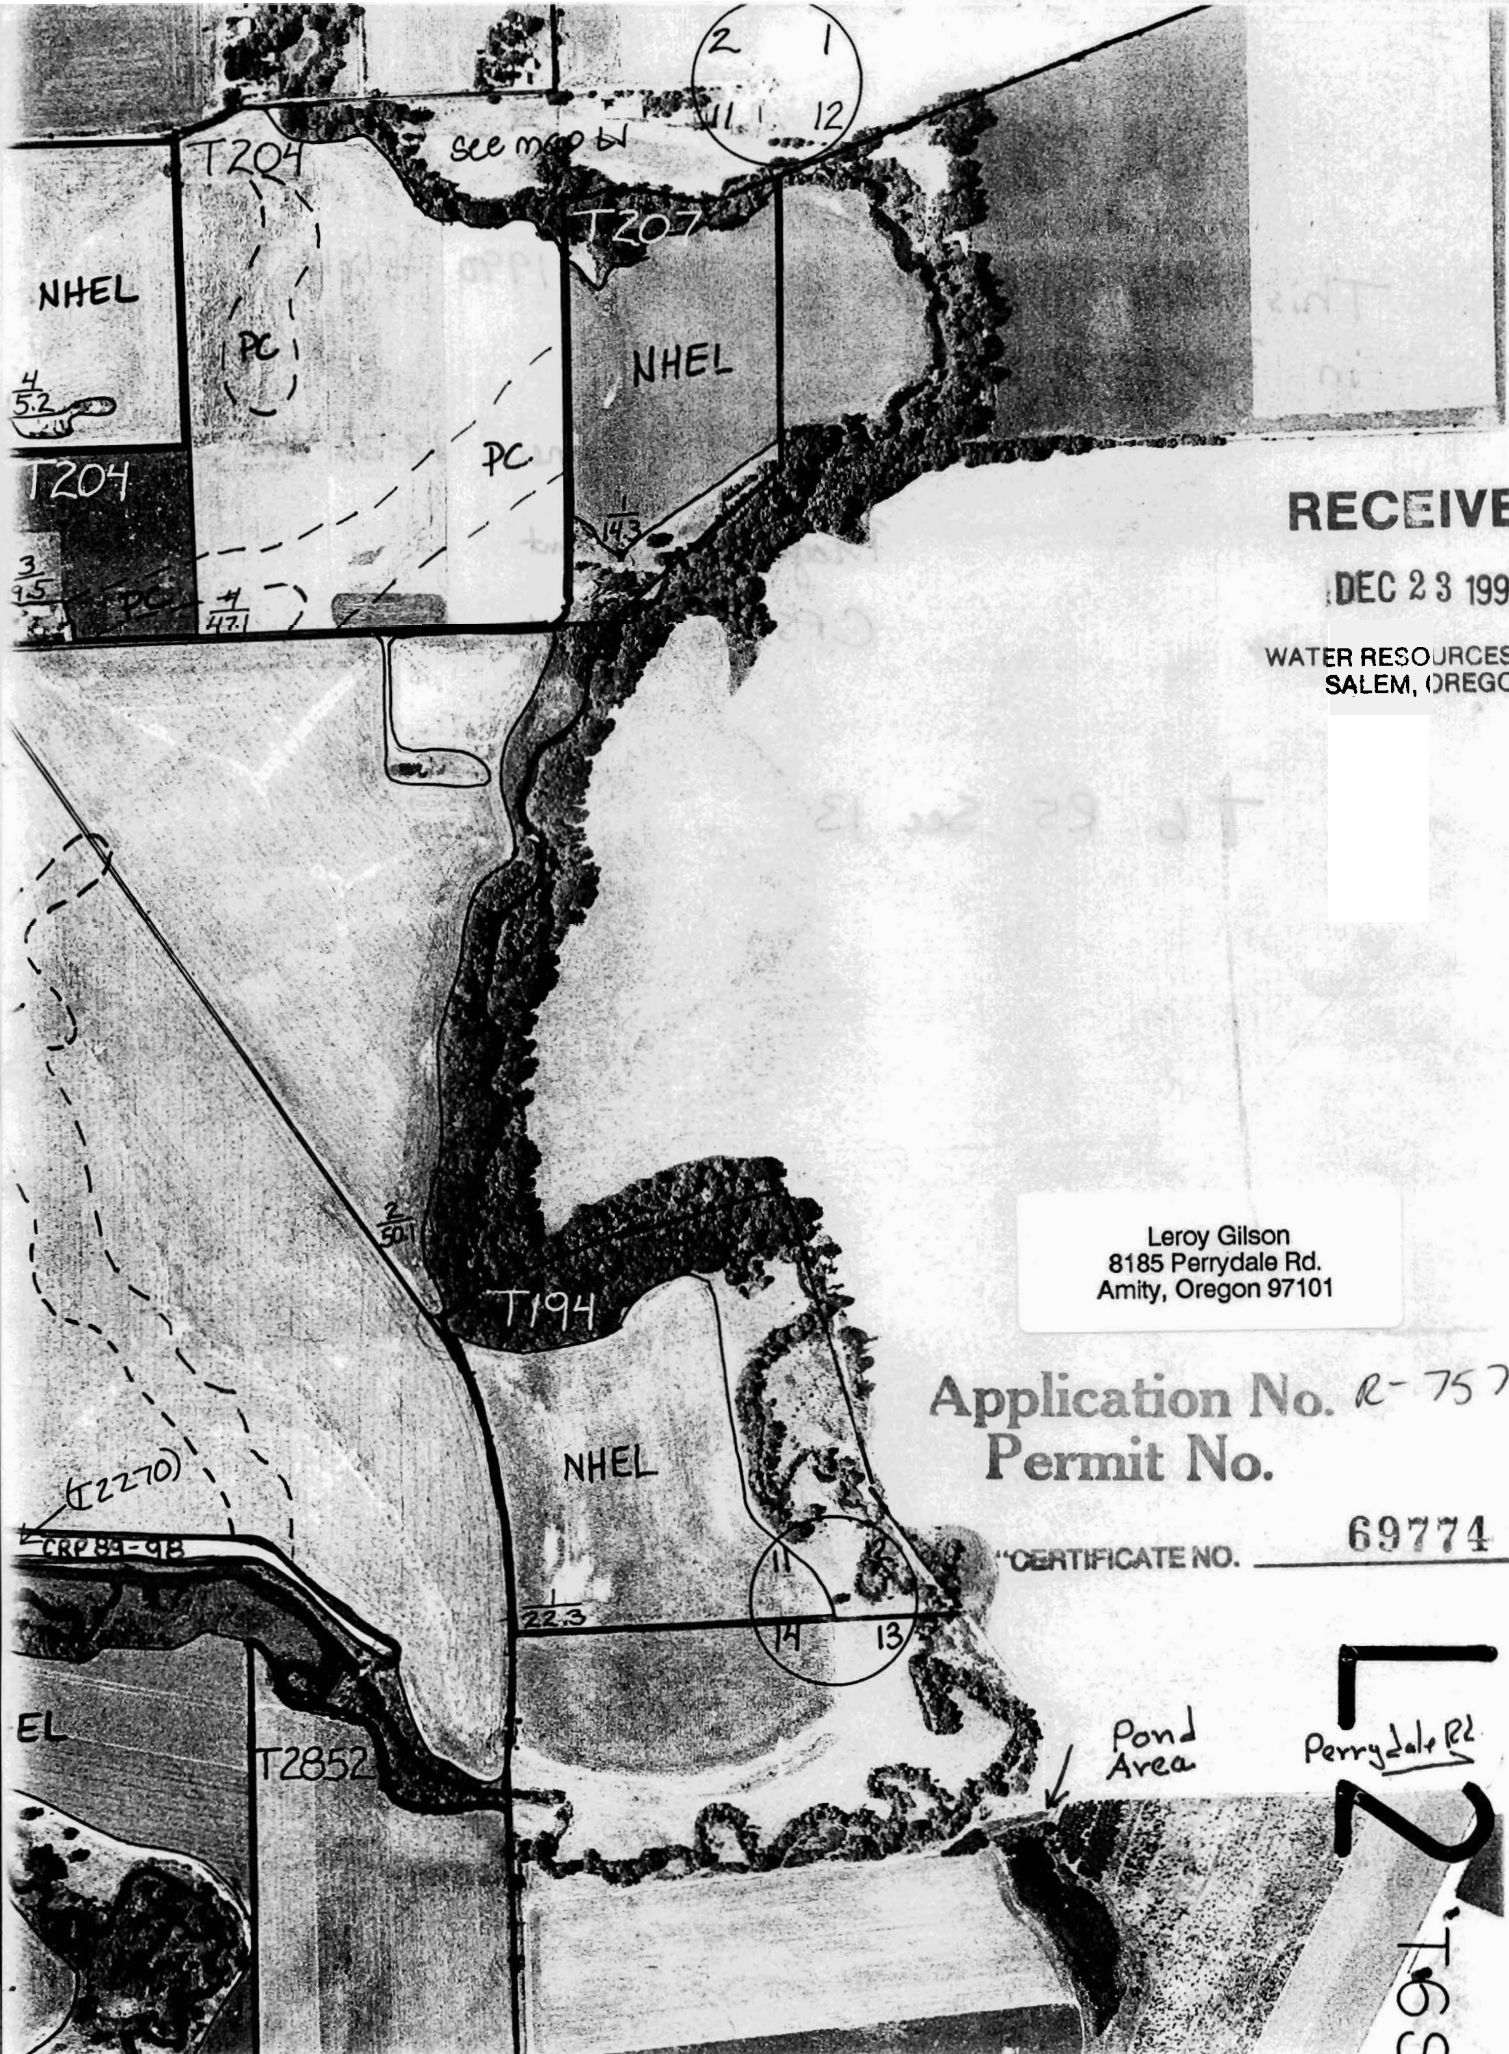

RECEIVED

DEC 23 1994

WATER RESOURCES DEPT.
SALEM, OREGON

Leroy Gilson
8185 Perrydale Rd.
Amity, Oregon 97101

Application No. R-75761
Permit No.

"CERTIFICATE NO. 69774"

See other side →

2
TGS