


RECEIVED

DEC 22 1994

WATER RESOURCES DEPT.
SALEM, OREGON

T. 1 N. & 1 S. R. 38 E. W.M.

T1N, R38E Union Co., Oregon
SE 1/4 SE 1/4 of Section 33

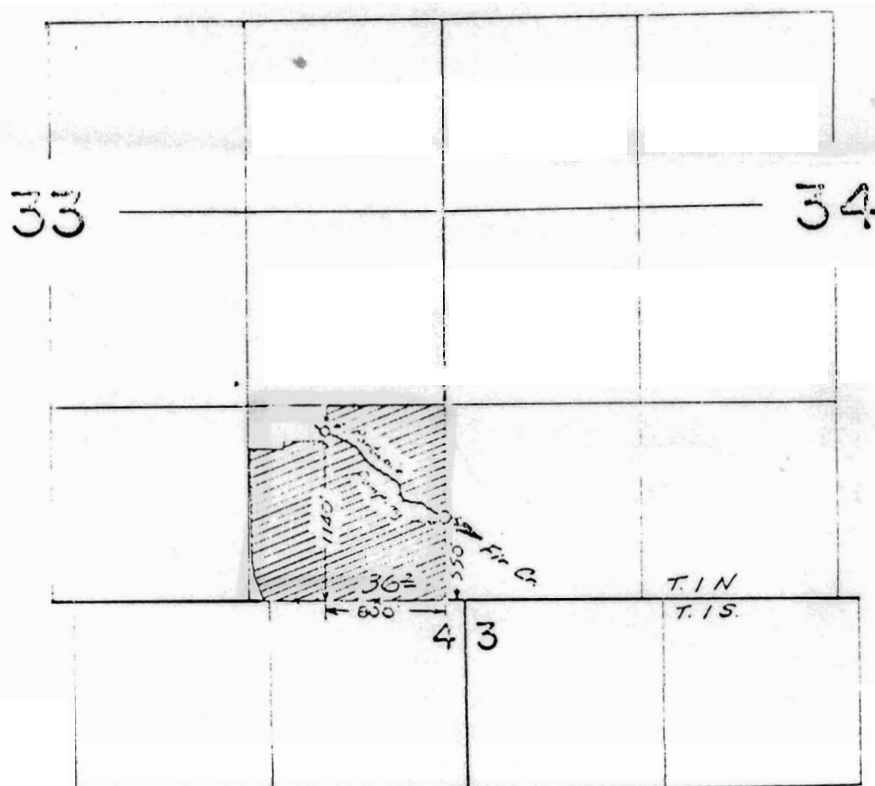

Application No. R-75773
Permit No.

CERTIFICATE NO. 69784
FINAL PROOF SURVEY
UNDER

Application No. 42865 Permit No. 32037
IN NAME OF

NORA F. HANSON

Surveyed 27 AUG. 1969, by W. J. RUPPERT