

THIS MAP WAS PREPARED FOR
ASSESSMENT PURPOSE ONLY.


REVISED ON
7-24-92

27 4 12

1"-400'

CERTIFICATE NO. 69791

Application No. R-75780
Permit No.

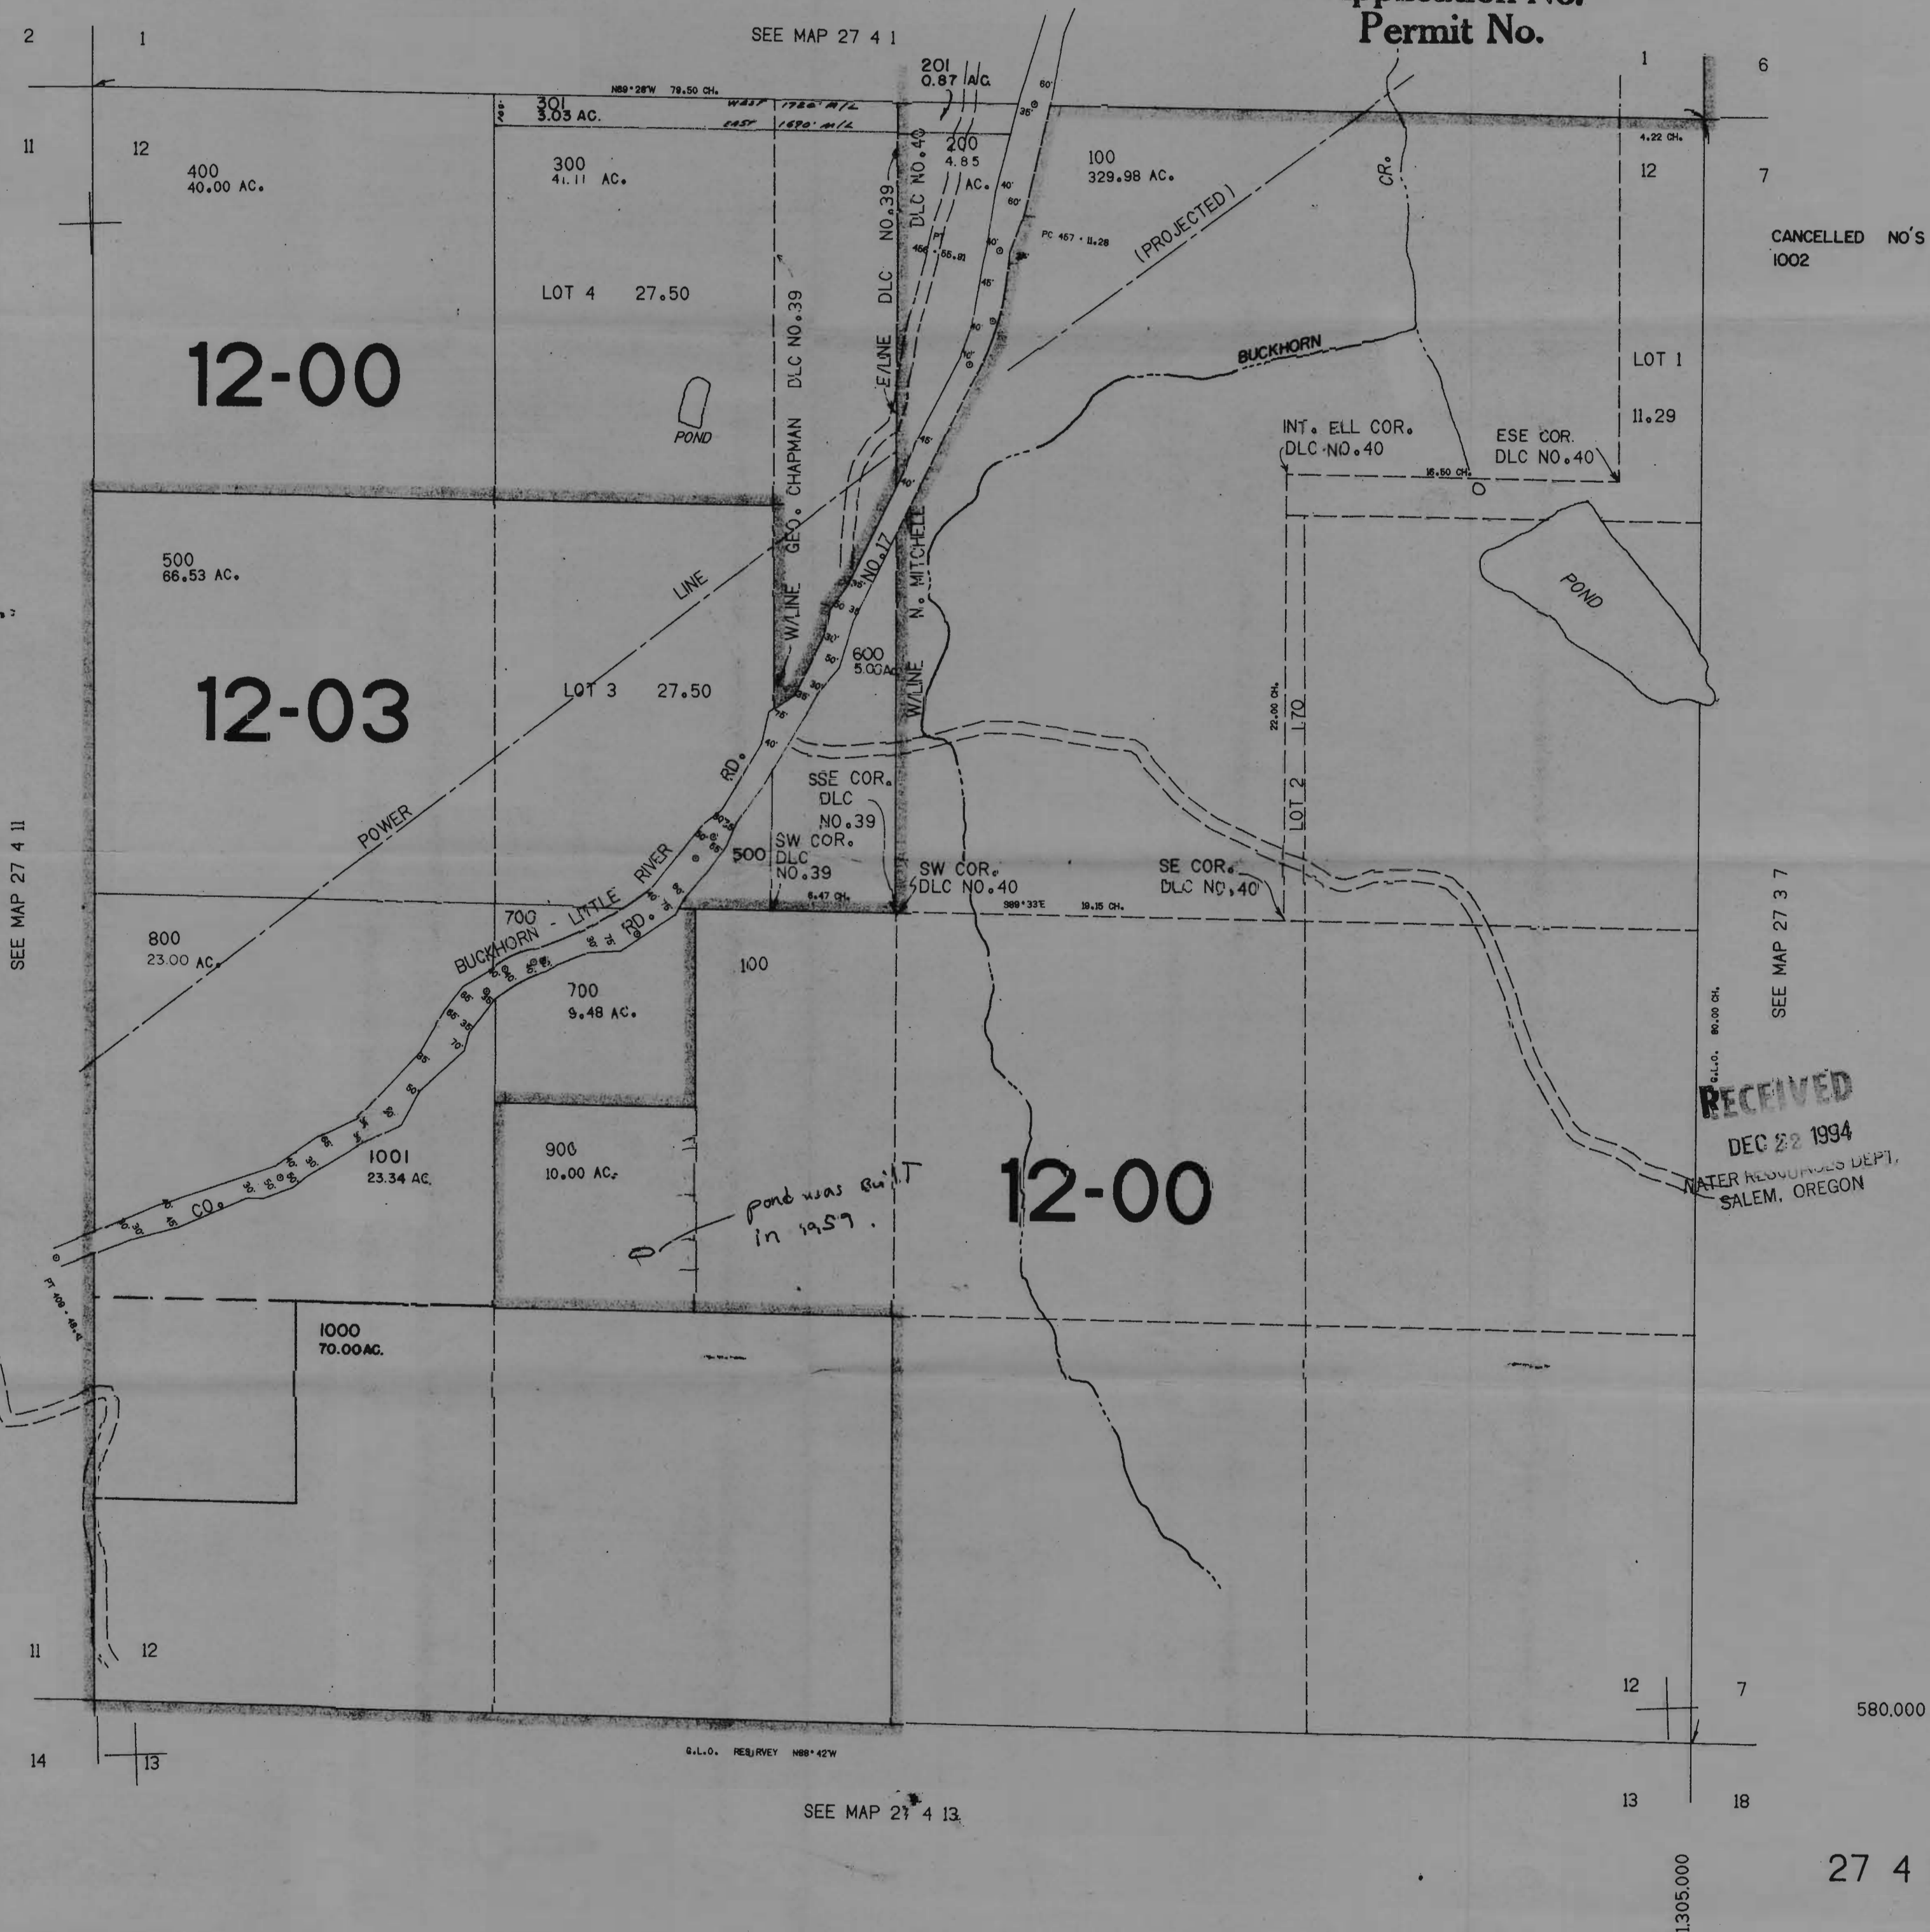

27 4 12