


CERTIFICATE NO. 69793

17 E / 10

Application No. R-75783
Permit No.

COLEMAN JOINT QUADRANGLE
OREGON-LAKE CO.
7.5 MINUTE SERIES (TOPOGRAPHIC)

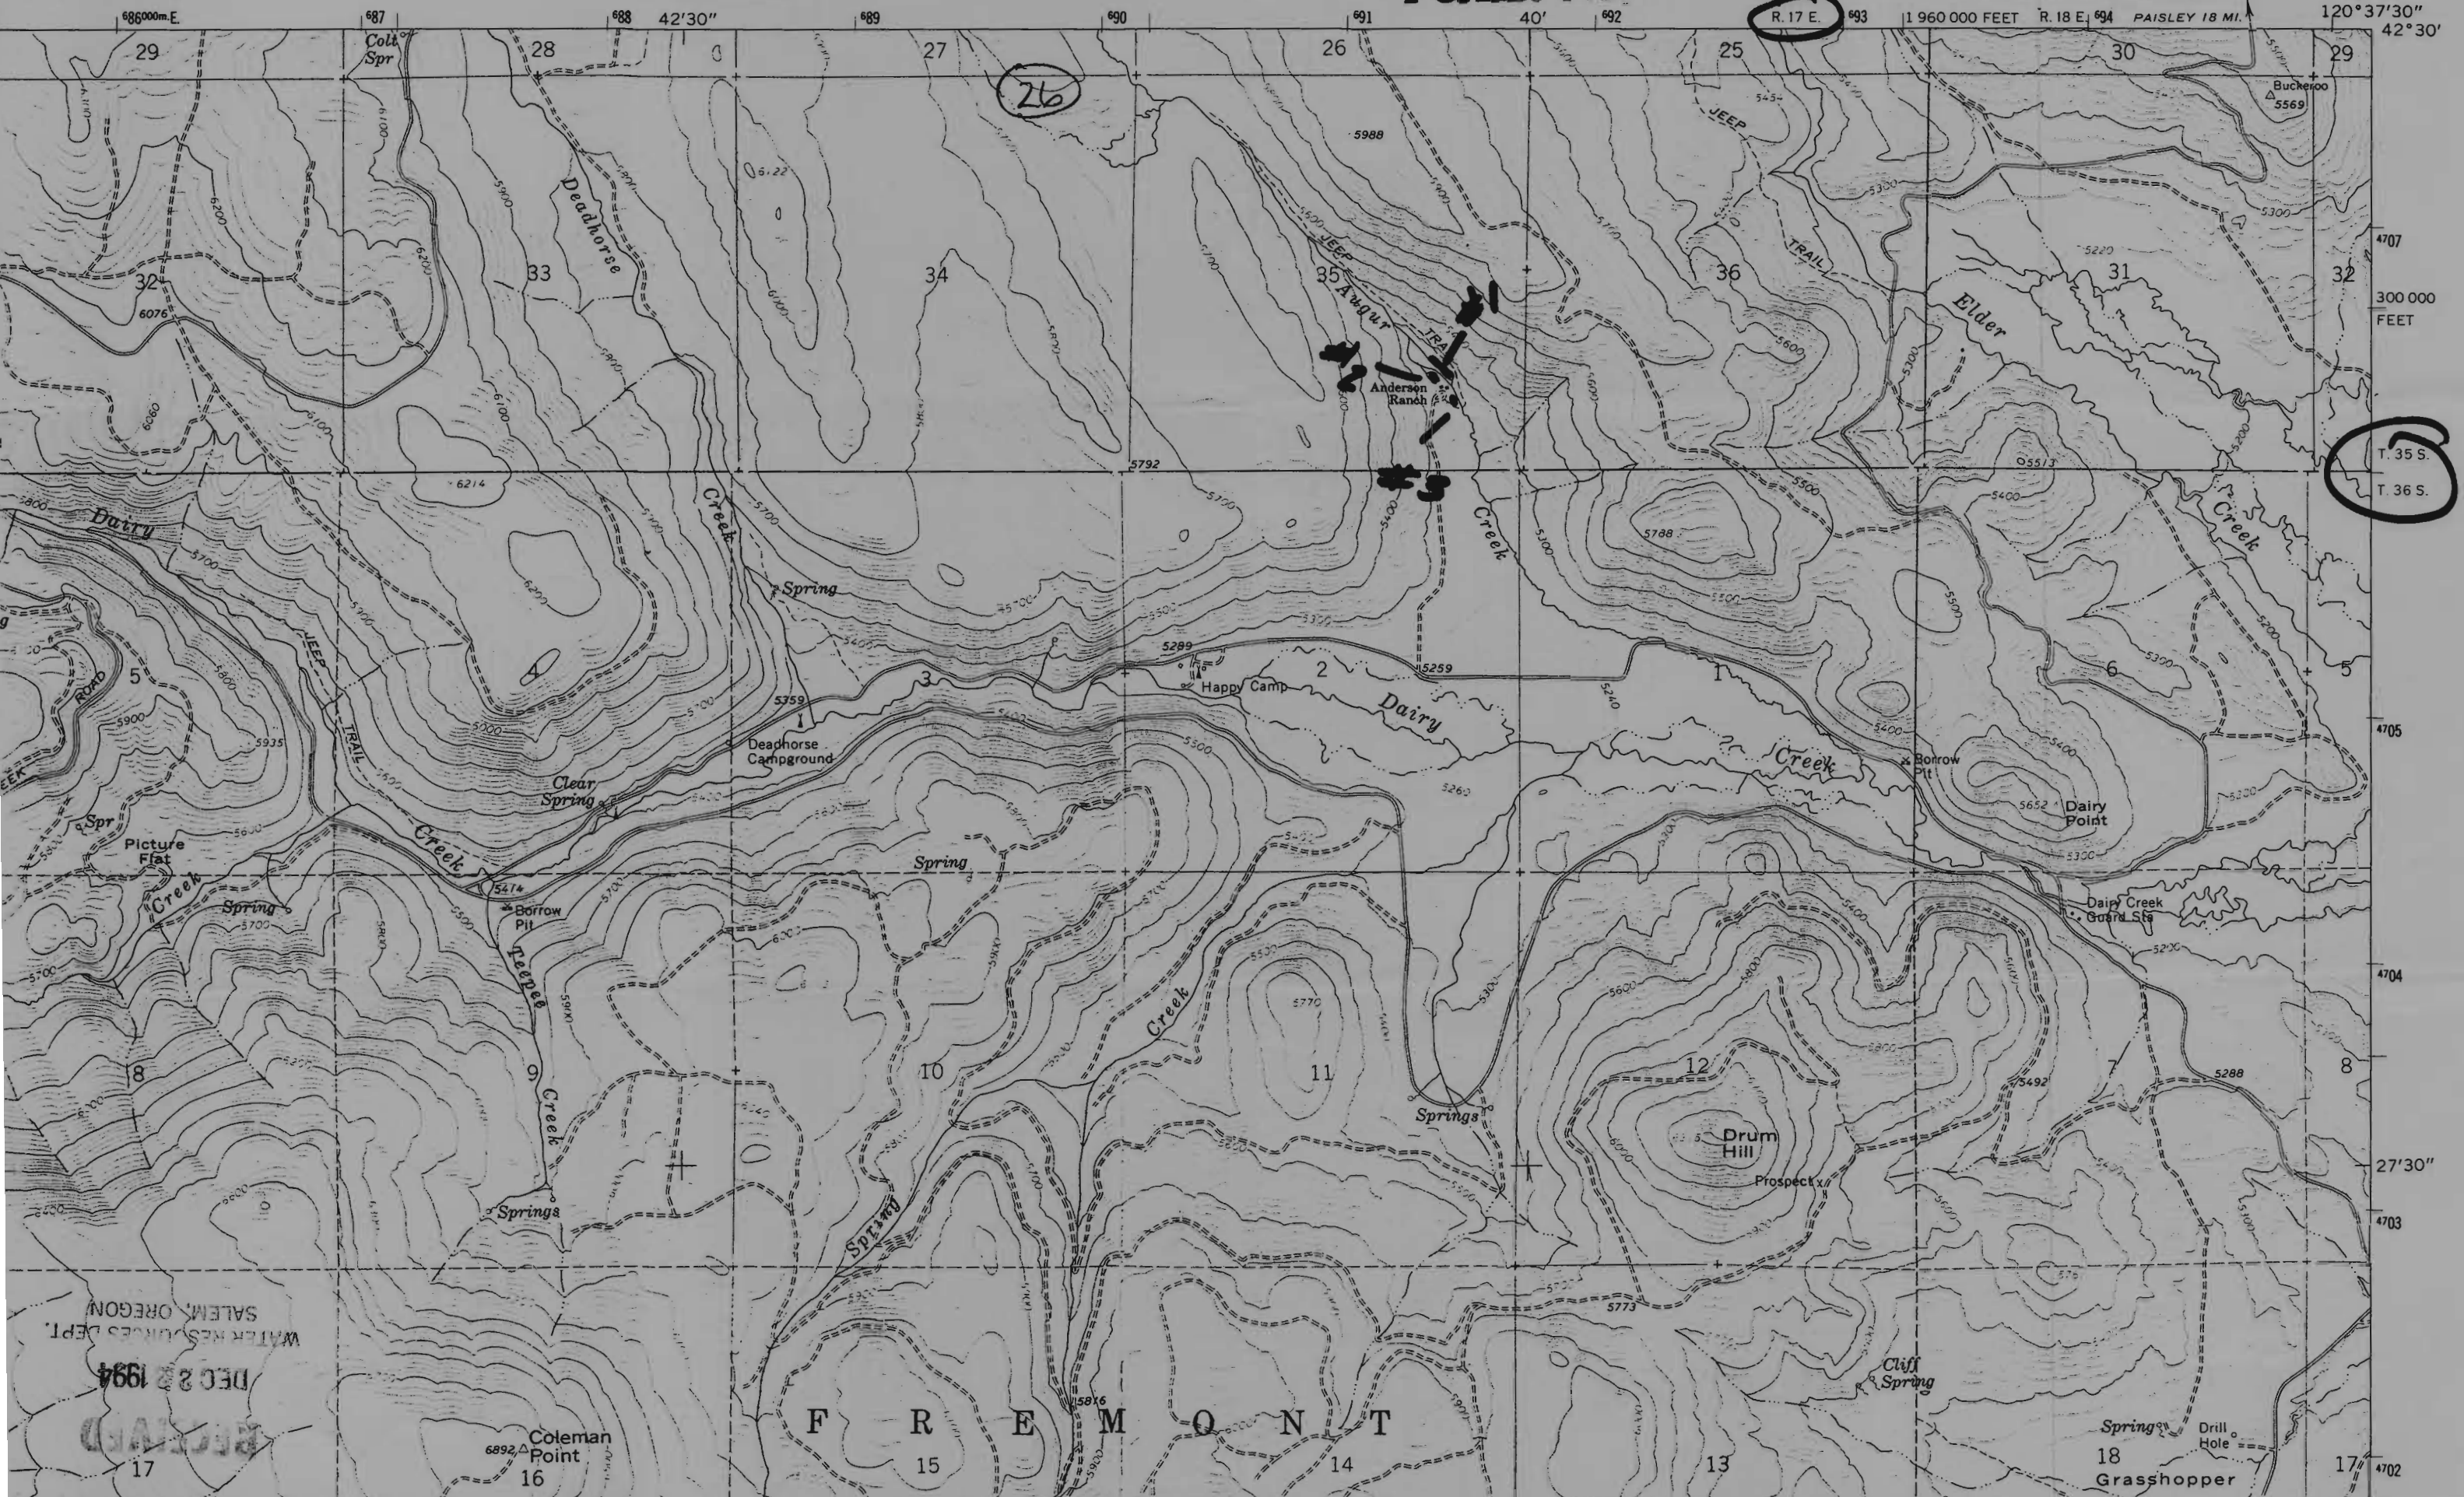

WATER RESOURCES DEPT.
SALEM, OREGON

DEC 2 1994

RECORDED

6892 Coleman Point

F R E M O N T

18 Grasshopper

17