

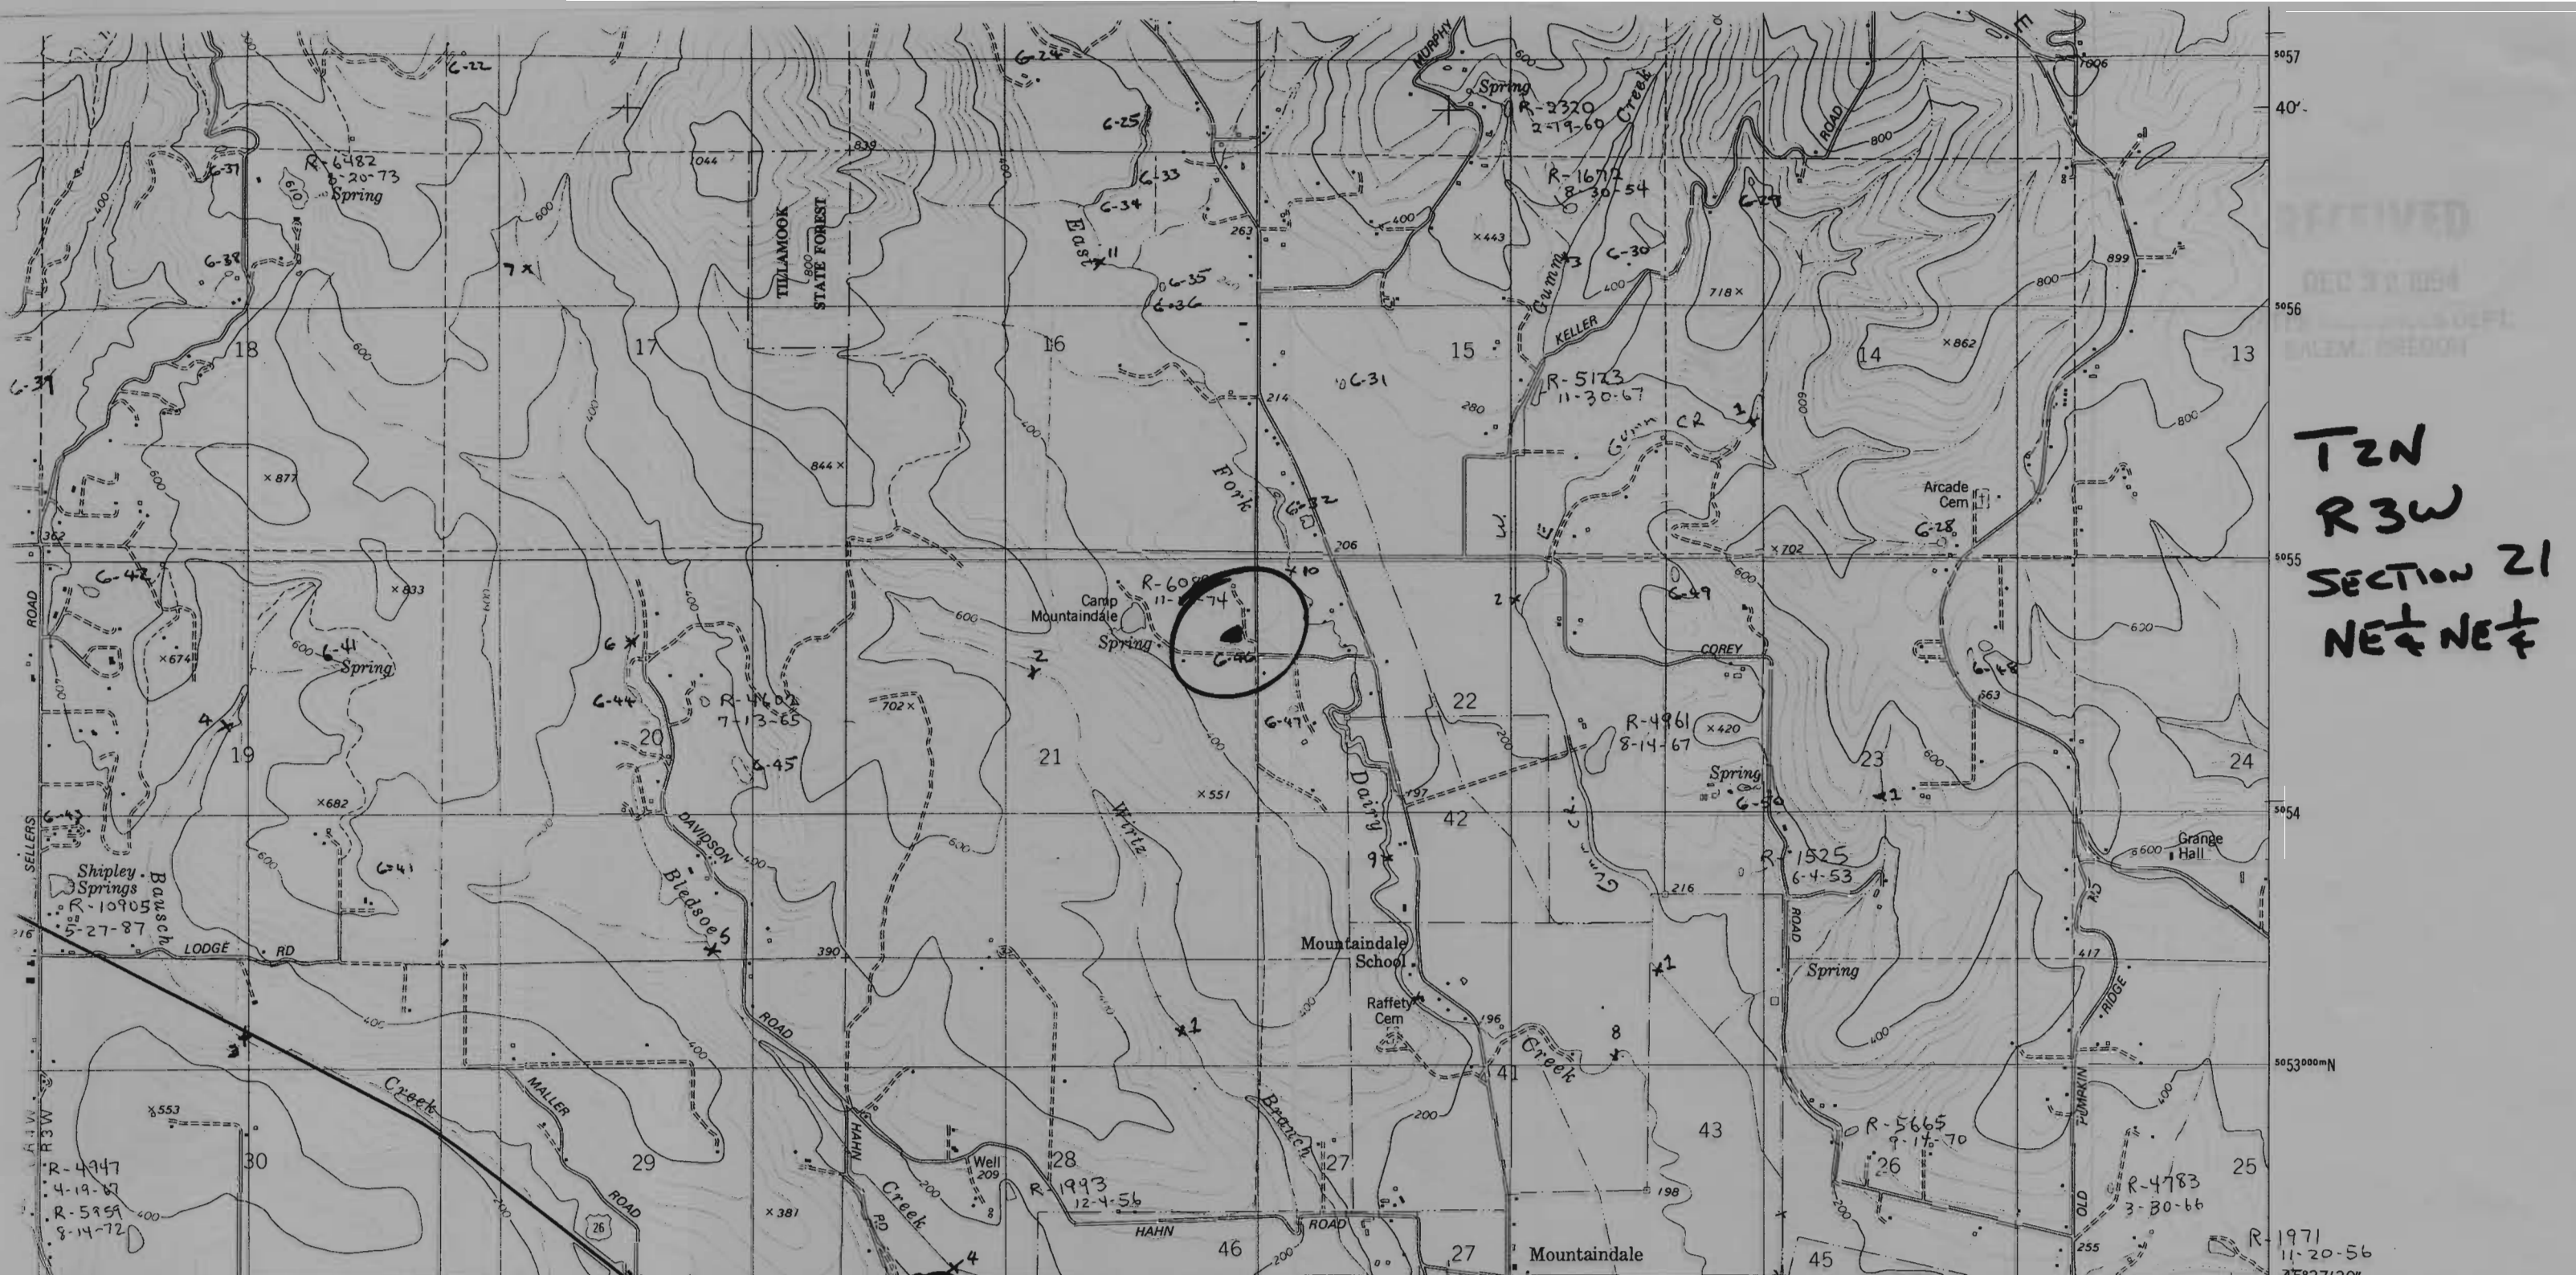
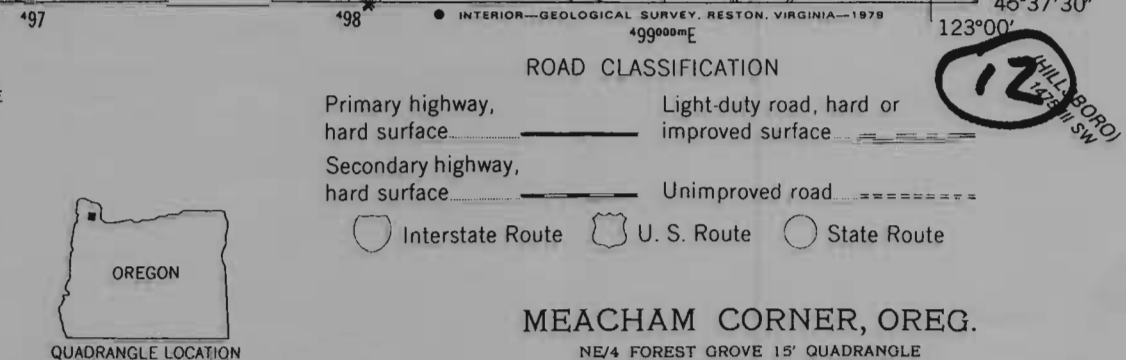


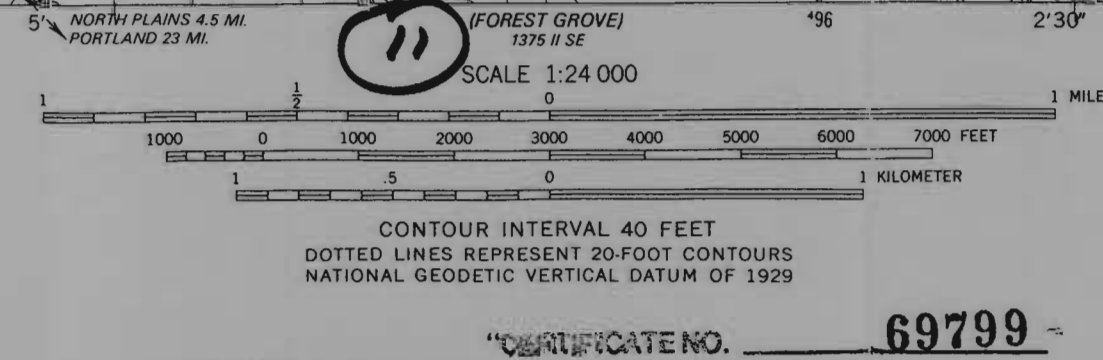

Published by the Geological Survey
NOAA
Metric methods from aerial
Field checked 1974. Map edited 1979
grid ticks: Oregon coordinate
(conformal conic)
verse Mercator grid, zone 10
North American Datum 1983
3 meters north and
dashed corner ticks
ings within the boundaries of
ations shown on this map
te selected fence and field lines
erial photographs

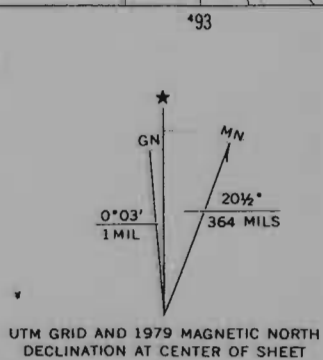

CERTIFICATE NO. **69799**
THIS MAP COMPLIES WITH NATIONAL MAP ACCURACY STANDARDS
FOR SALE BY U. S. GEOLOGICAL SURVEY, DENVER, COLORADO 80225, OR RESTON, VIRGINIA 22092
A FOLDER DESCRIBING TOPOGRAPHIC MAPS AND SYMBOLS IS AVAILABLE ON REQUEST

Application No. **L-75789**
Permit No.
DMA 1375 II NE-SERIES V892

6