


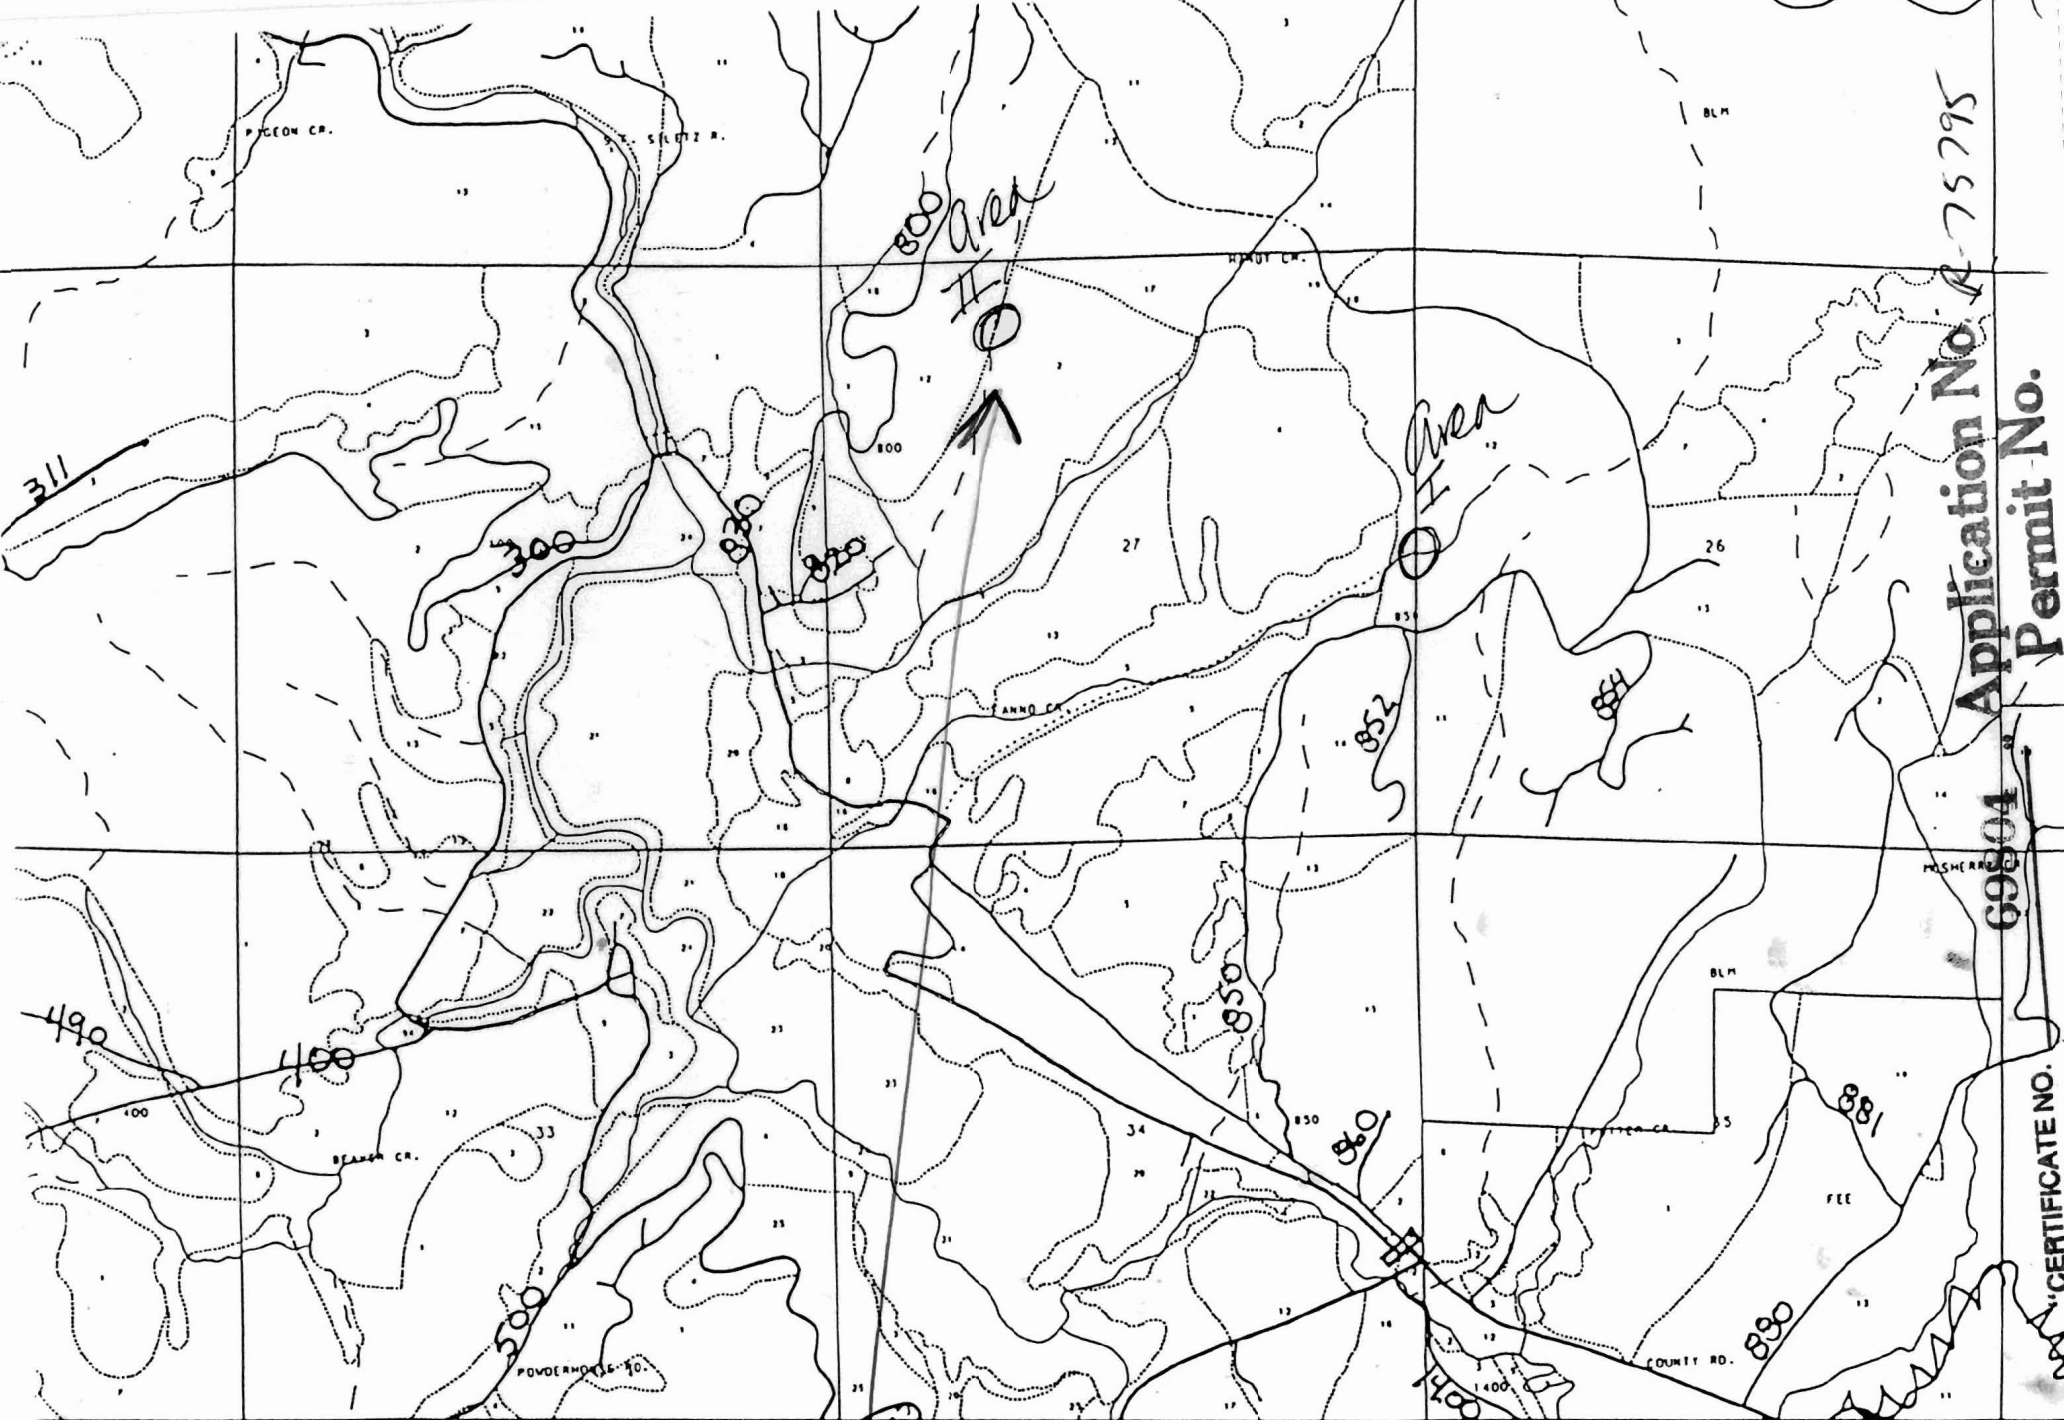

Valsetz area ponds

858W


S. 27

Application No. 75795

69804

Permit No.

CERTIFICATE NO.

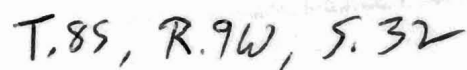

"CERTIFICATE NO.