


Application No. 2-75798
Fireblock

844

"CERTIFICATE NO. 69807 "

Fireblock: WASSON CANYON

Photo: 75A26 Township: 36S03E Section: 16

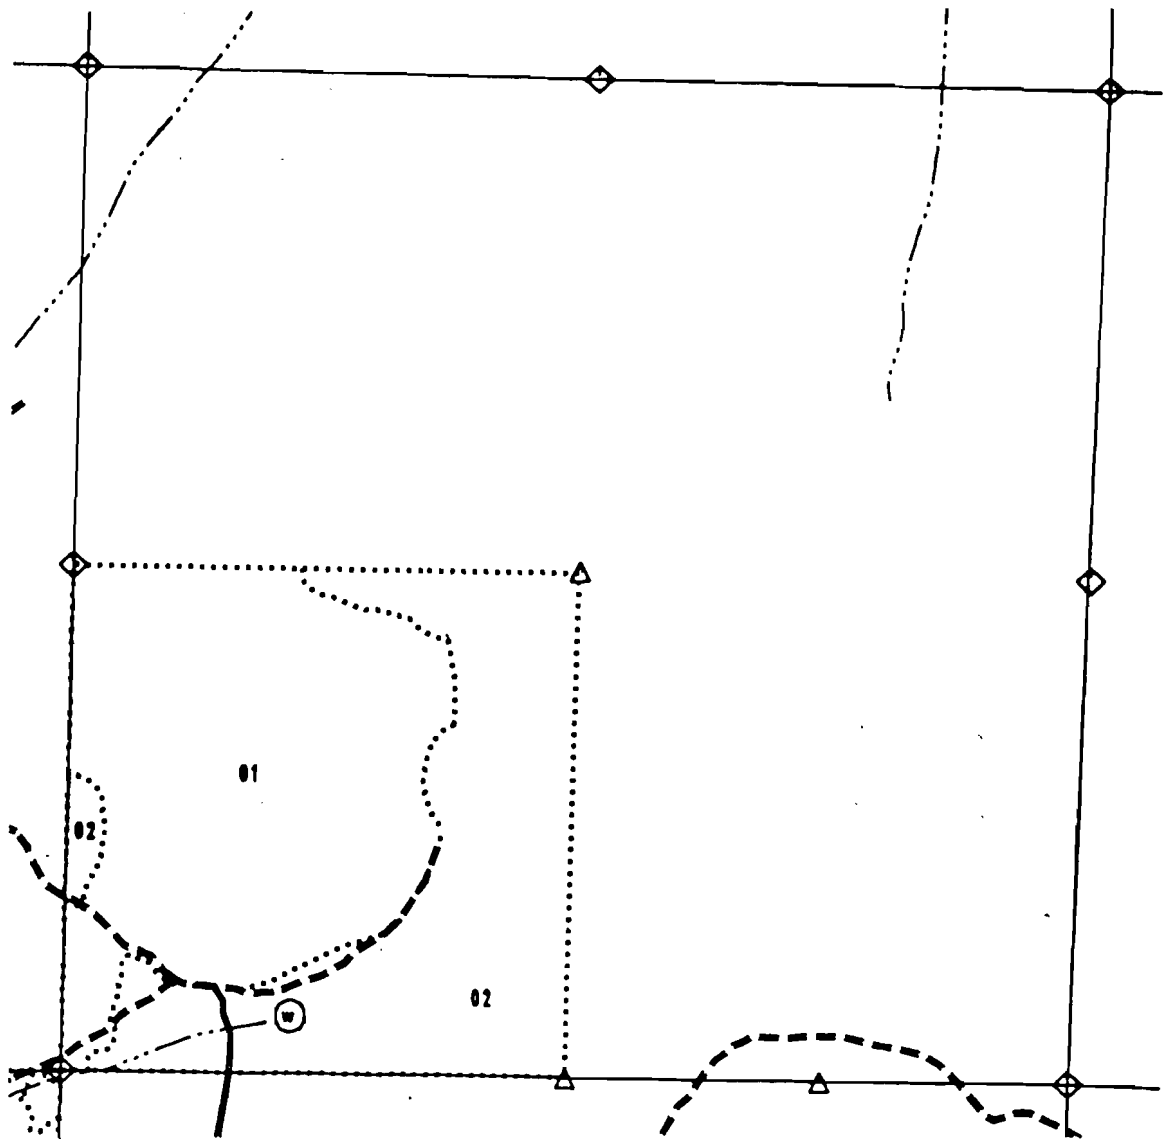

County: JACKSON

Approx Map Scale: 1" = 1000'


Revised Date:

Application No. R 75798
Certificate No.

CERTIFICATE NO. 69807

#85

Fireblock: WASSON CANYON Photo: 75A23 Township: 36S03E Section: 28

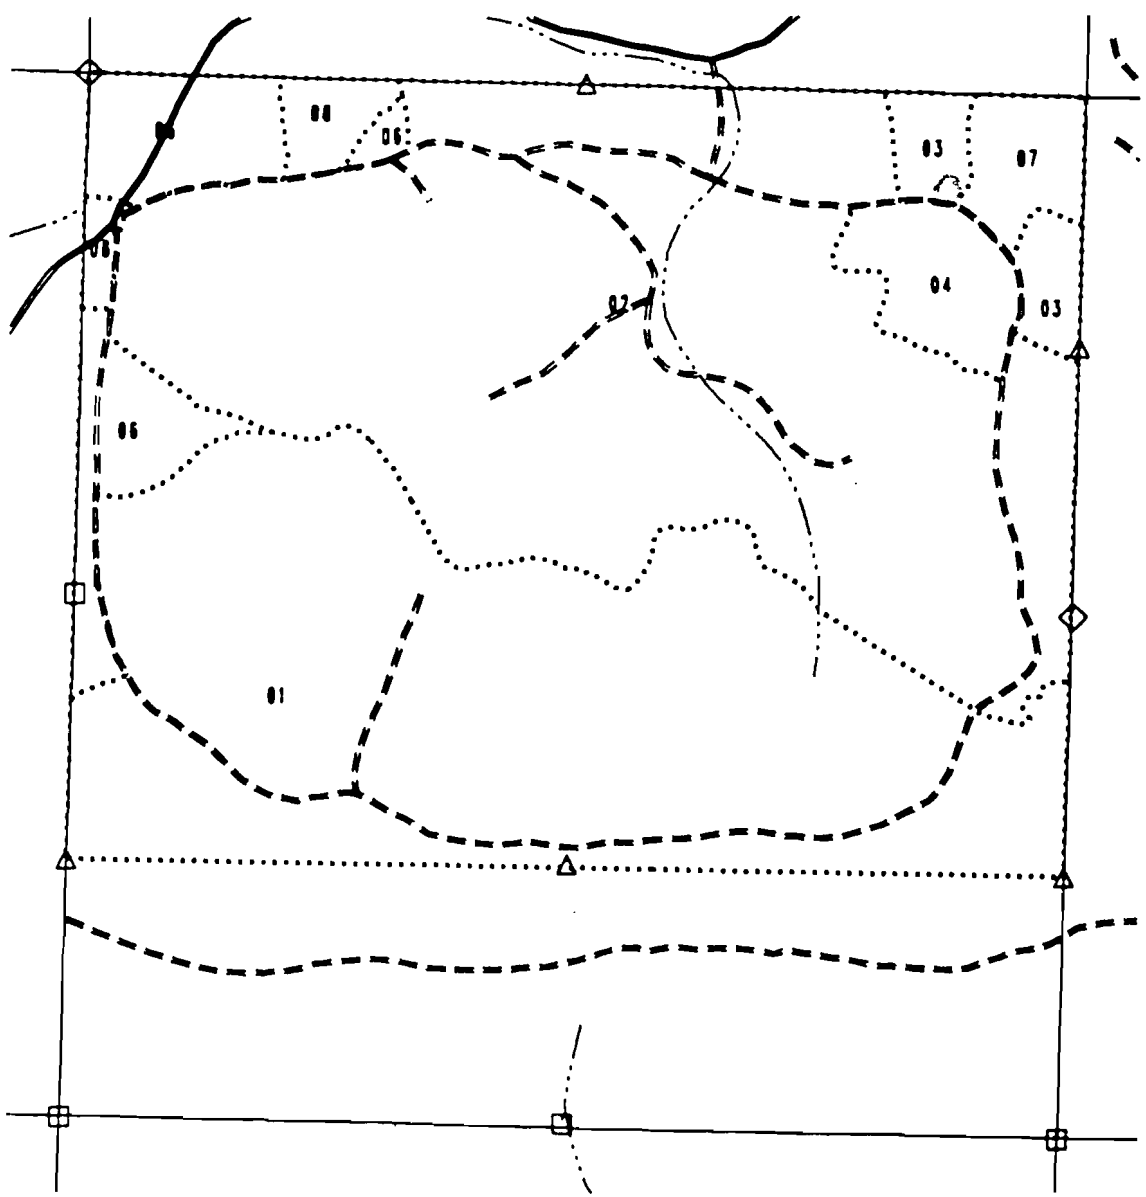

County: JACKSON Approx Map Scale: 1" = 1000' Revised Date:

"CERTIFICATE NO. 69802"


#91 Section No. 12 75798
Permit No.

BOISE CASCADE CORPORATION

Fireblock: PROSPECT

Photo:

Township: 33S02E Section: 01

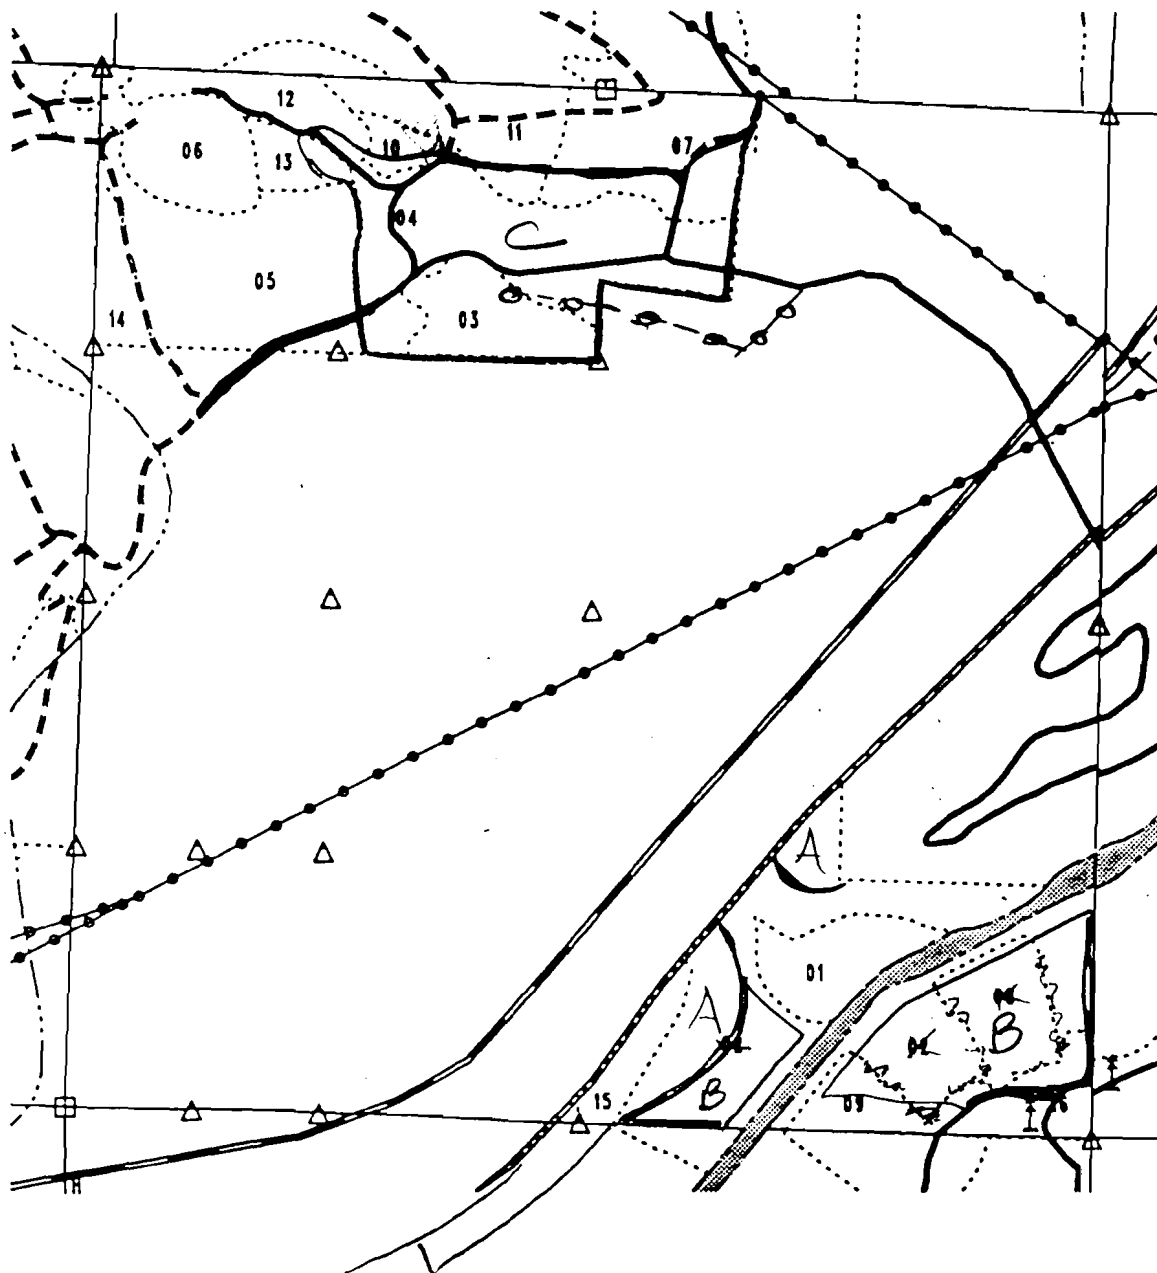

County: JACKSON


Approx Map Scale: 1" = 1000'

Revised Date:

Application No. R-75798
Toll No. 69807 #93
CORRELATE NO. _____

Fireblock: PROSPECT

Photo: 73-86 Township: 32S03E Section: 31

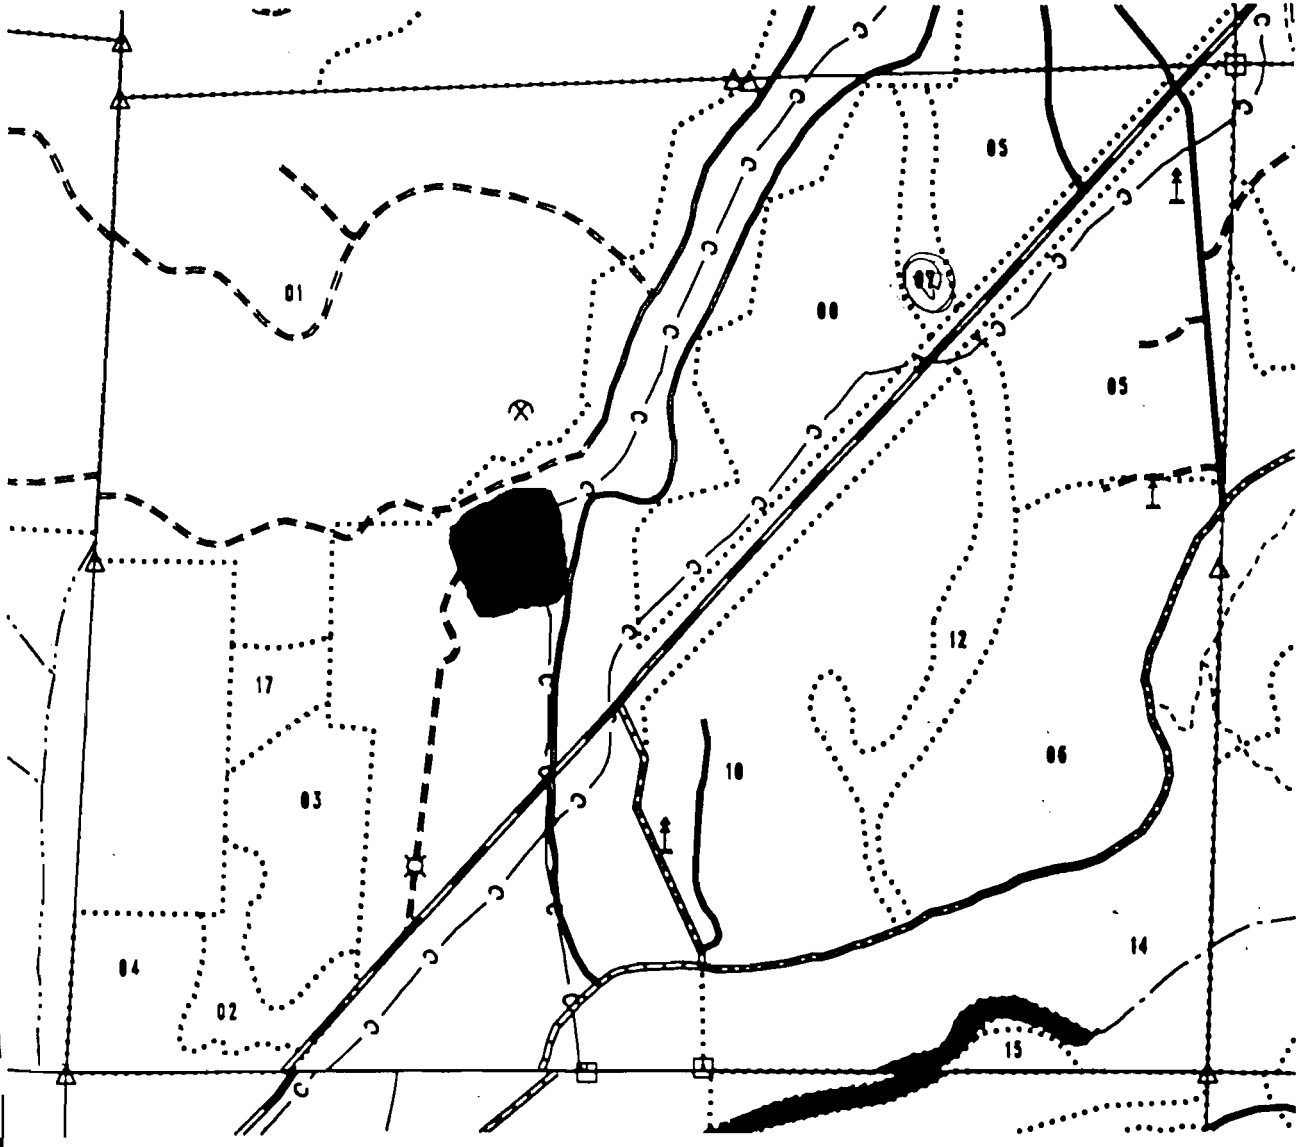

County: JACKSON

Approx Map Scale: 1" = 1000'

Revised Date:

Application No. R-75798

Plan No.

CERTIFICATE NO. 69807


#95

polyton
#2799

Beaver Dam

Fireblock: DEAD INDIAN

Photo: 81A3 Township: 38S04E Section: 04

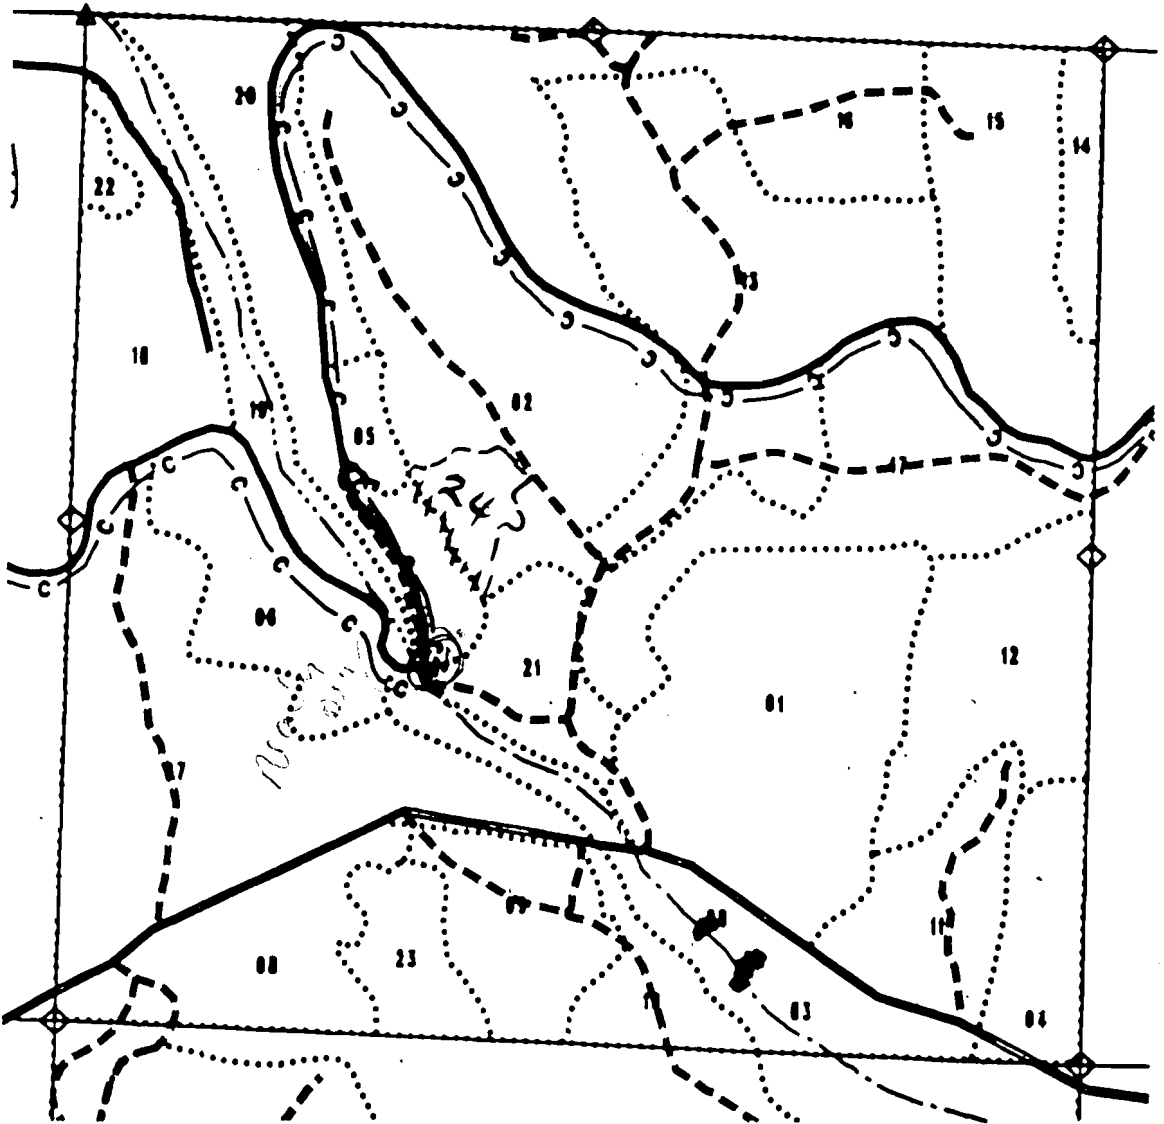

County: JACKSON

Approx Map Scale: 1" = 1000'

Revised Date:

896


App. No. R-75798
Plan No.

69807

DETECTABLE

Shelter

Fireblock: DEAD INDIAN Photo: 78-37 Township: 37S03E Section: 36

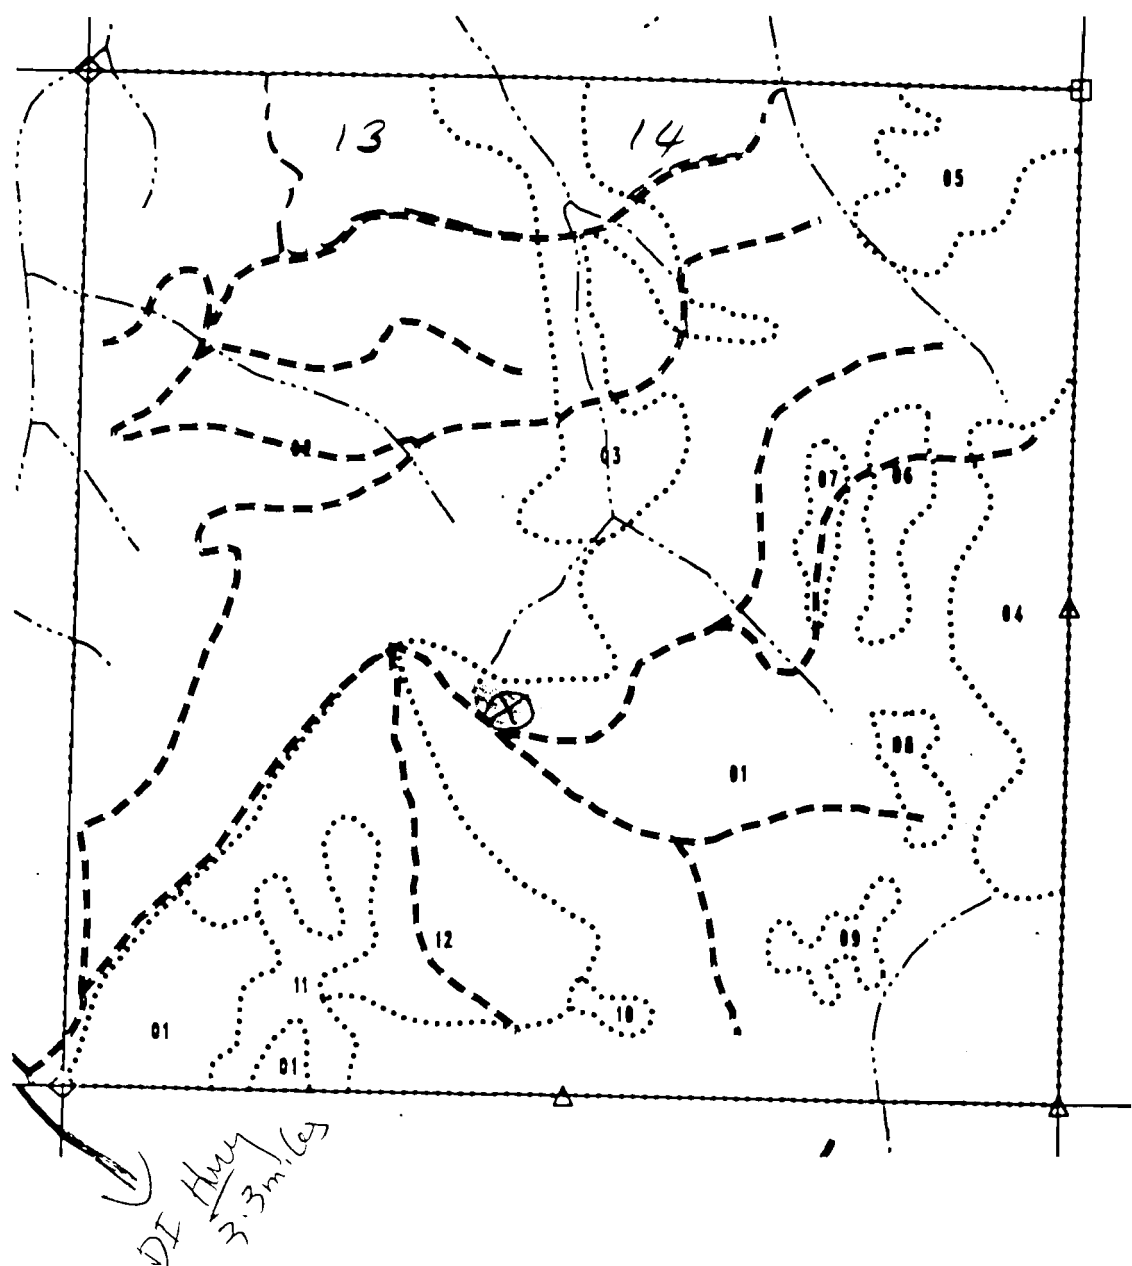

County: JACKSON Approx Map Scale: 1" = 1000' Revised Date: