


CATENO. 69808

#27

Application No. R-75799  
Permit No.

Fireblock: EAST EVANS CREEK Photo: 51832 Township: 33S02W Section: 04

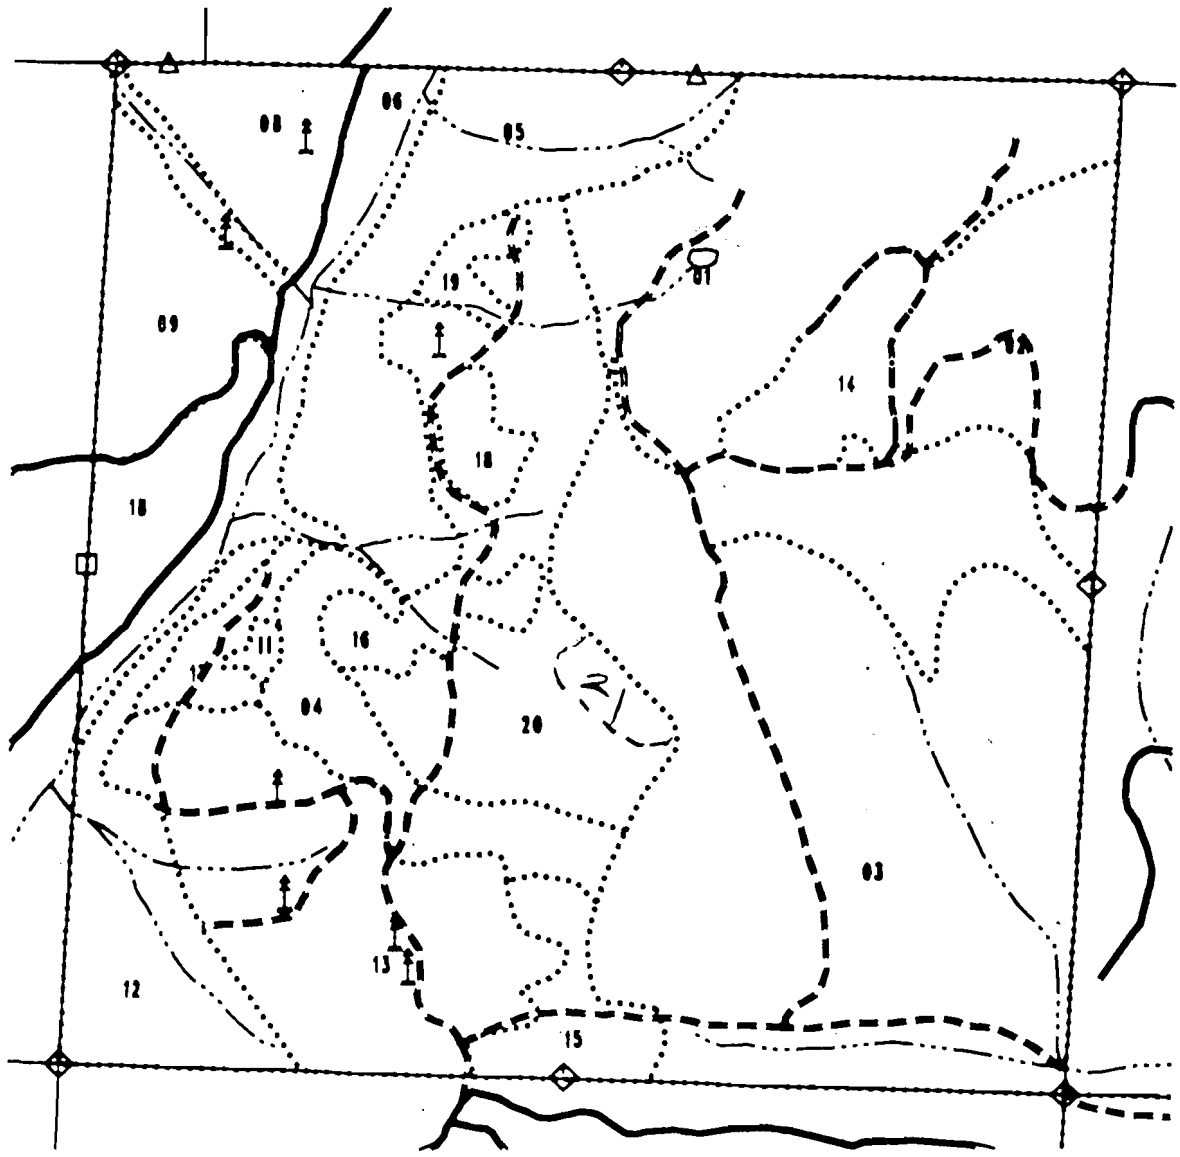

County: JACKSON Approx Map Scale: 1" = 1000' Revised Date:


Application No R-79799  
Formal No.

# 29

"CERTIFICATE NO. 69808"

As shown

Fireblock: EAST EVANS CREEK Photo: 52521 Township: 34S02W Section: 10

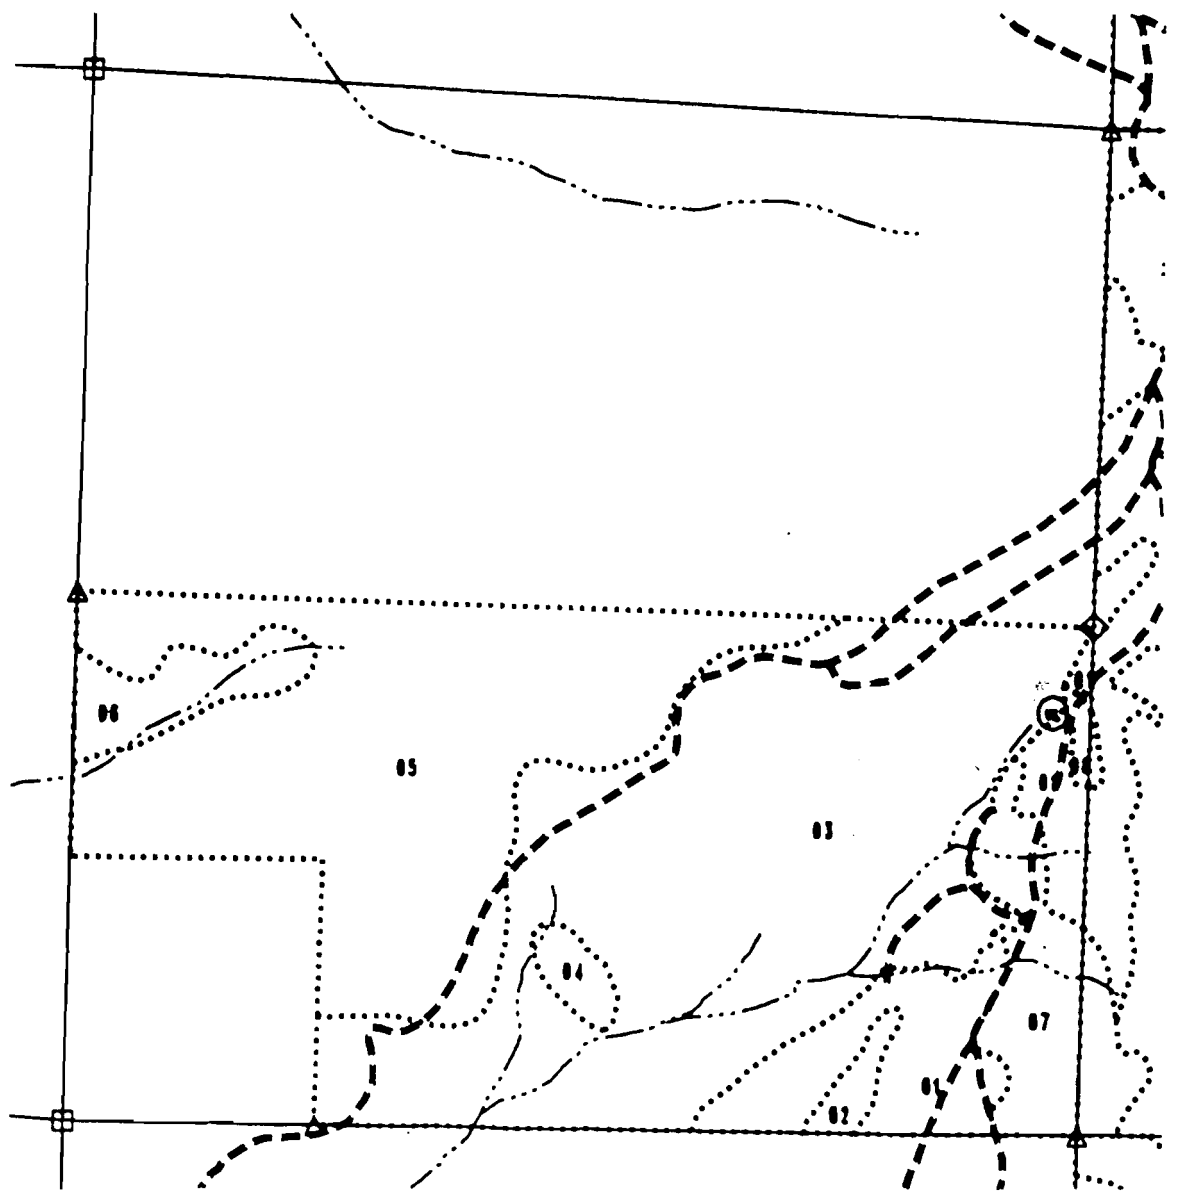

County: JACKSON Approx Map Scale: 1" = 1000' Revised Date:


CERTIFICATE NO. 69808

#80

Applicant No. R 75799  
Parcel No.

poly #  
B4309

Fireblock: SISKIYOU Photo: 7-17 Township: 40S02E Section: 14

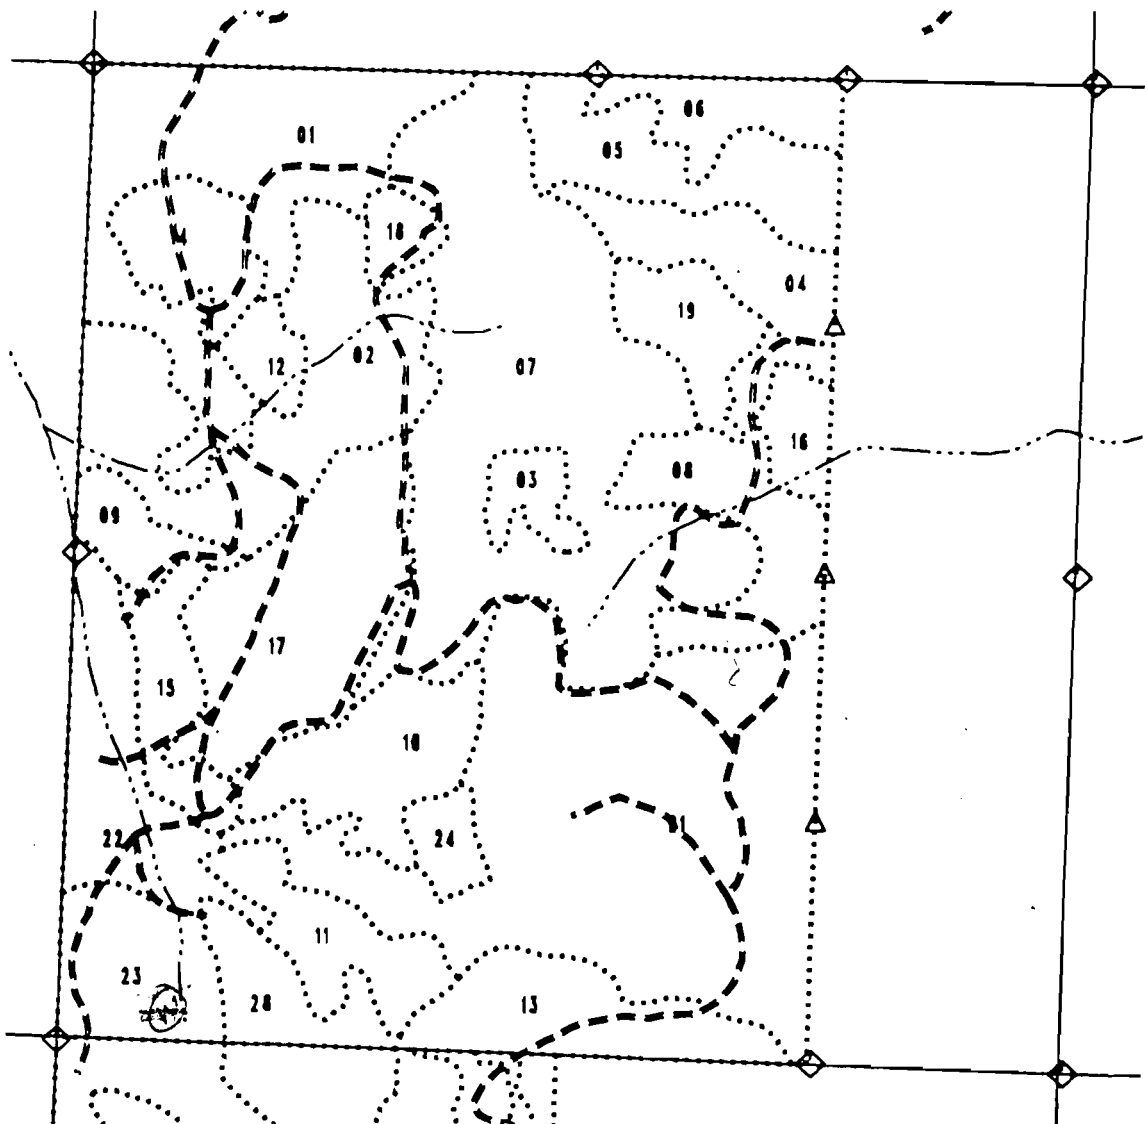

County: JACKSON Approx Map Scale: 1" = 1000' Revised Date:


69808

"CERTIFICATE NO. \_\_\_\_\_"

App. No. JK-75799  
Plan No.

Fireblock: **TIMBER MOUNTAIN** Photo: **43-22** Township: **37S03W** Section: **30**

#83

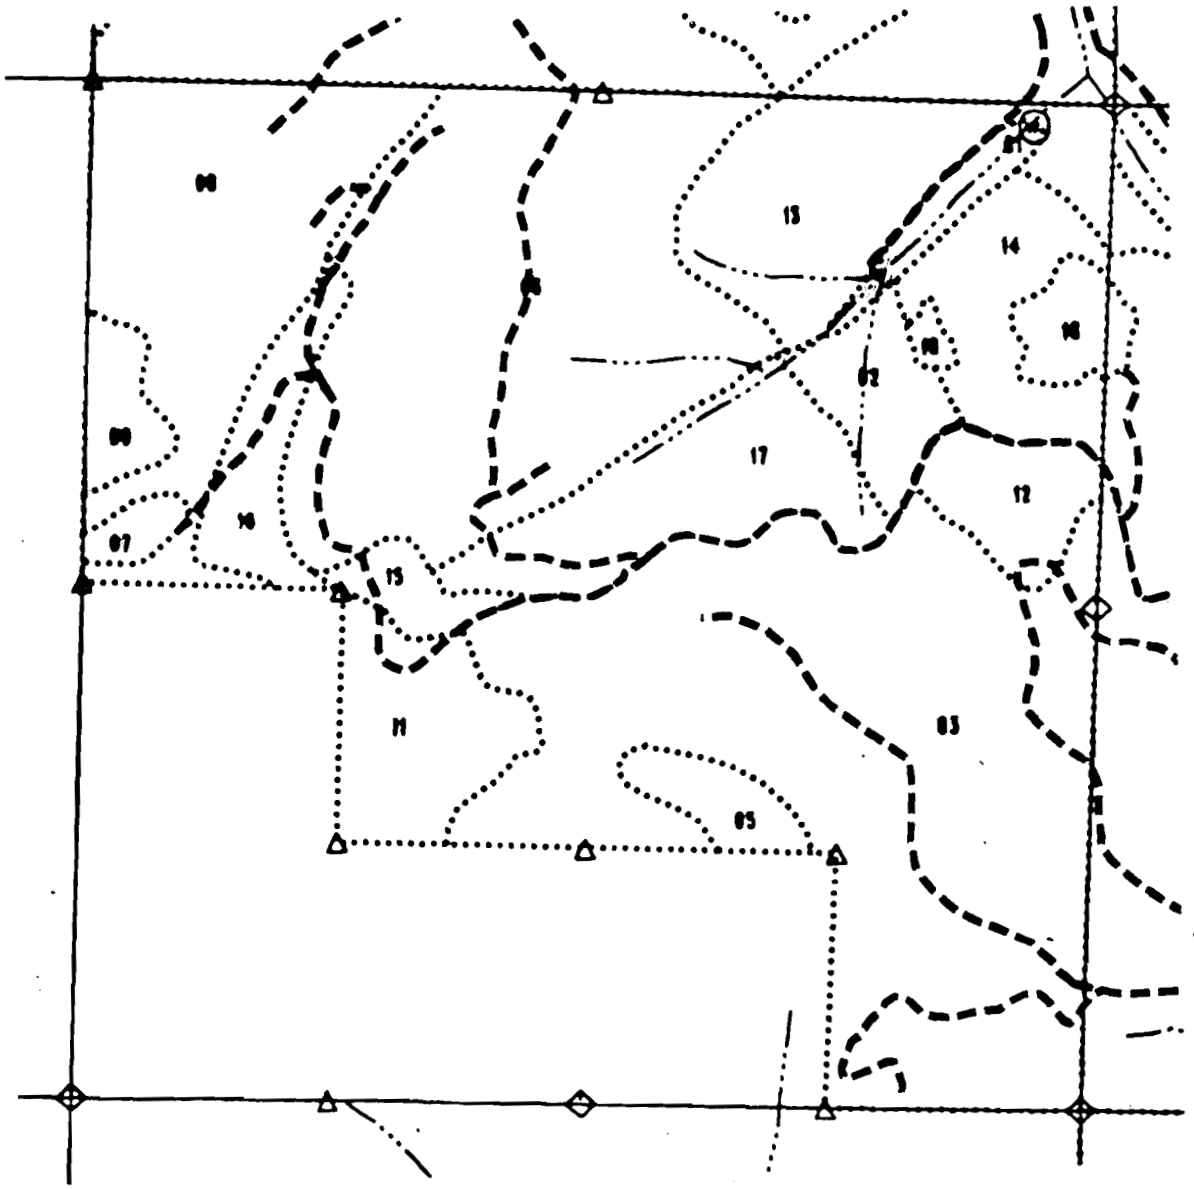

County: **JACKSON** Approx Map Scale: **1" = 1000'** Revised Date:

NO R 75799


Parcel No.

"CERTIFICATE NO. 69808"

188

Fireblock: WIMER

Photo: 45-42 Township: 35S03W Section: 16

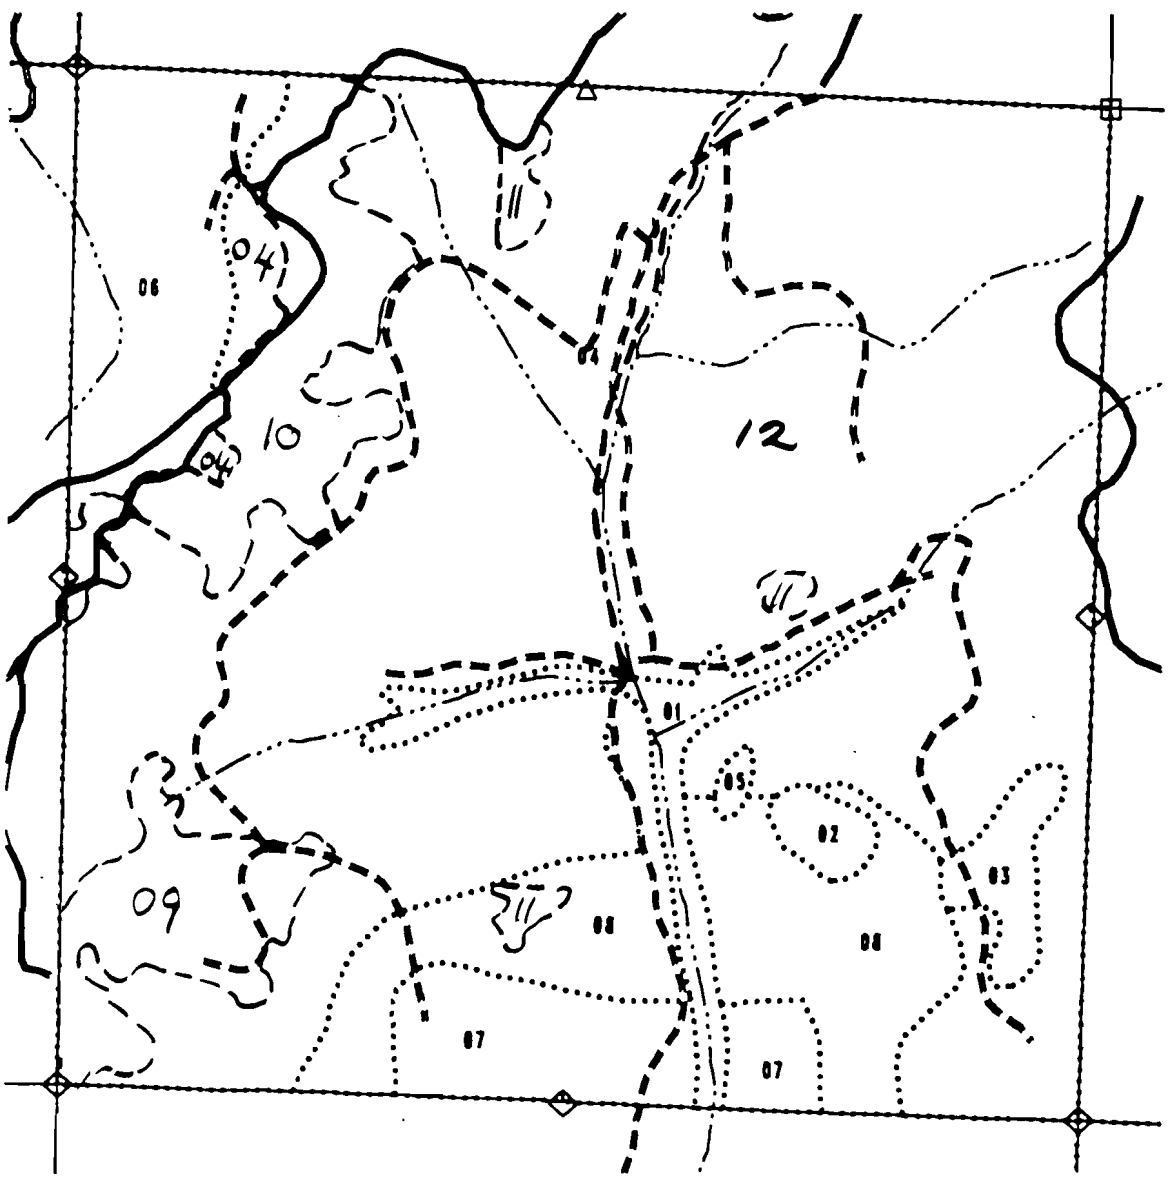

County: JACKSON


Approx Map Scale: 1" = 1000'

Revised Date:

Block 75799  
Certificate No. 69808  
"CERTIFICATE NO. 69808"

poln # B1714  
#94

Fireblock: SISKIYOU Photo: 71-14 Township: 40S02E Section: 26

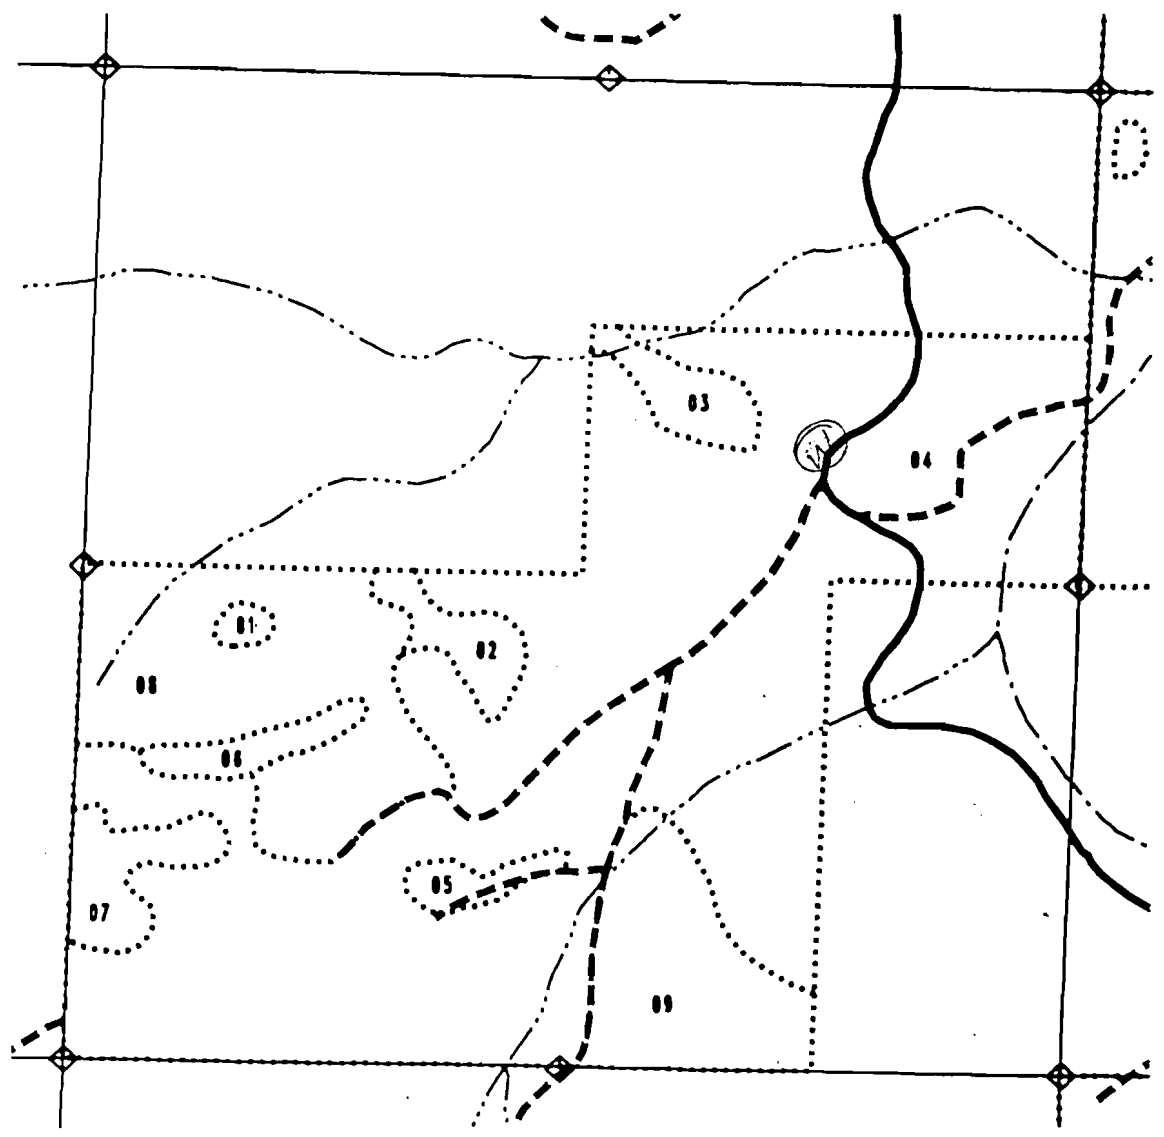

County: JACKSON Approx Map Scale: 1" = 1000' Revised Date: