


CERTIFICATE NO. 69809

Application No. R-75800  
Parcel No.

Fireblock: ANDERSON BUTTE

Photo: 51-13 Township: 39S02W Section: 16

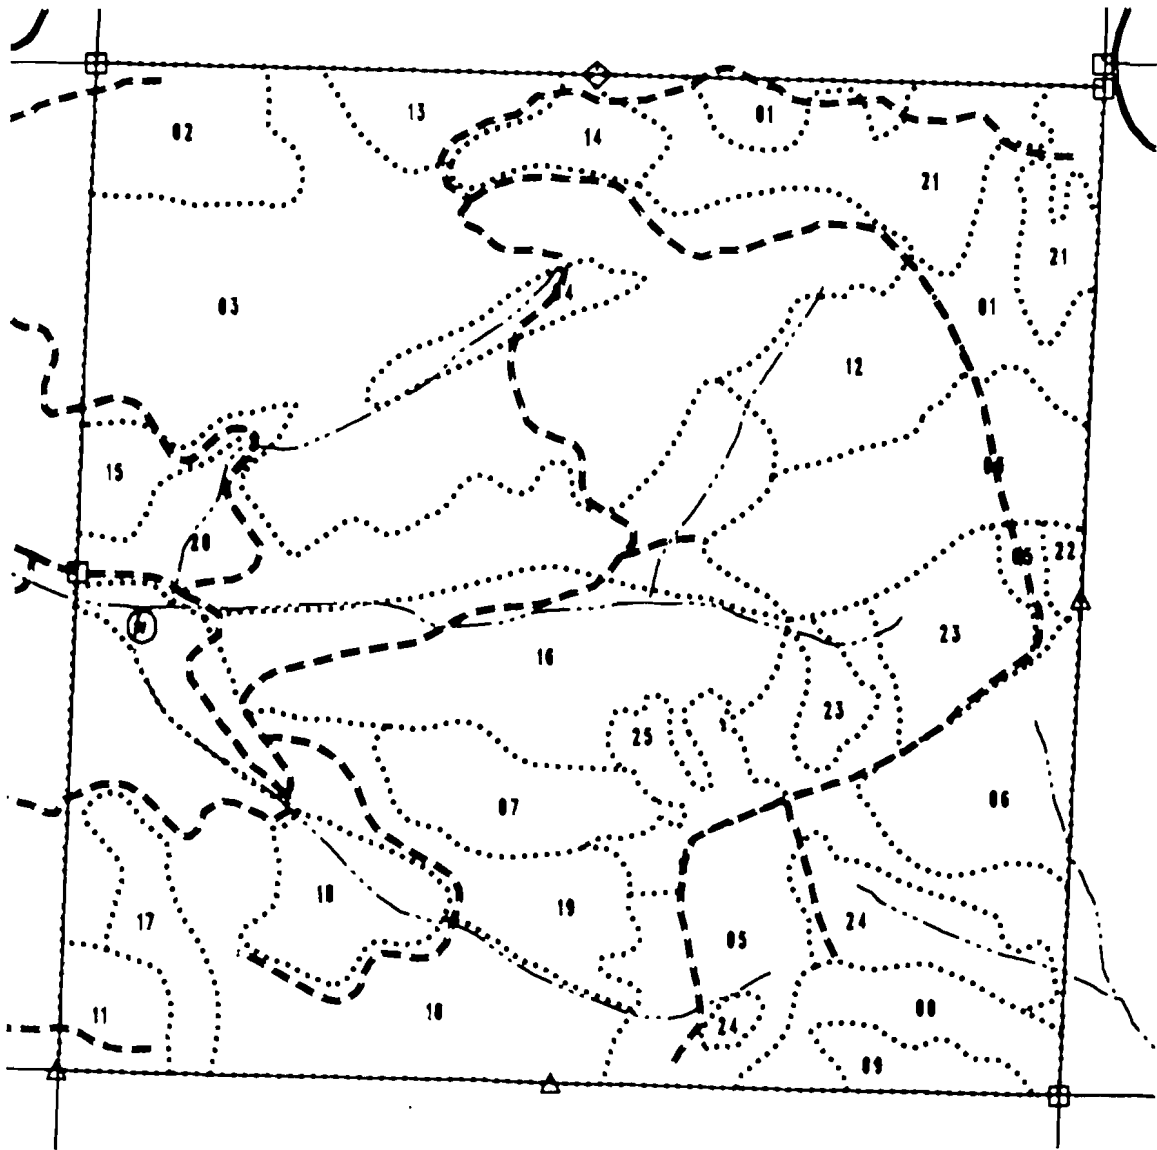

A2

County: JACKSON

Approx Map Scale: 1" = 1000'

Revised Date:


CERTIFICATE NO. 69809

Application No R-75800  
Parcel No.

#3

North Palmer

Fireblock: APPLGATE Photo: 42-3 Township: 39S04W Section: 36

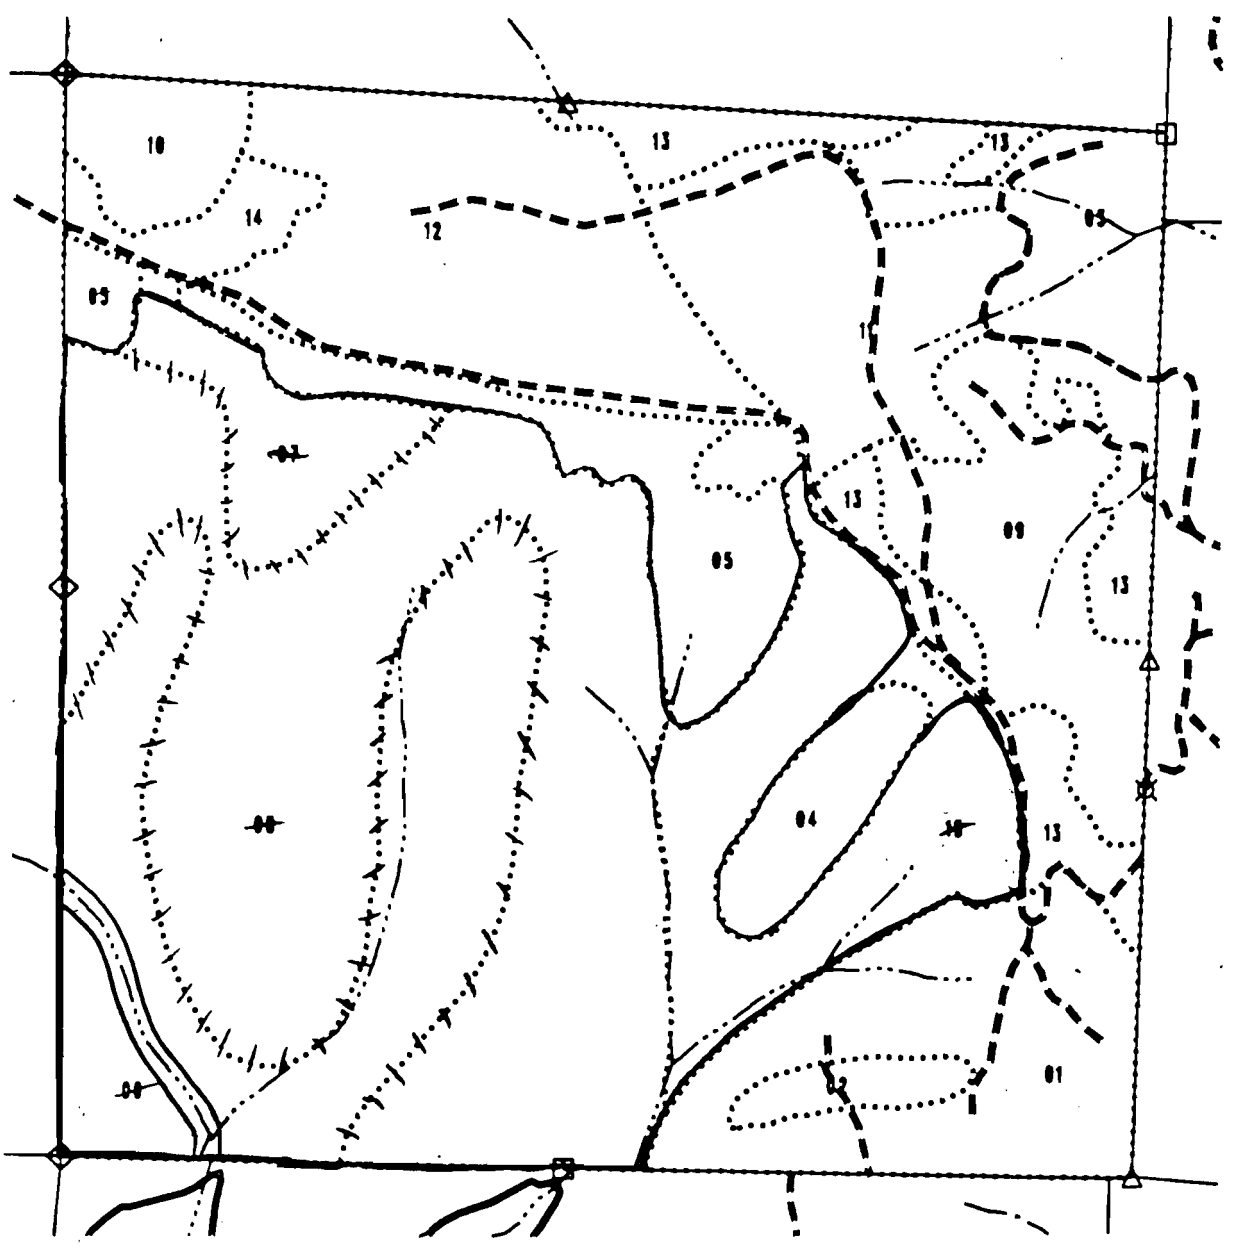

County: JACKSON Approx Map Scale: 1" = 1000' Revised Date:

69809

CERTIFICATE NO. \_\_\_\_\_


Application No R-75802  
Parcel No. #7

# BOISE CASCADE CORPORATION

Fireblock: TIMBER MOUNTAIN

Photo: \_\_\_\_\_

Township: 37S03W Section: 29

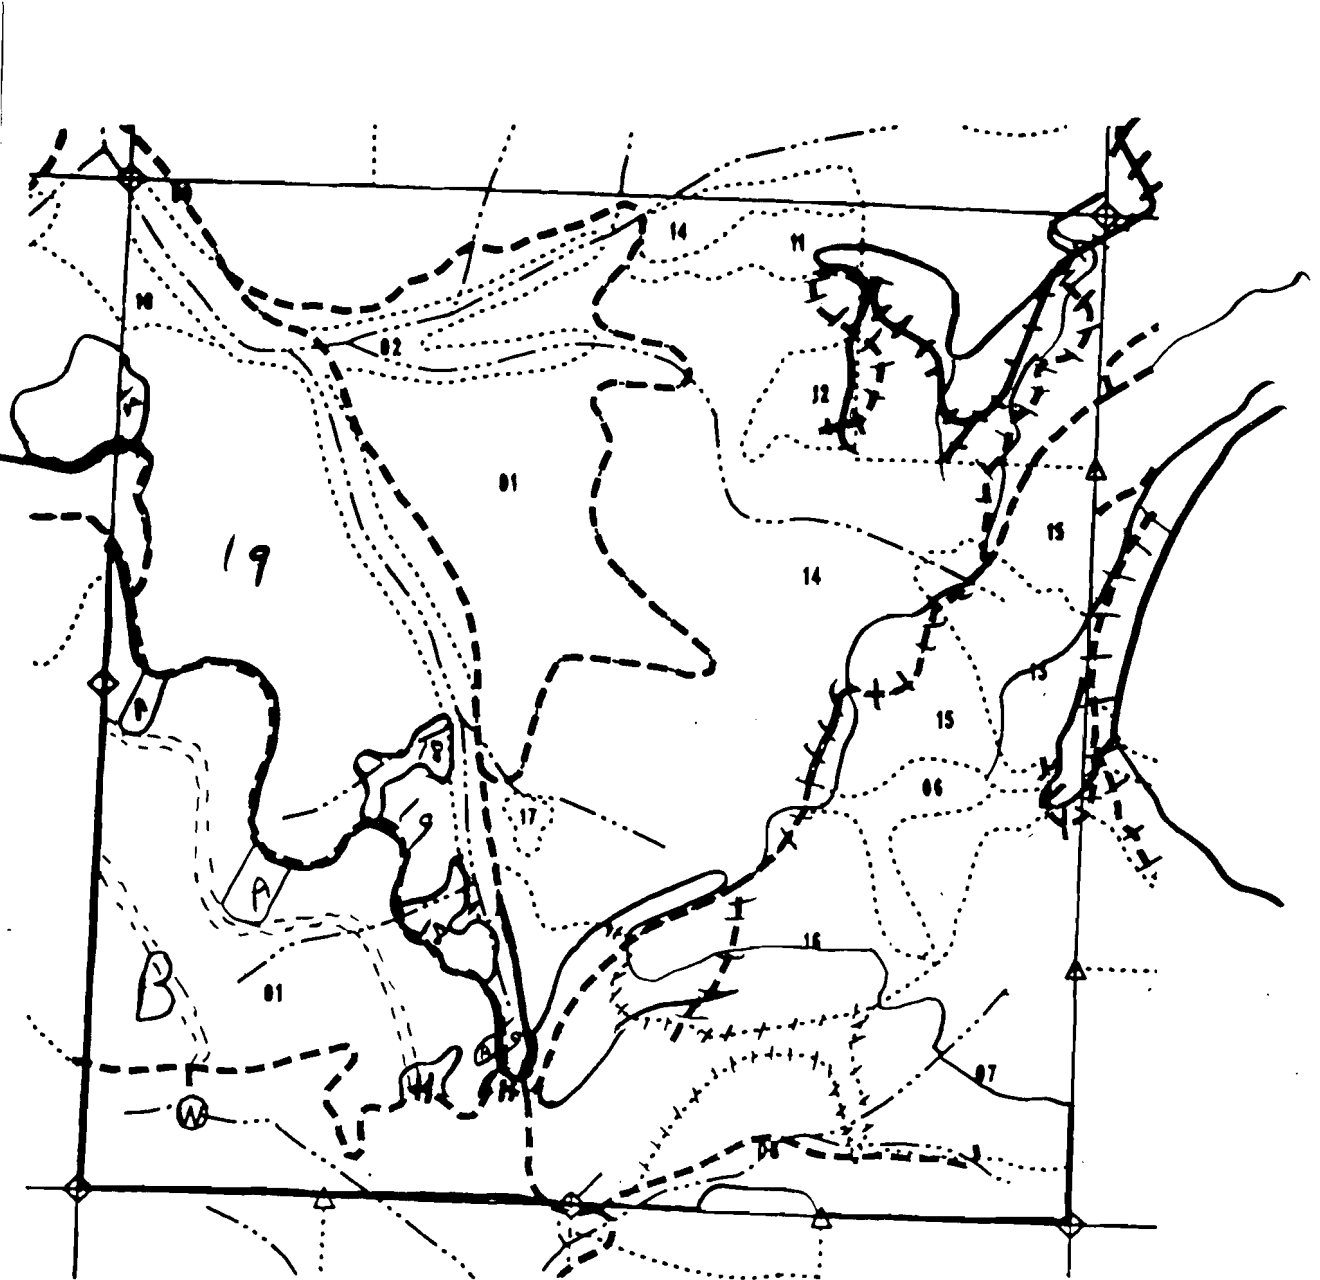

County: JACKSON

Approx Map Scale: 1" = 1000'

Revised Date: \_\_\_\_\_

UP  
15-93

10'  
10'  
10'  
EARS

2.5  
0.9  
8.2  
4.6  
1.2  
8.9