

T-25-S E-34-E

DEC 22 1994

RECEIVED

WATER METER

SYSTEM

DRAGON

Creek

Alder

Alder Creek Res.

Coral

Mapped, edited, and published by the Geological Survey
Control by USGS and NOS/NOAA
Topography by photogrammetric methods from aerial

★
GN | MN
1

Tin Can Ridge Quad
1972 Edition

T-24-S R-34-E

RECEIVED

DEC 22 1994


WATER RESOURCES DEPT.
SALEM, OREGON

69817

Application No. R-75809
Permit No.

CERTIFICATE NO.

Crane Quad
1990 Edition

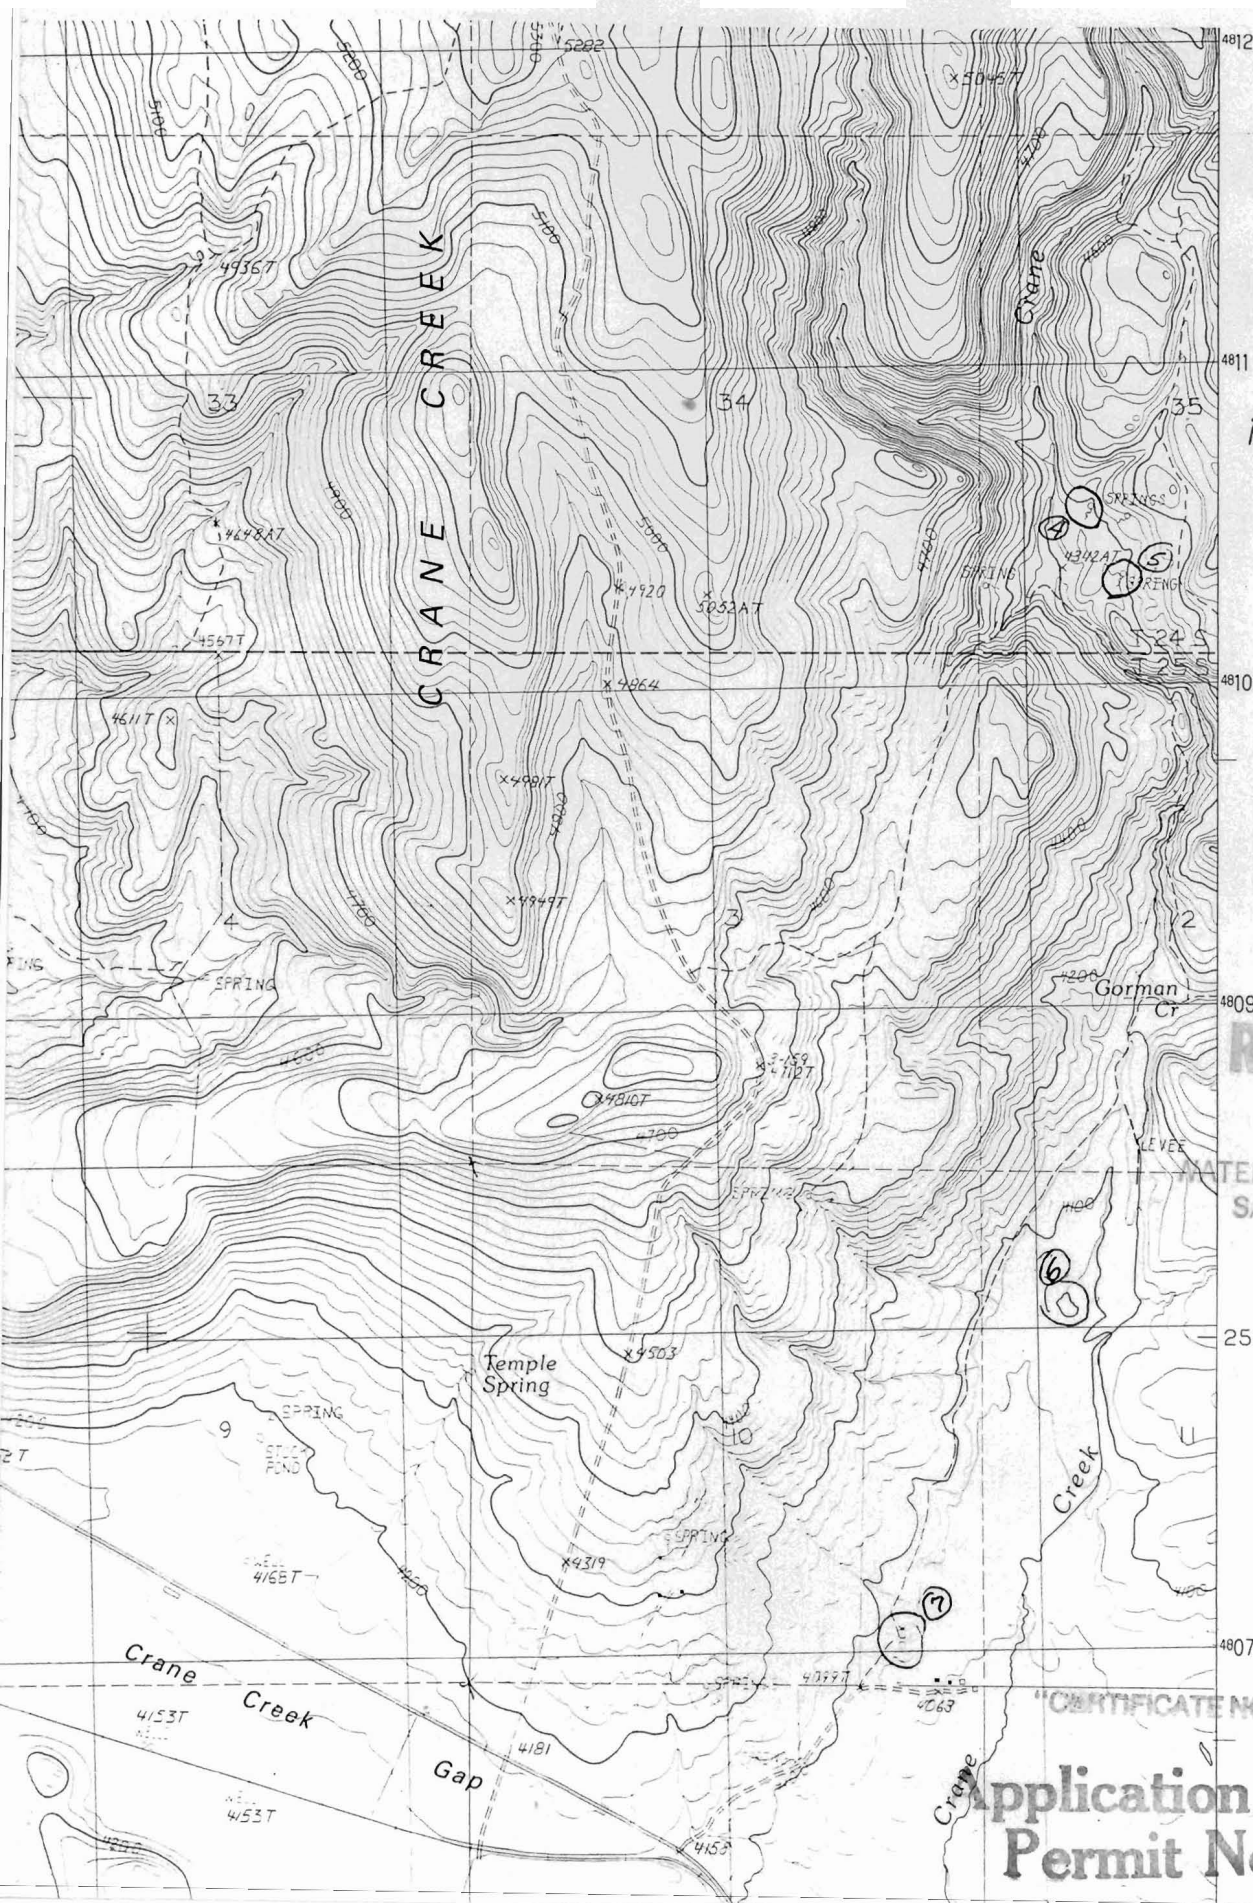

R-34-E

RECEIVED

DEC 22 1994

TER RESOURCES DEPT.
SALEM, OREGON

69817

"CERTIFICATE NO

Application No. K-75809
Permit No.