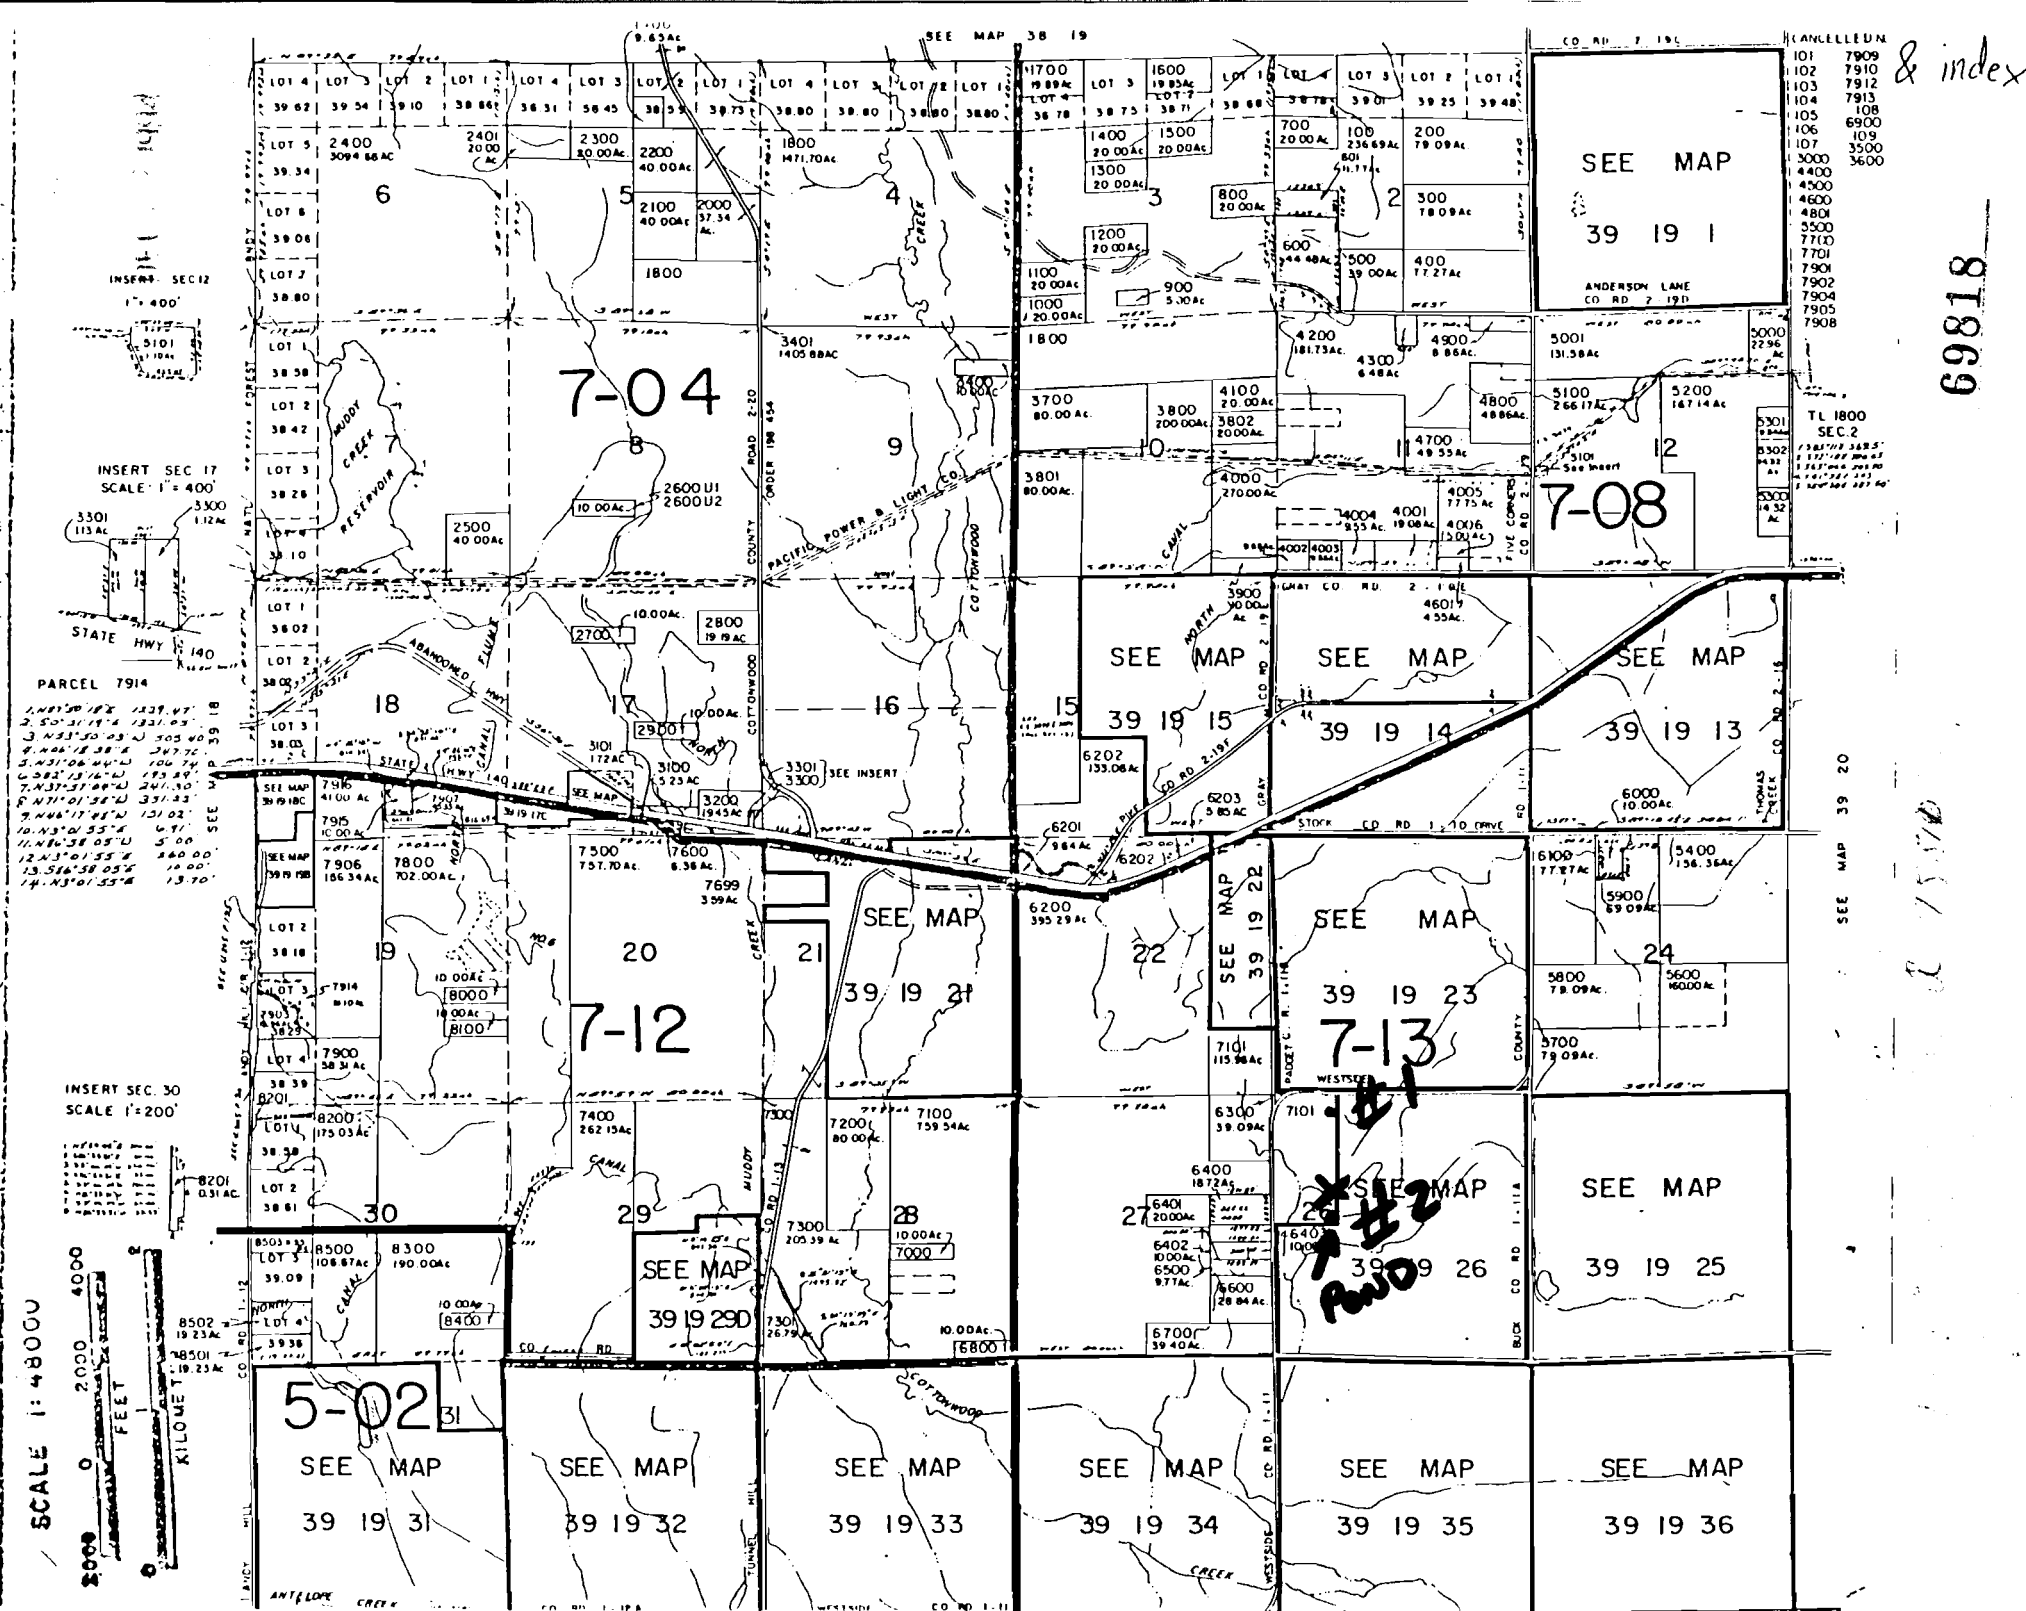
& index
69818
SEE MAP 38 19
SEE MAP 39 19 1
ANDERSON LANE
CO RD 2 19D
CANCELLED N.
101 7909
102 7910
103 7912
104 7913
105 108
106 6900
107 109
3000 3500
4400 3600
4500
4600
4801
5500
7700
7701
7901
7902
7904
7905
7908
TL 1800 SEC. 2
7-04
7-08
7-12
7-13
5-02
INSERT SEC 12
SCALE 1" = 400'
INSERT SEC 17
SCALE 1" = 400'
INSERT SEC. 30
SCALE 1" = 200'
PARCEL 7914
STATE HWY 140
MUDDY CREEK RESERVOIR
ABANDONED FLUME
PACIFIC POWER & LIGHT CO.
COTTONWOOD
CANAL
MUDDY CREEK
ANTELOPE CREEK
TUNNEL HILL
WESTSIDE
SEE MAP 39 19 15
SEE MAP 39 19 14
SEE MAP 39 19 13
SEE MAP 39 19 21
SEE MAP 39 19 22
SEE MAP 39 19 23
SEE MAP 39 19 25
SEE MAP 39 19 26
SEE MAP 39 19 29D
SEE MAP 39 19 31
SEE MAP 39 19 32
SEE MAP 39 19 33
SEE MAP 39 19 34
SEE MAP 39 19 35
SEE MAP 39 19 36
SEE MAP 39 19 18C
SEE MAP 39 19 18B
SEE MAP 39 19 17C
SEE INSERT
#1
#2
POND
FEET
KILOMETER