


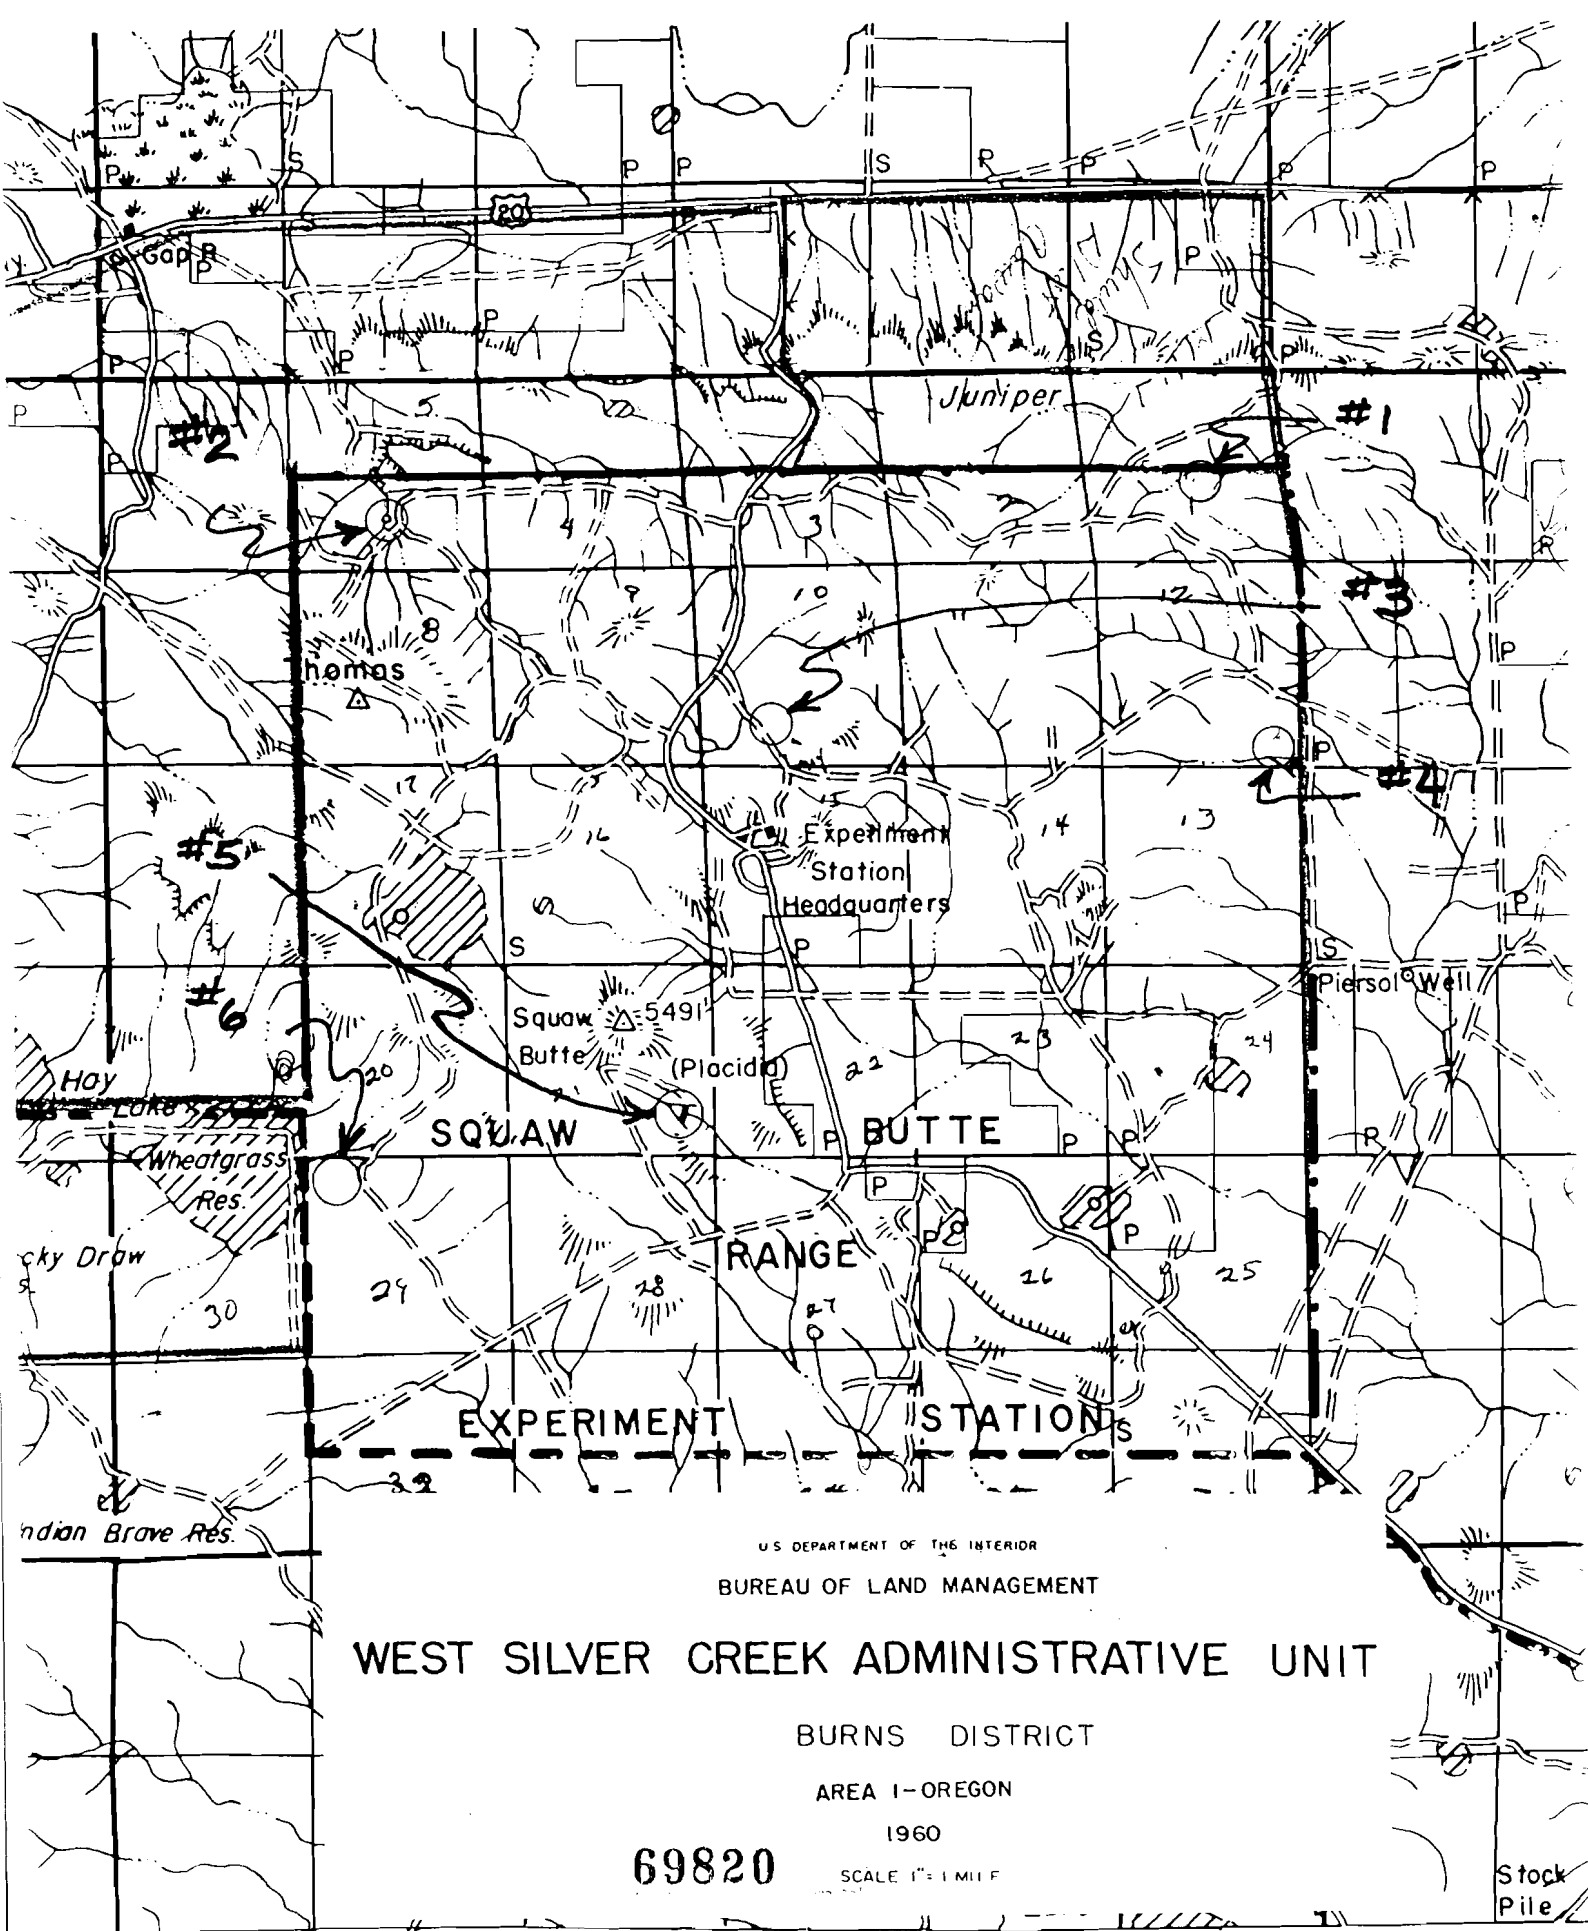

WEST SILVER CREEK ADMINISTRATIVE UNIT

BURNS DISTRICT

AREA 1-OREGON

1960

69820

SCALE 1" = 1 MILE

T24S R. 25 E.

Status all "V" Except as Noted

Stock
Pile