

R 45E  
R 46E



1"=2000'  
IN T 2S, R 45E  
& T 2S, R 46E

18

17

POND #1  
150' DIKE  
150' LONG  
9' DEEP  
1.2 AC FT

POND #2  
85' DIKE  
150' LONG  
7' DEEP  
0.5 AC FT

19

20

POND #4  
90' DIKE  
120' LONG  
8' DEEP  
0.5 AC FT

POND #3  
115' DIKE  
150' LONG  
6' DEEP  
0.6 AC FT

POND LOCATIONS - TO  
E OF DIKE


- #1 3550'S, 50'E NW COR SEC 19
  - #2 3720'S, 1300'E NW COR SEC 19
  - #3 3850'S 1800'E NW COR SEC 19
  - #4 3200'S 1100'E NW COR SEC 20
- BASED ON ASCS AERIAL PHOTO

FREUDENBURG  
LAKE

30

WALLOWA VALLEY  
IMPROVEMENT  
DIST. DITCH

69823

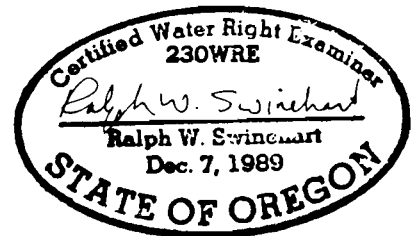

IN WALLOWA COUNTY

SEC 19 & 20 T2S, R46E

EXISTING POND WATER RIGHT APPLICATION MAP

FOR: KARL PATTON