


R25E

2069 III SE (FLAGSTAFF LAKE)

REFUGE HDQRS. 13 MI. 47'30"

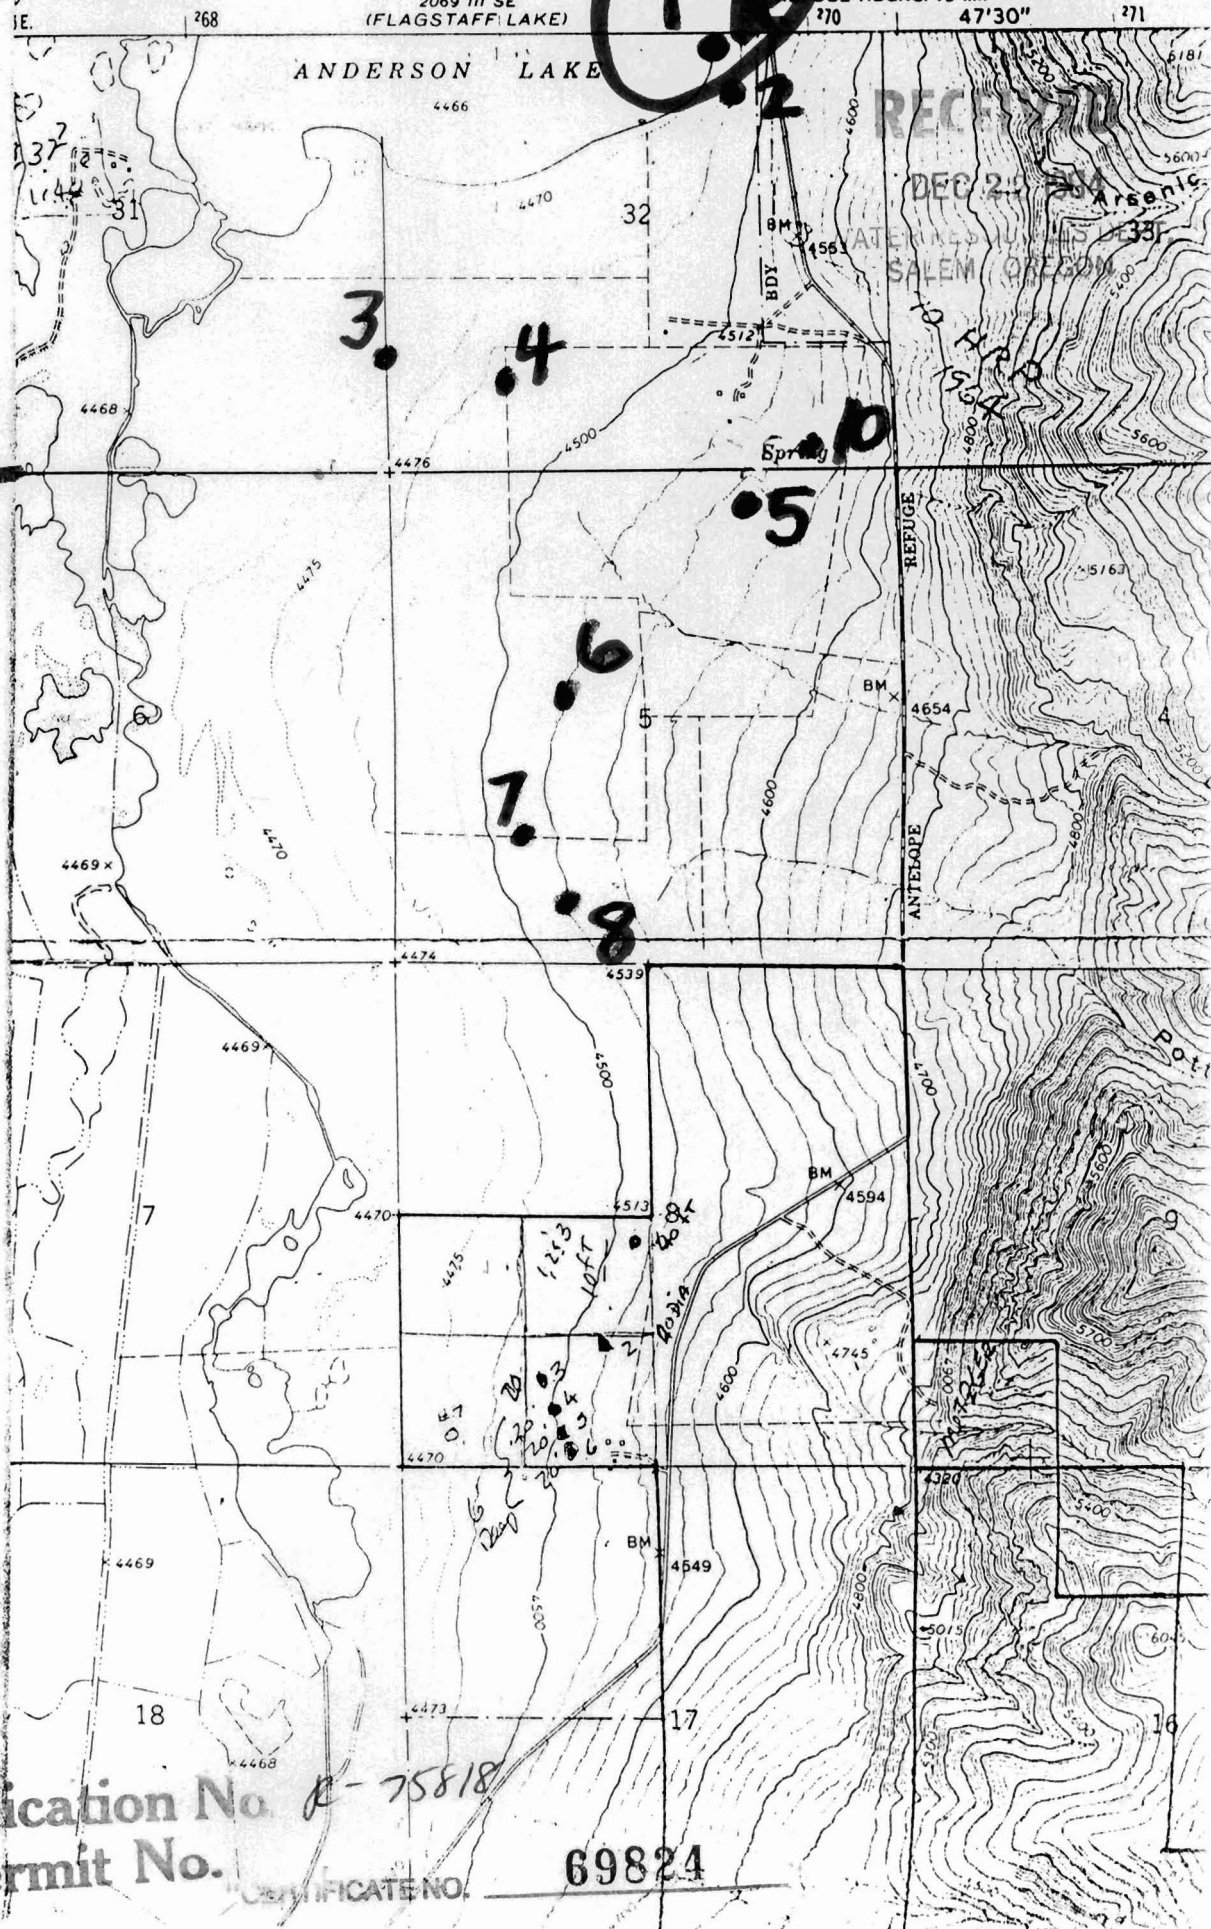

T35S

T36S

Application No. R-75818

Permit No.

69824

CERTIFICATE NO.