

RECEIVED


DEC 2 2 1994

Application No. R-75825

Permit No.

69828

"CERTIFICATE NO.

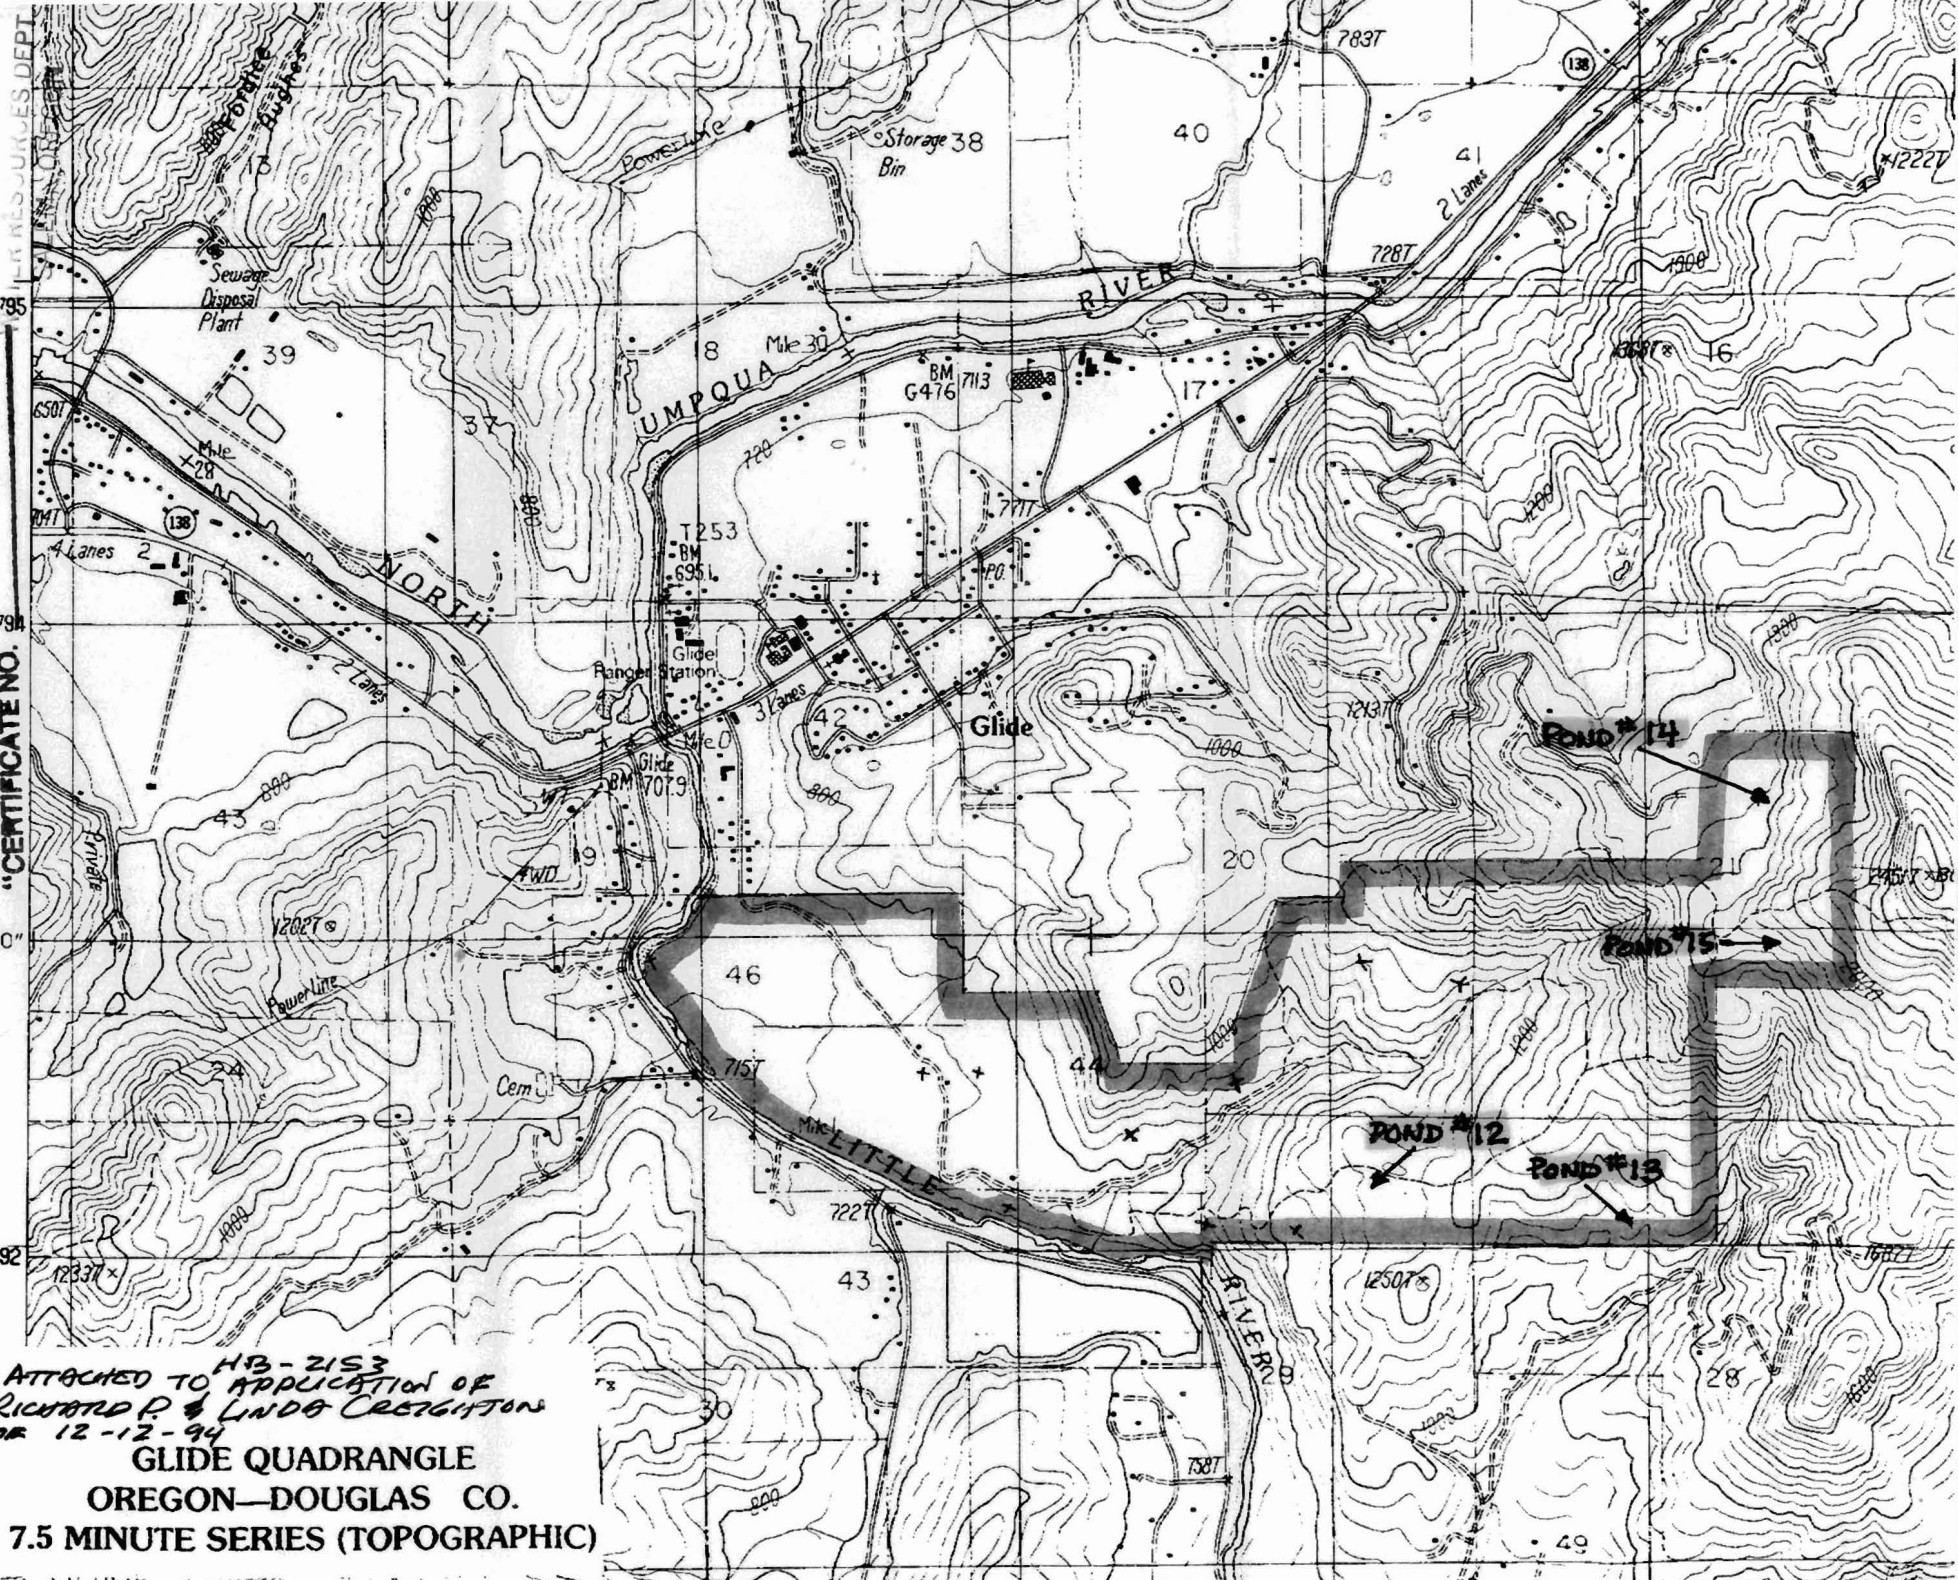

ATTACHED TO HB-2153
 APPLICATION OF
 RICHARD P. & LINDA CROUGHTON
 OR 12-12-94
 GLIDE QUADRANGLE
 OREGON—DOUGLAS CO.
 7.5 MINUTE SERIES (TOPOGRAPHIC)