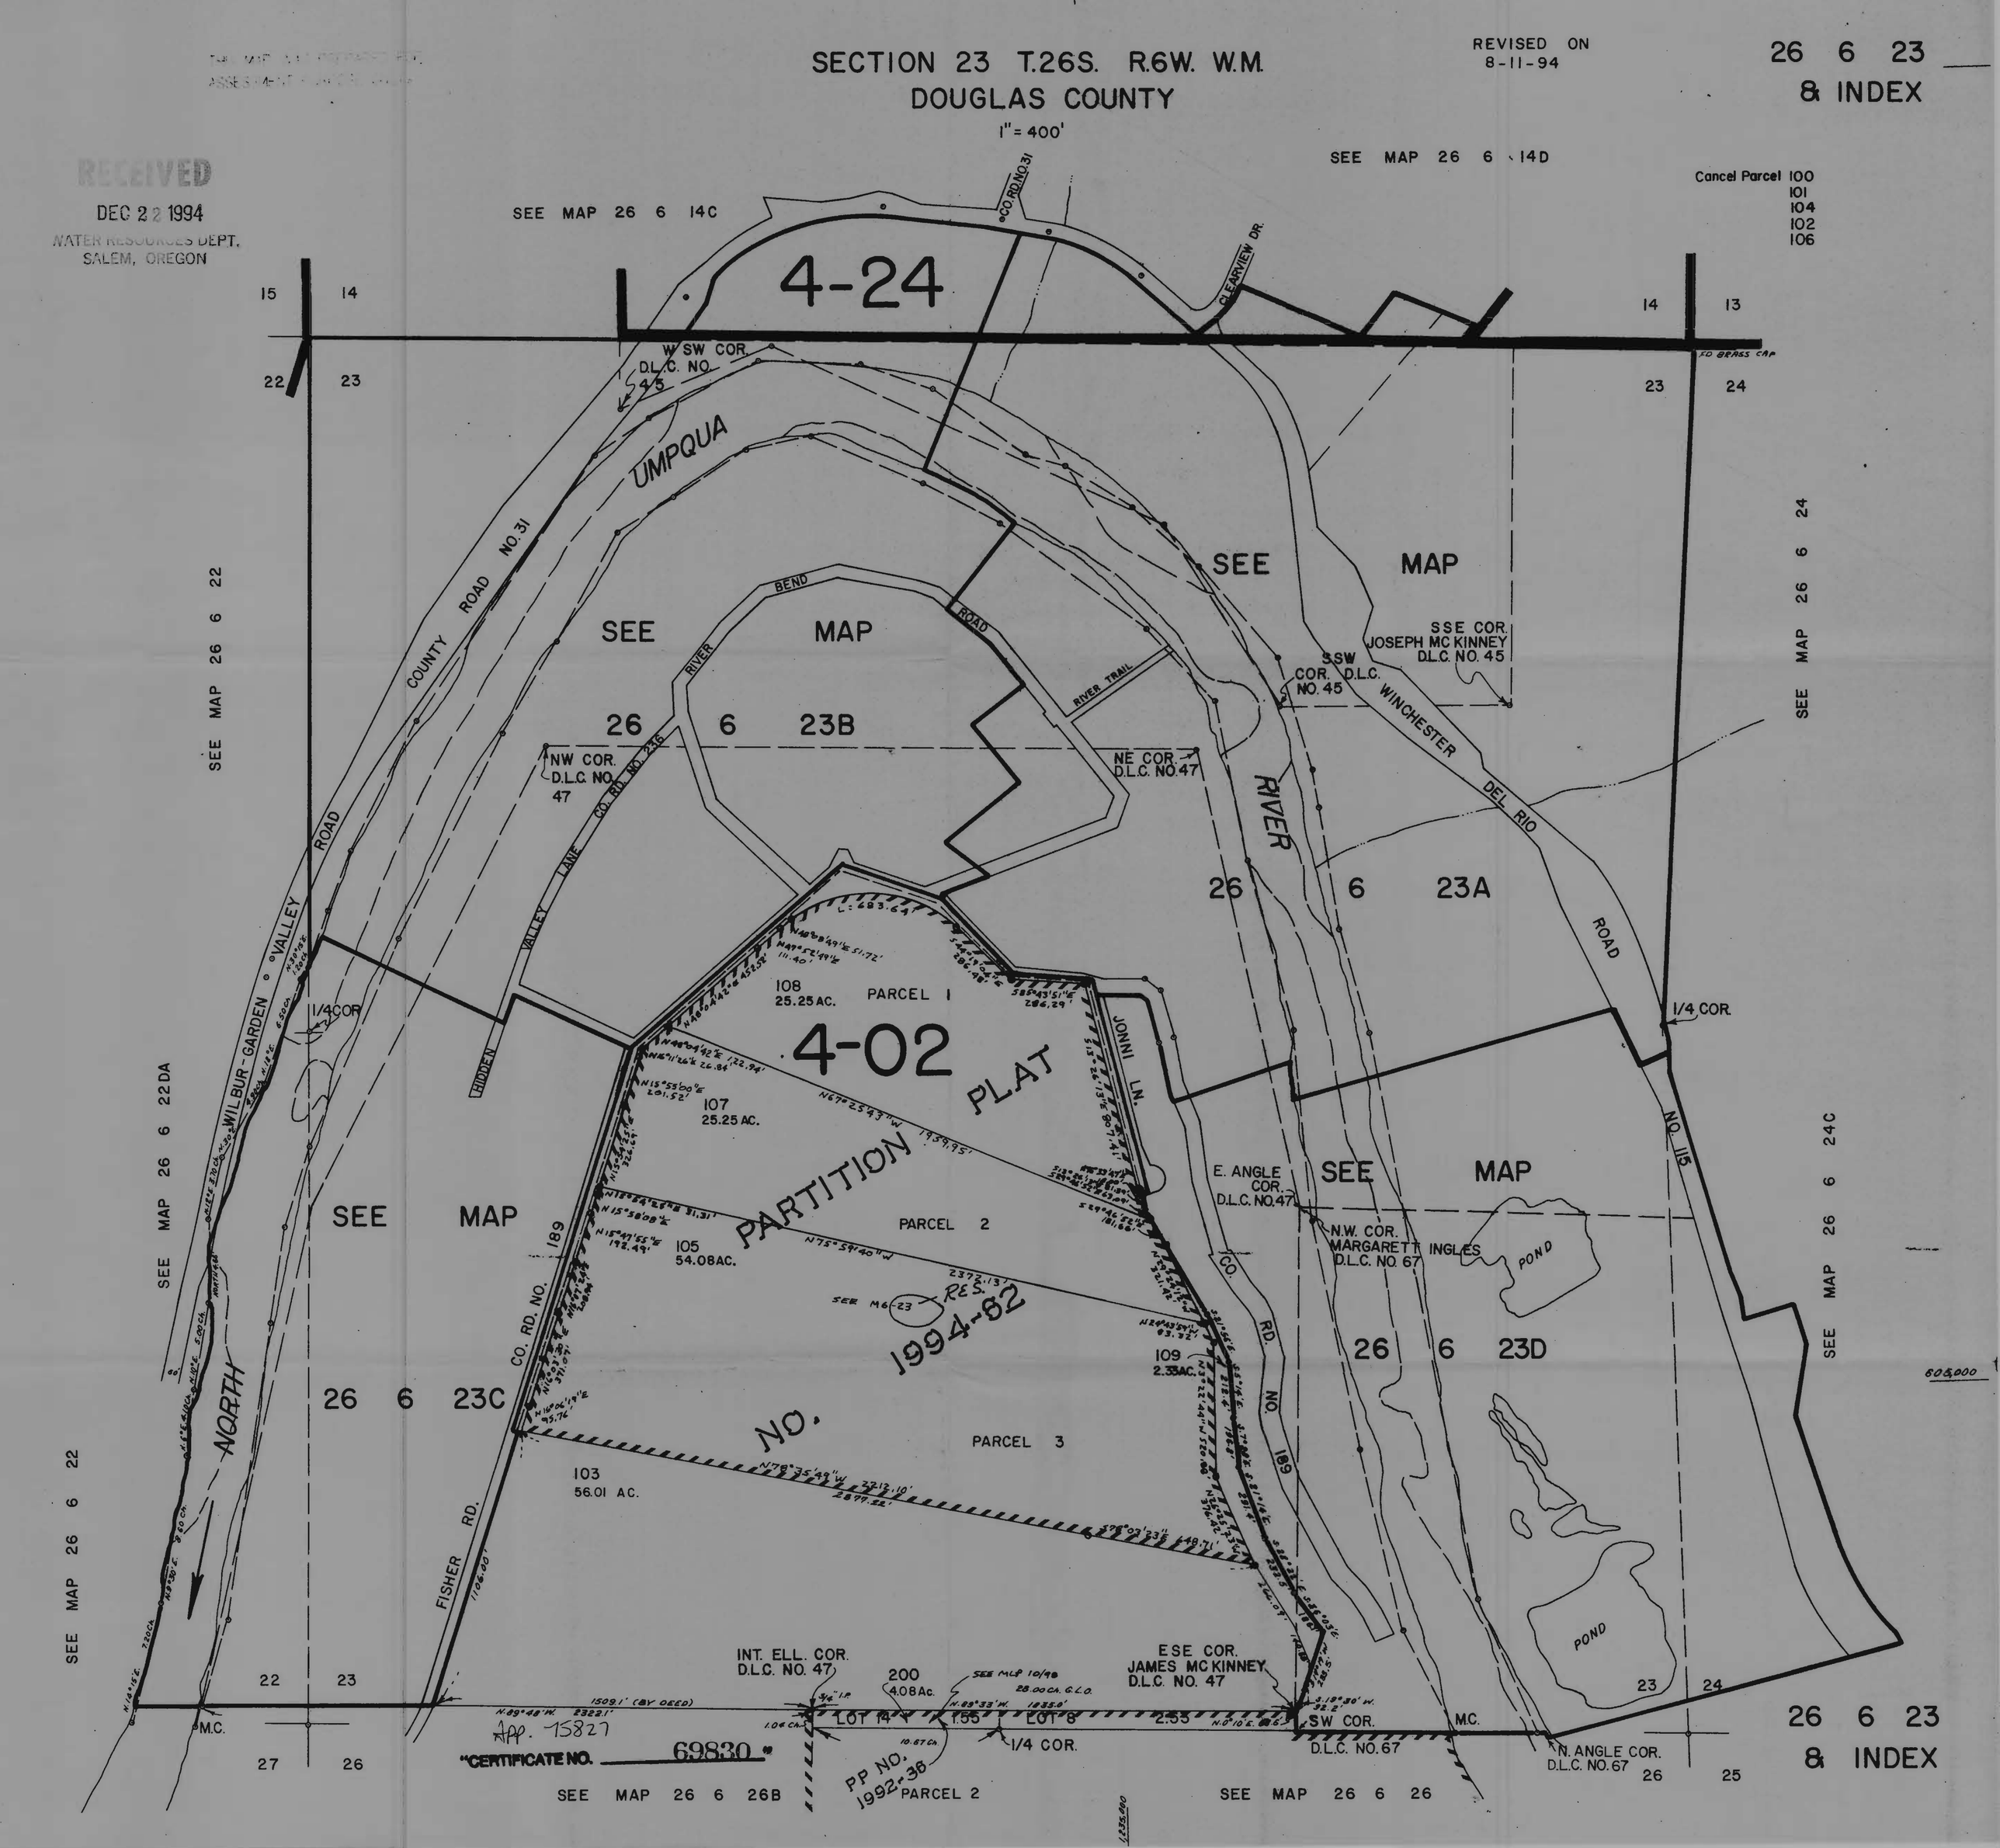
SECTION 23 T.26S. R.6W. W.M.
DOUGLAS COUNTY
1" = 400'
REVISED ON 8-11-94
26 6 23
& INDEX
RECEIVED
DEC 22 1994
WATER RESOURCES DEPT.
SALEM, OREGON
SEE MAP 26 6 14C
SEE MAP 26 6 14D
Cancel Parcel 100
101
104
102
106
4-24
CO. RD. NO. 31
CLEARVIEW DR.
W SW COR. D.L.C. NO. 45
UMPQUA
COUNTY ROAD NO. 31
SEE MAP 26 6 22
SEE MAP 26 6 24
SEE MAP 26 6 23B
SEE MAP 26 6 23A
SEE MAP 26 6 23C
SEE MAP 26 6 23D
SEE MAP 26 6 22DA
SEE MAP 26 6 24C
SEE MAP 26 6 26B
SEE MAP 26 6 26
SSE COR. JOSEPH MC KINNEY D.L.C. NO. 45
SSW COR. D.L.C. NO. 45
WINCHESTER DEL RIO ROAD
RIVER BEND ROAD
RIVER TRAIL
NW COR. D.L.C. NO. 47
NE COR. D.L.C. NO. 47
RIVER
VALLEY LANE
CO. RD. NO. 236
HIDDEN
WILBUR-GARDEN VALLEY ROAD
1/4 COR.
PARCEL 1
108
25.25 AC.
4-02
PARTITION PLAT
107
25.25 AC.
JONNI LN.
E. ANGLE COR. D.L.C. NO. 47
N.W. COR. MARGARETT INGLES D.L.C. NO. 67
POND
PARCEL 2
105
54.08 AC.
SEE M6-23
RES.
1994-82
NO.
109
2.33 AC.
CO. RD. NO. 189
NORTH
PARCEL 3
103
56.01 AC.
FISHER RD.
INT. ELL. COR. D.L.C. NO. 47
200
4.08 Ac.
ESE COR. JAMES MC KINNEY D.L.C. NO. 47
SW COR. D.L.C. NO. 67
M.C.
N. ANGLE COR. D.L.C. NO. 67
LOT 14
LOT 8
1/4 COR.
PP NO. 1992-36
PARCEL 2
"CERTIFICATE NO. 69830"
App. 75827
26 6 23
& INDEX