

22T 3S R 40 E W.M.

3S 40 22

IN COUNTY

COVE & INDEX

1400'

inside proposal area

Application No. R-75835
Permit No.

AP 3 40 15

Lee + Thelma

Huggins, John + Betty


DEC 27 1994

WATER RIGHTS DEPT.
SALEM, OREGON

Musick, Richard

15

14

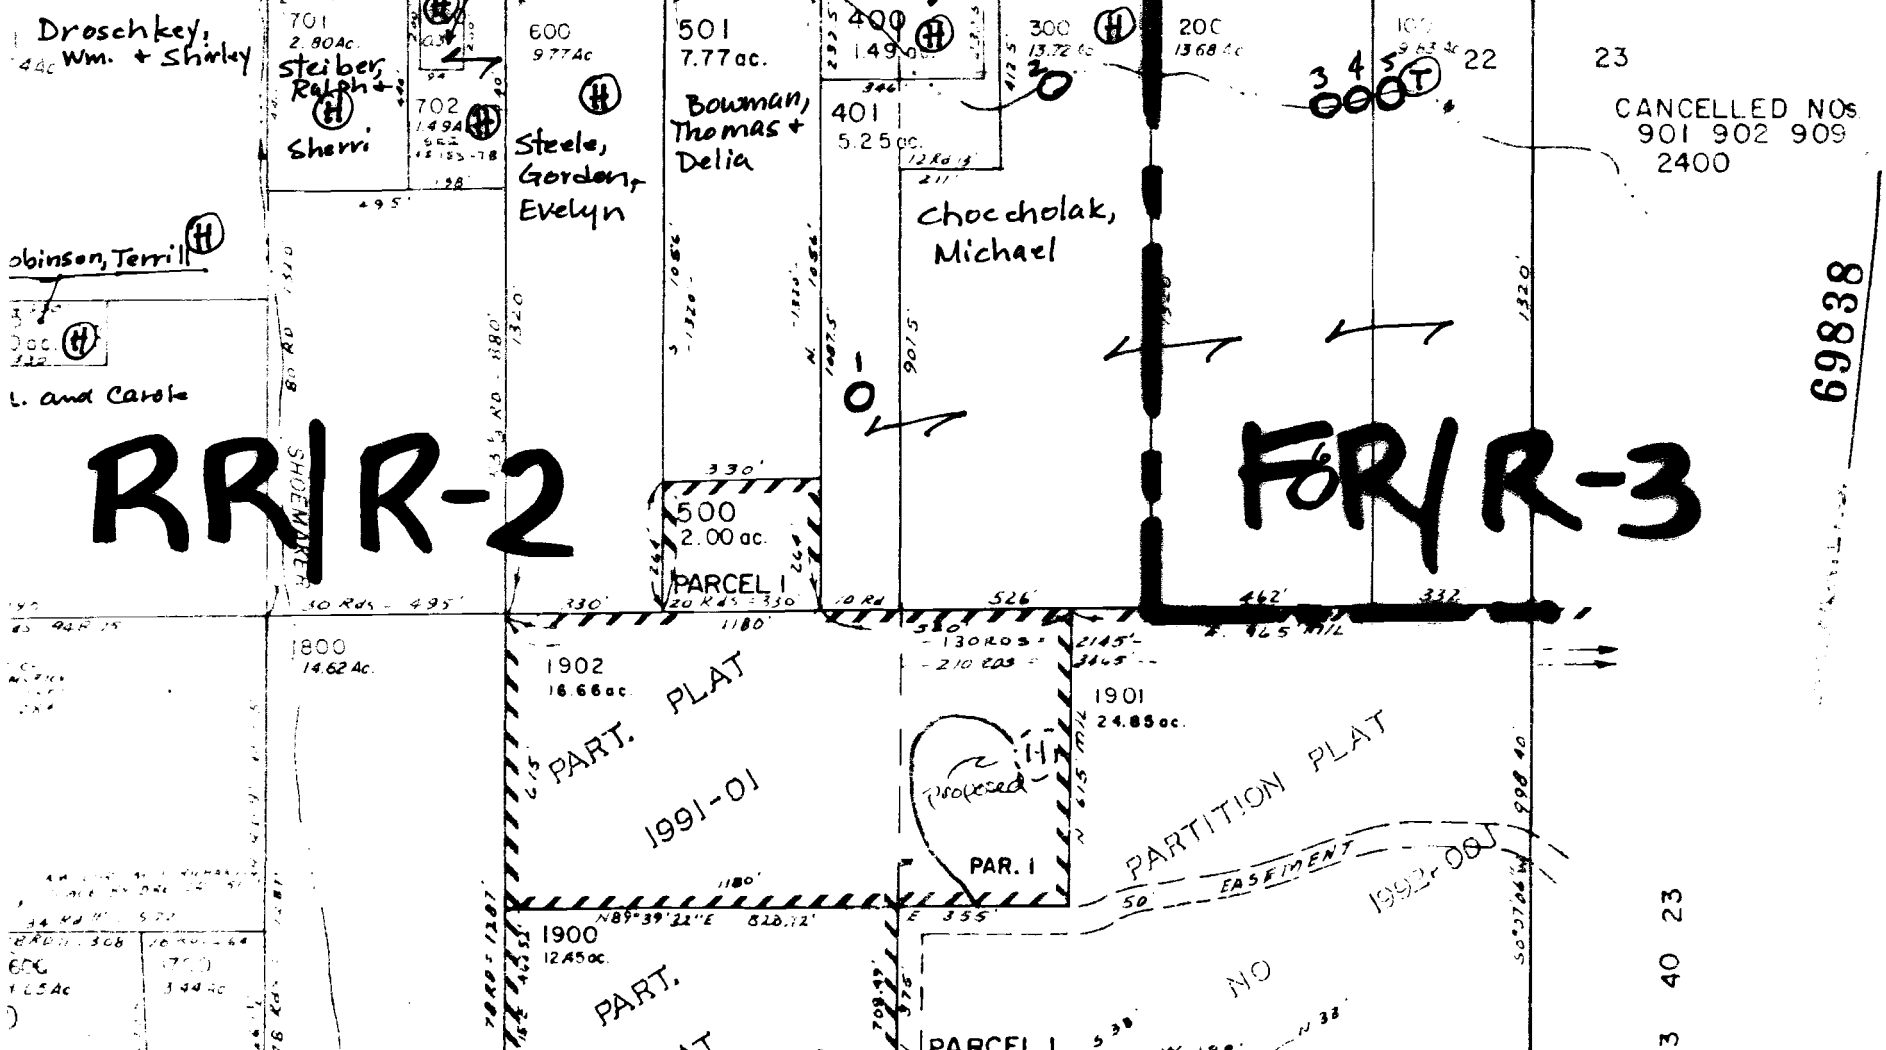

CANCELLED NOS
901 902 909
2400

69838

3 40 23