


Application No. R-75836
 Permit No.

DEC 22 1994

CERTIFICATE NO. 69833

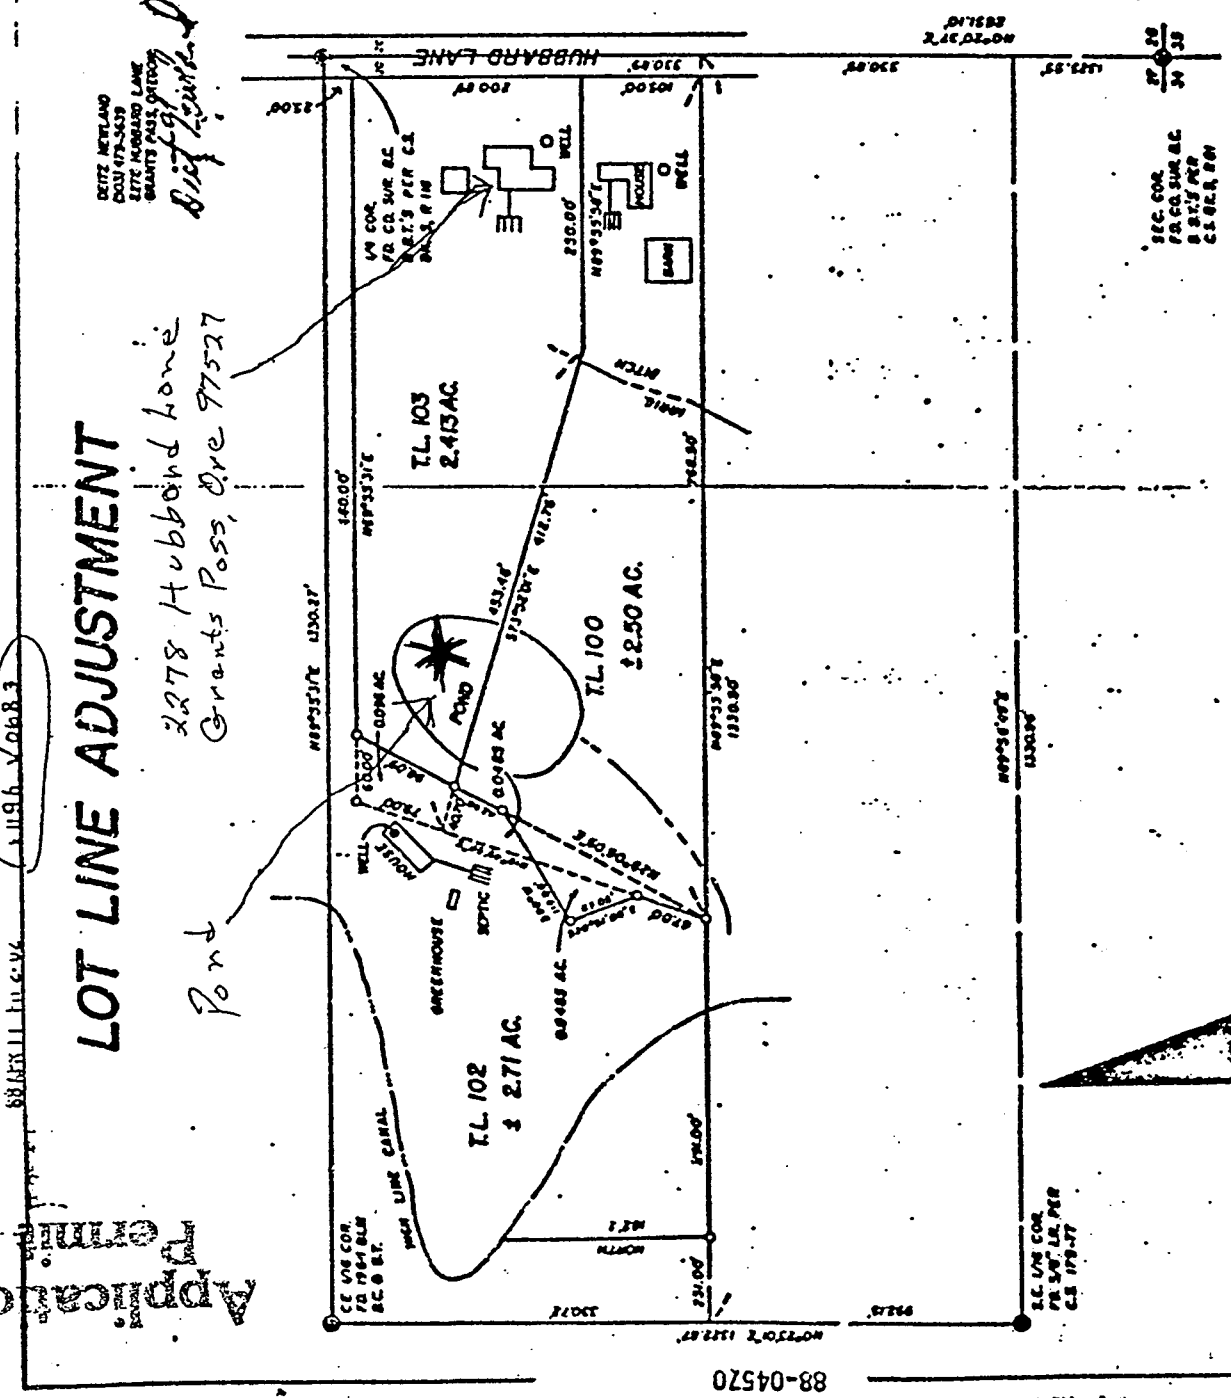

DATE: 2/22/94

OWNER BY AND FOR: WILHELM BOCKLE
 TELEPHONE: (503) 972-2111

MAILING ADDRESS: 2278 HUBBARD LANE
 GRANTS PASS, OREGON


OWNER'S SIGNATURE: *Max H. Hull*

OWNER'S SIGNATURE: *William Bockle*

DATE: 2/22/94

APPROVAL: *Max H. Hull*
 REGISTERED LAND SURVEYOR

FOR PLANNING USE ONLY

FLOOD HAZARD: _____

OTHER: _____

NOTES: _____

REGISTERED LAND SURVEYOR
 MAX H. HULL, SURVEYING
 231 NW "B" STREET
 GRANTS PASS, OREGON 97526

DATE: FEBRUARY 22, 1988
 SCALE: 1"=100'

0 SET 3/4" X 30" 1000 430 WITH PLASTIC
 YELLOW CAP MARKED SHALL BE 901

0 FOUND MONUMENT AS NOTED

BASED ON BEARING & DISTANCE SURVEY
 SURVEY INSTRUMENT BEARING RECORD

REGISTERED PROFESSIONAL LAND SURVEYOR

432153

R75836

APPROVAL NO. 7-7472