


RECEIVED
JAN 21 1934
DEPT. OF REVENUE STATE OF OREGON
ASSESSMENT & APPRAISAL DIV.

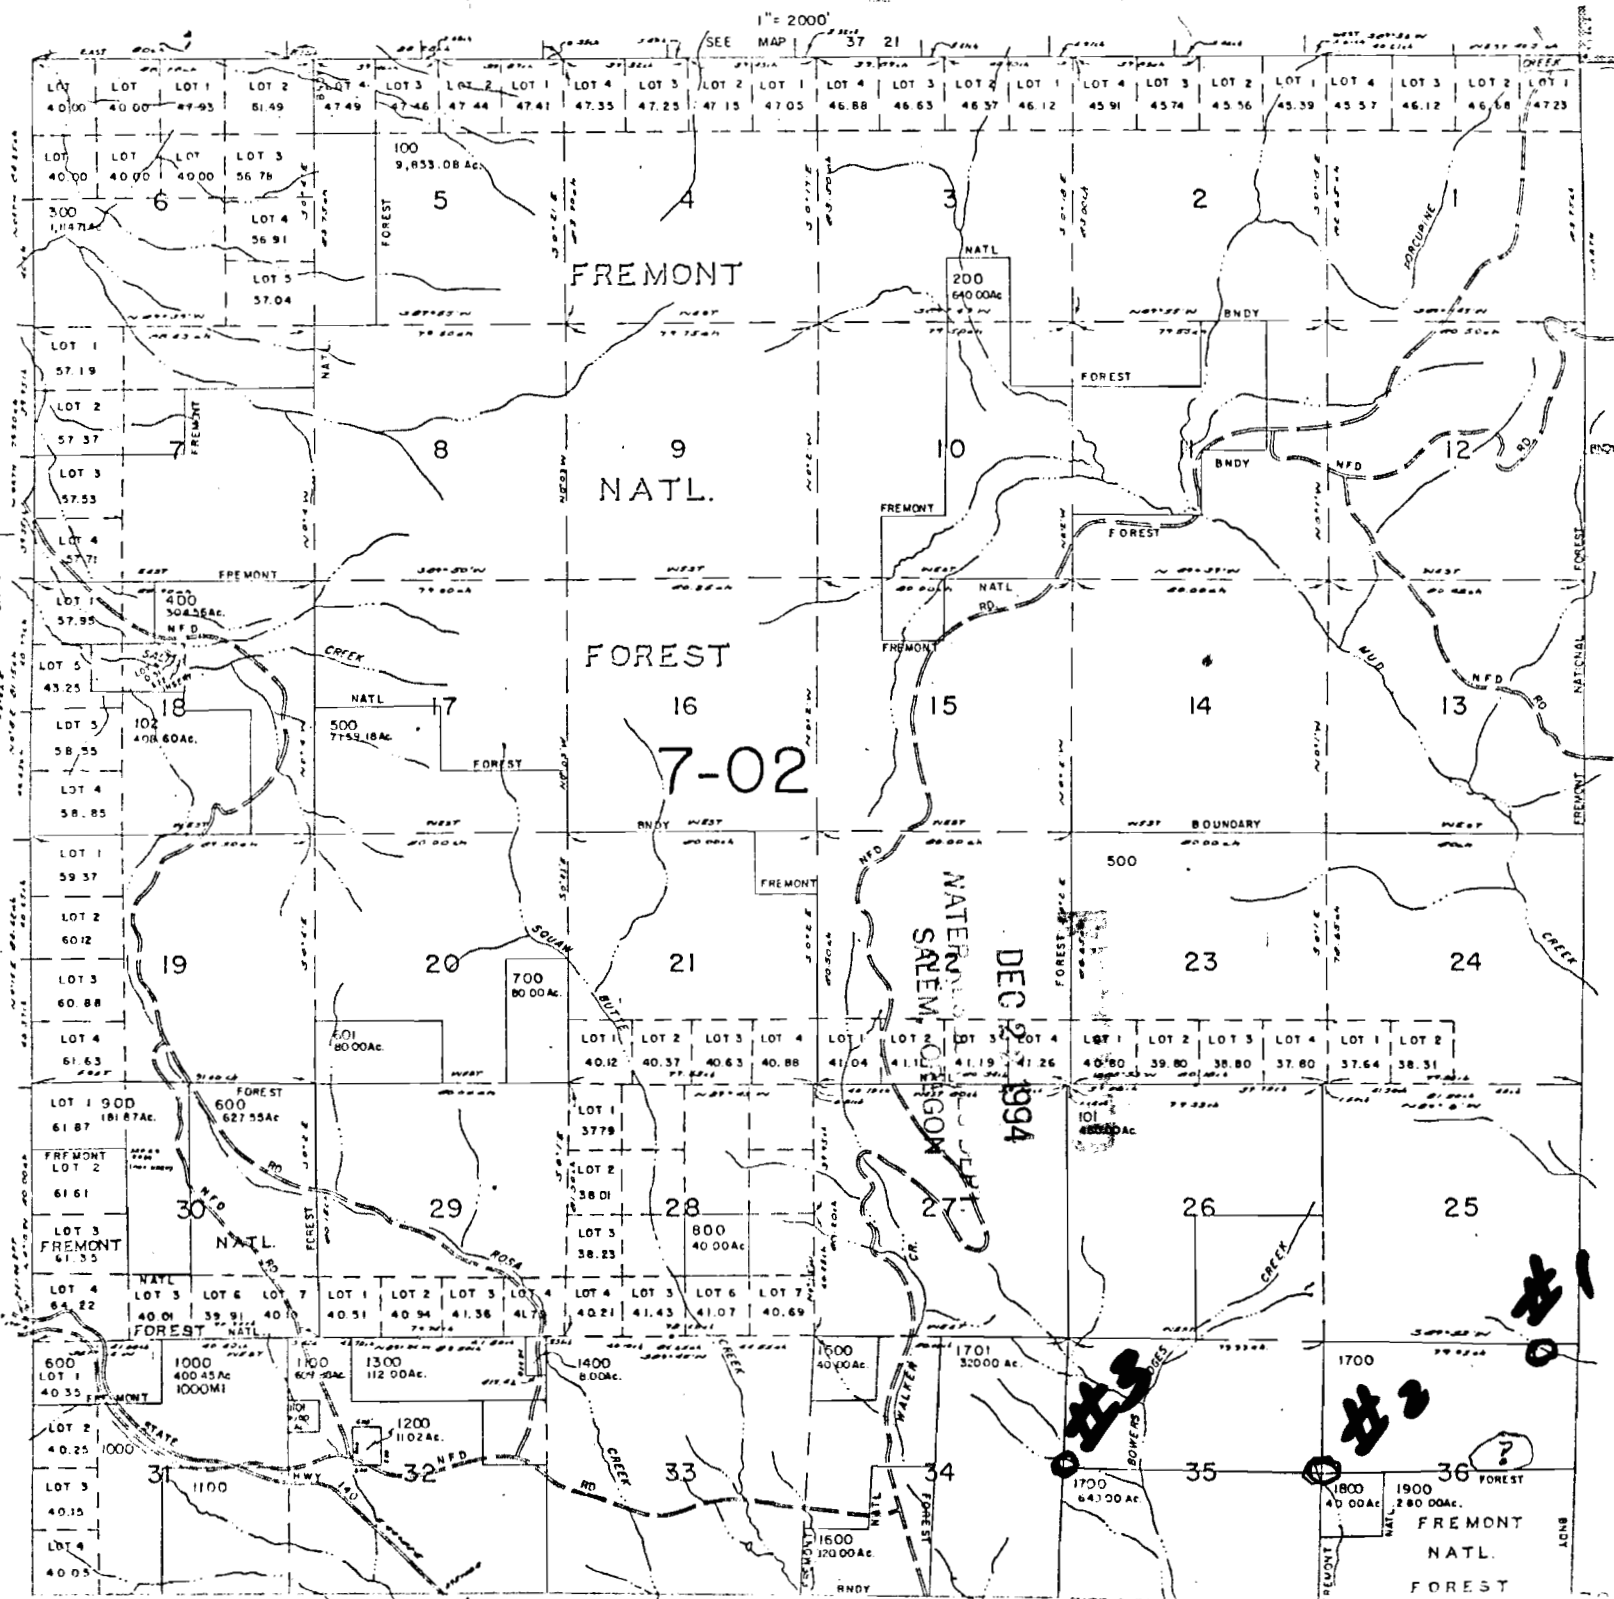

38 21

LAKE

69842

Application No. P-75839
Permit No. _____