
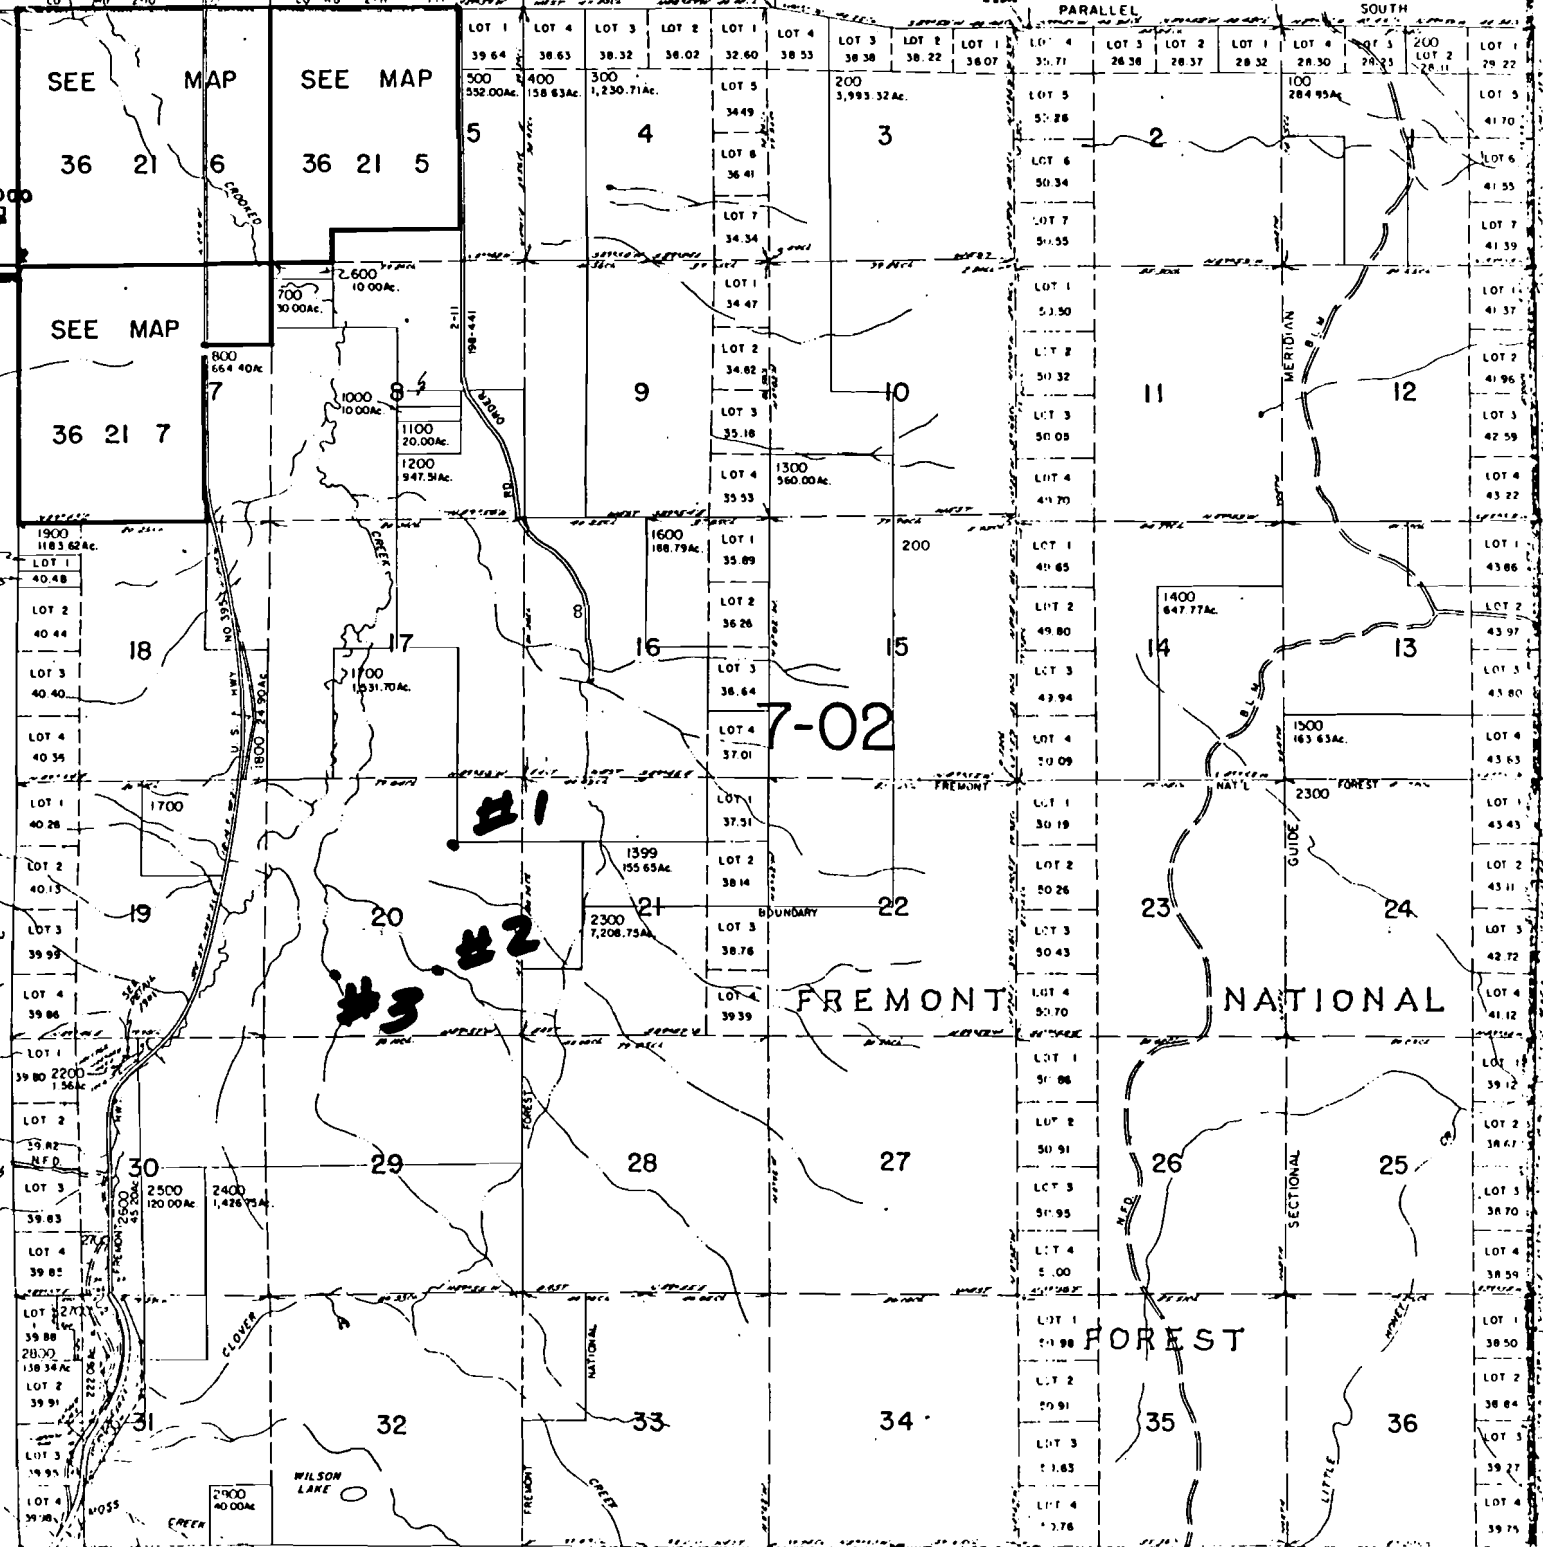


3621

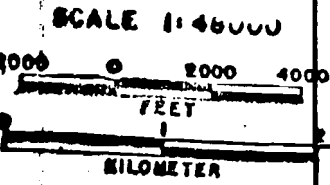

09043

R-75870

Section No. 36 21

SEE MAP 36 22