


T. 4 S., R. 1 W. W.M.

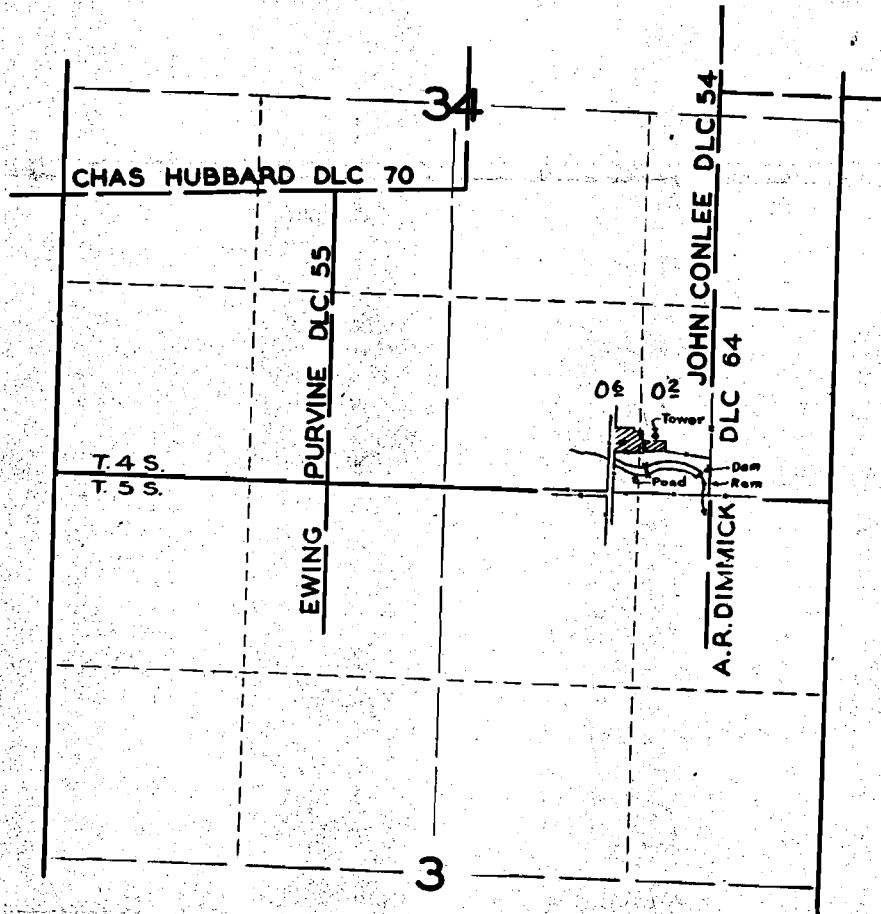

FINAL PROOF SURVEY

UNDER

Application No. 17412 Permit No. 13109

IN NAME OF

L.A. Braden

Surveyed Sept. 22 1943, by *E. J. Anderson*

1943-A

69846

R-75843