


INSERT SEC. 23
1" = 400'

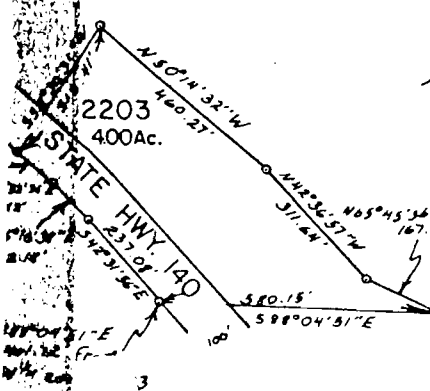


SEC. 28
PARCEL 2602
1. N 89° 25' 40" E 105.74'
2. S 16° 30' 10" W 117.00'
3. N 89° 25' 40" E 65.32'
4. N 17° 59' 25" E 206.69'
5. S 89° 25' 40" W 93.53'
6. N 08° 14' 20" W 350'
7. S 85° 35' 24" W 652.12'
8. S 01° 33' 52" W 380.85'

SEC. 21
PARCEL 2603
1. N 15° 11' 10" E 153.40'
2. N 11° 34' 10" E 200.00'
3. S 75° 26' 10" E 653.40'
4. S 11° 34' 10" W 200.00'
PARCEL 2605
1. N 75° 26' 10" E 653.40'
2. N 11° 34' 10" E 200.00'
3. S 75° 26' 10" E 653.40'
4. S 11° 34' 10" W 200.00'

TL 7100-Details
1. West 240'
2. N 37° 02' W 260'
3. N 67° 37' E 404.4'
4. N 18° 51' E 540'
5. N 89° 40' E 260'
6. S 01° 14' E 143'

10/25/93
6/93
3,400

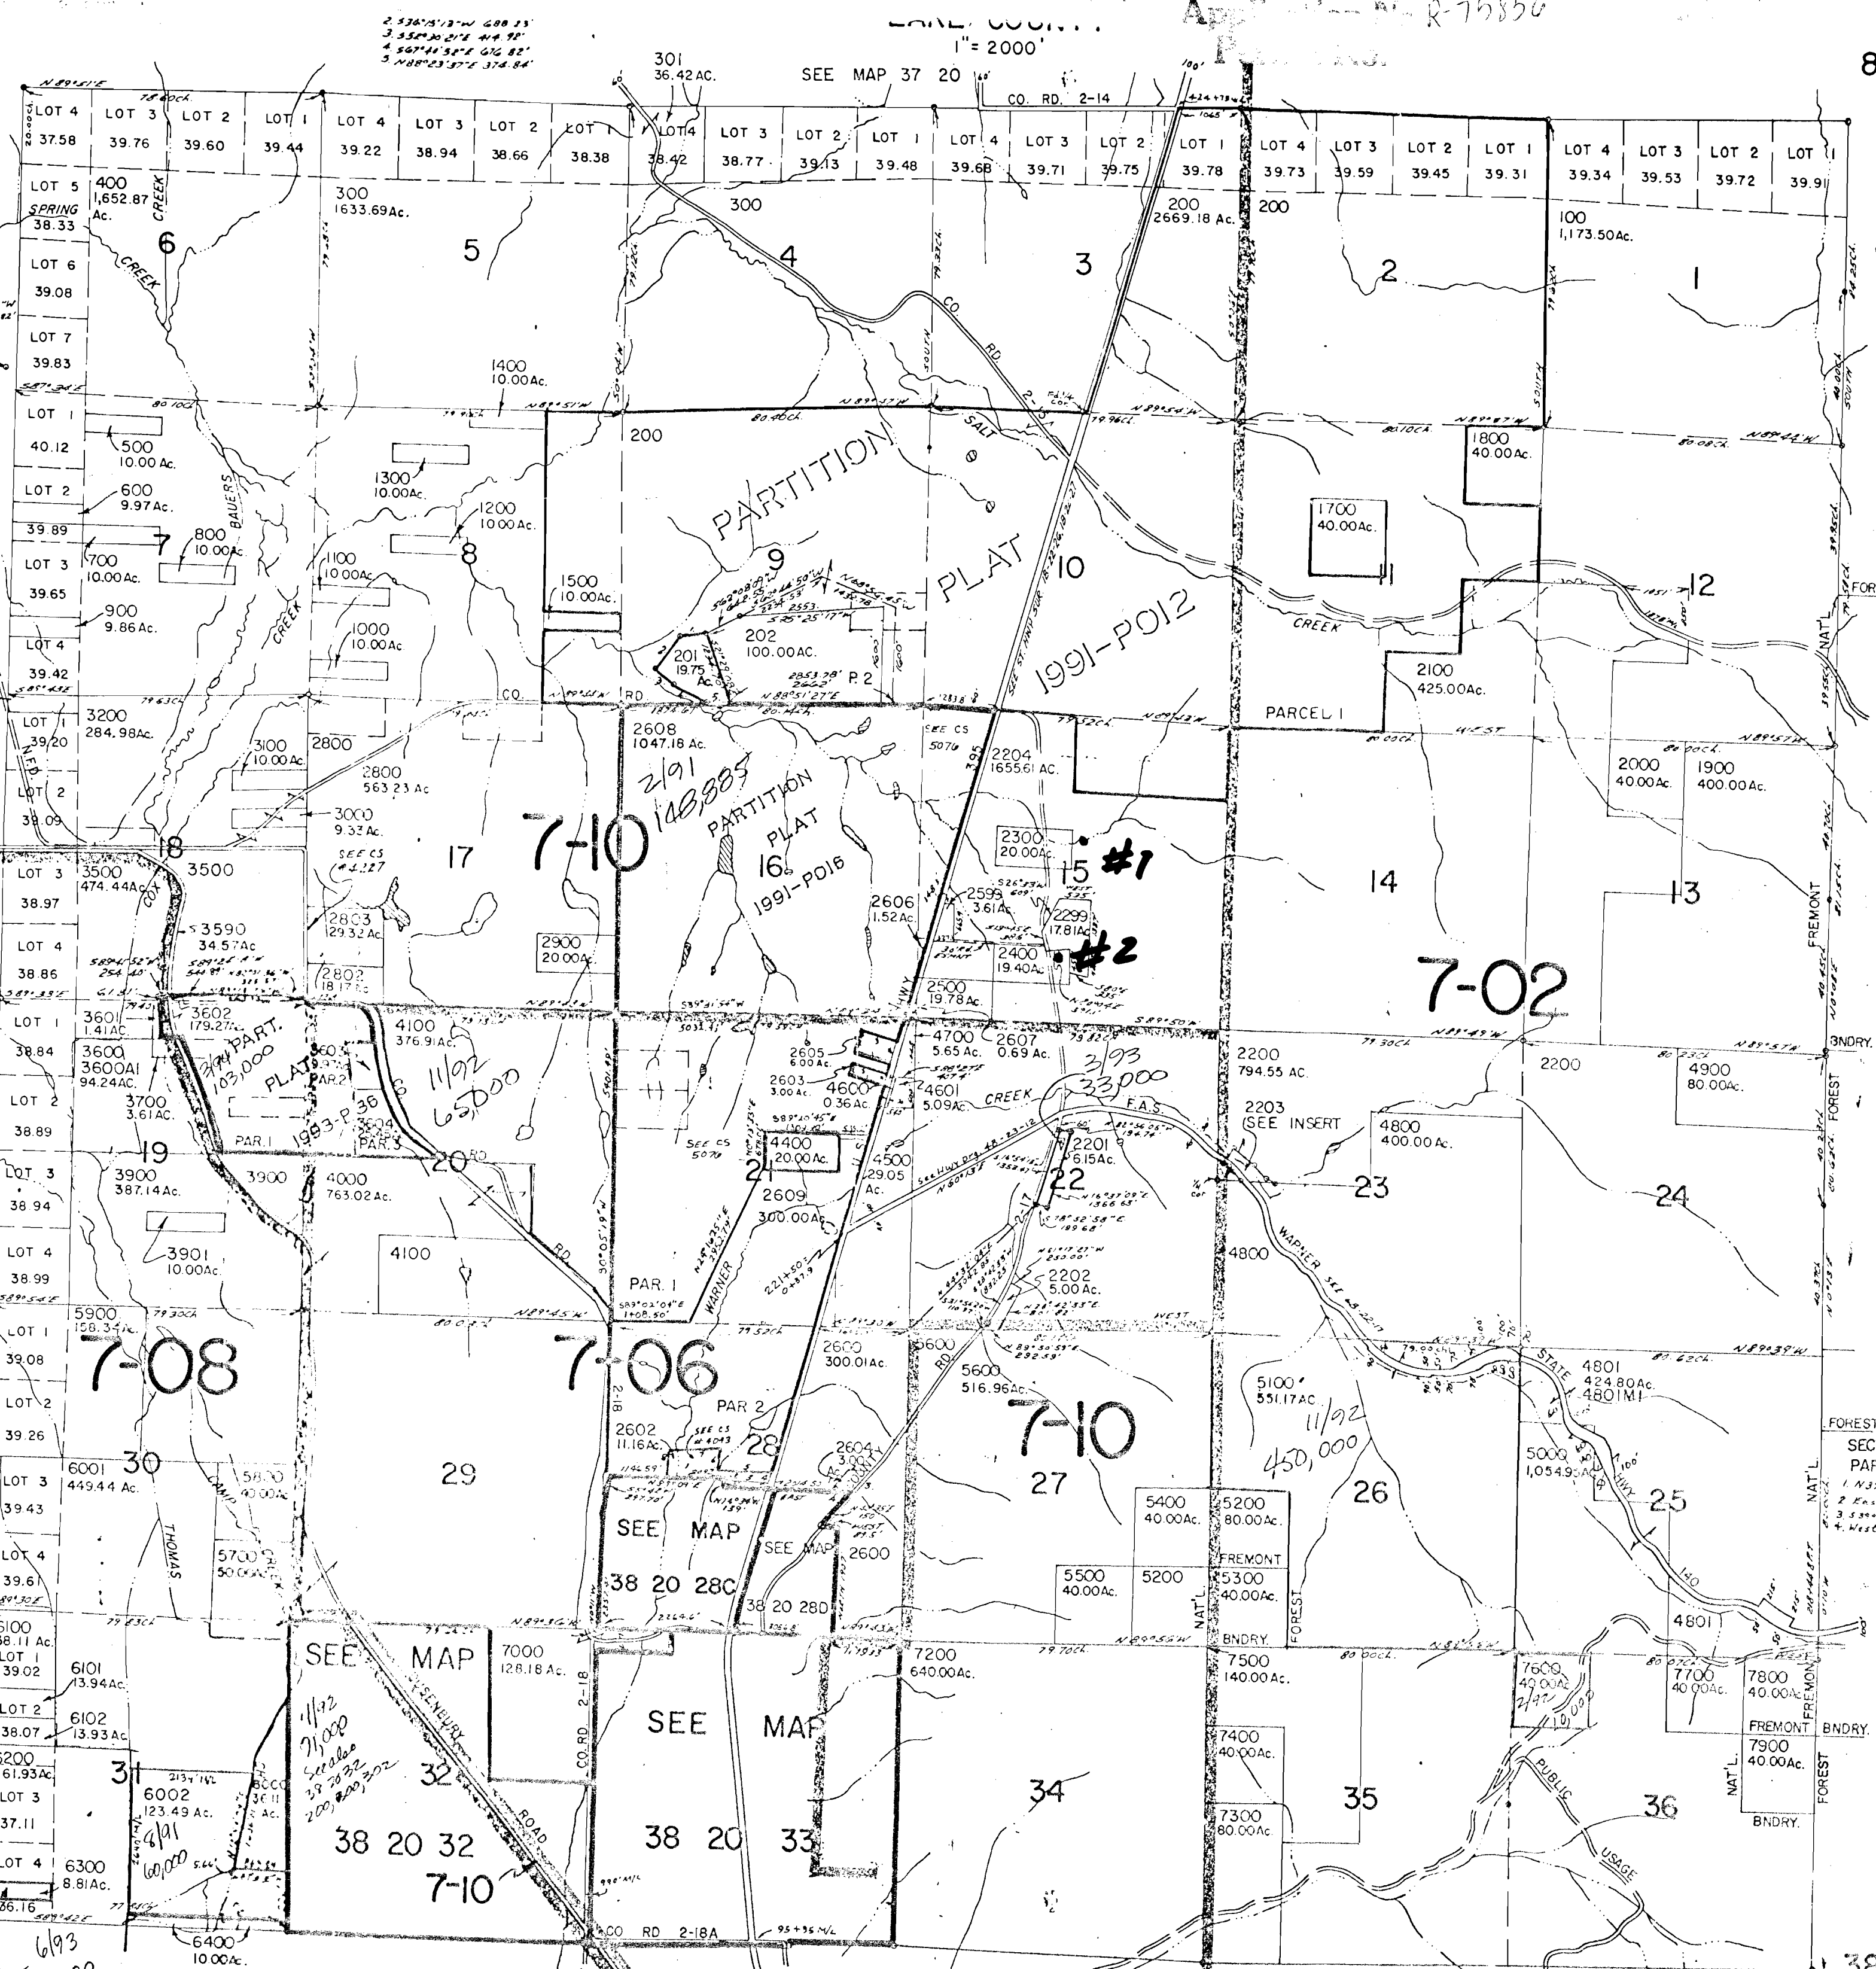

POR. PART. PLAT 1990-PO09
POR. PARCEL 2

SEE MAP 39 20

38 20
& INDEX

SEE MAP 37 20

SEE MAP 38 19

SEE MAP 38 21

- CANCELLED NO.
- 4501
 - 2601
 - 2801
 - 2700
 - 6500
 - 6600
 - 6601
 - 6700
 - 6701
 - 6800
 - 6900
 - 1600
 - 4200
 - 4300
 - 3400
 - 3501
 - 3701
 - 3800
 - 4101

69854

38 20
& INDEX

R-79856

1" = 2000'